SHEET: COW-A1 (05/2005)

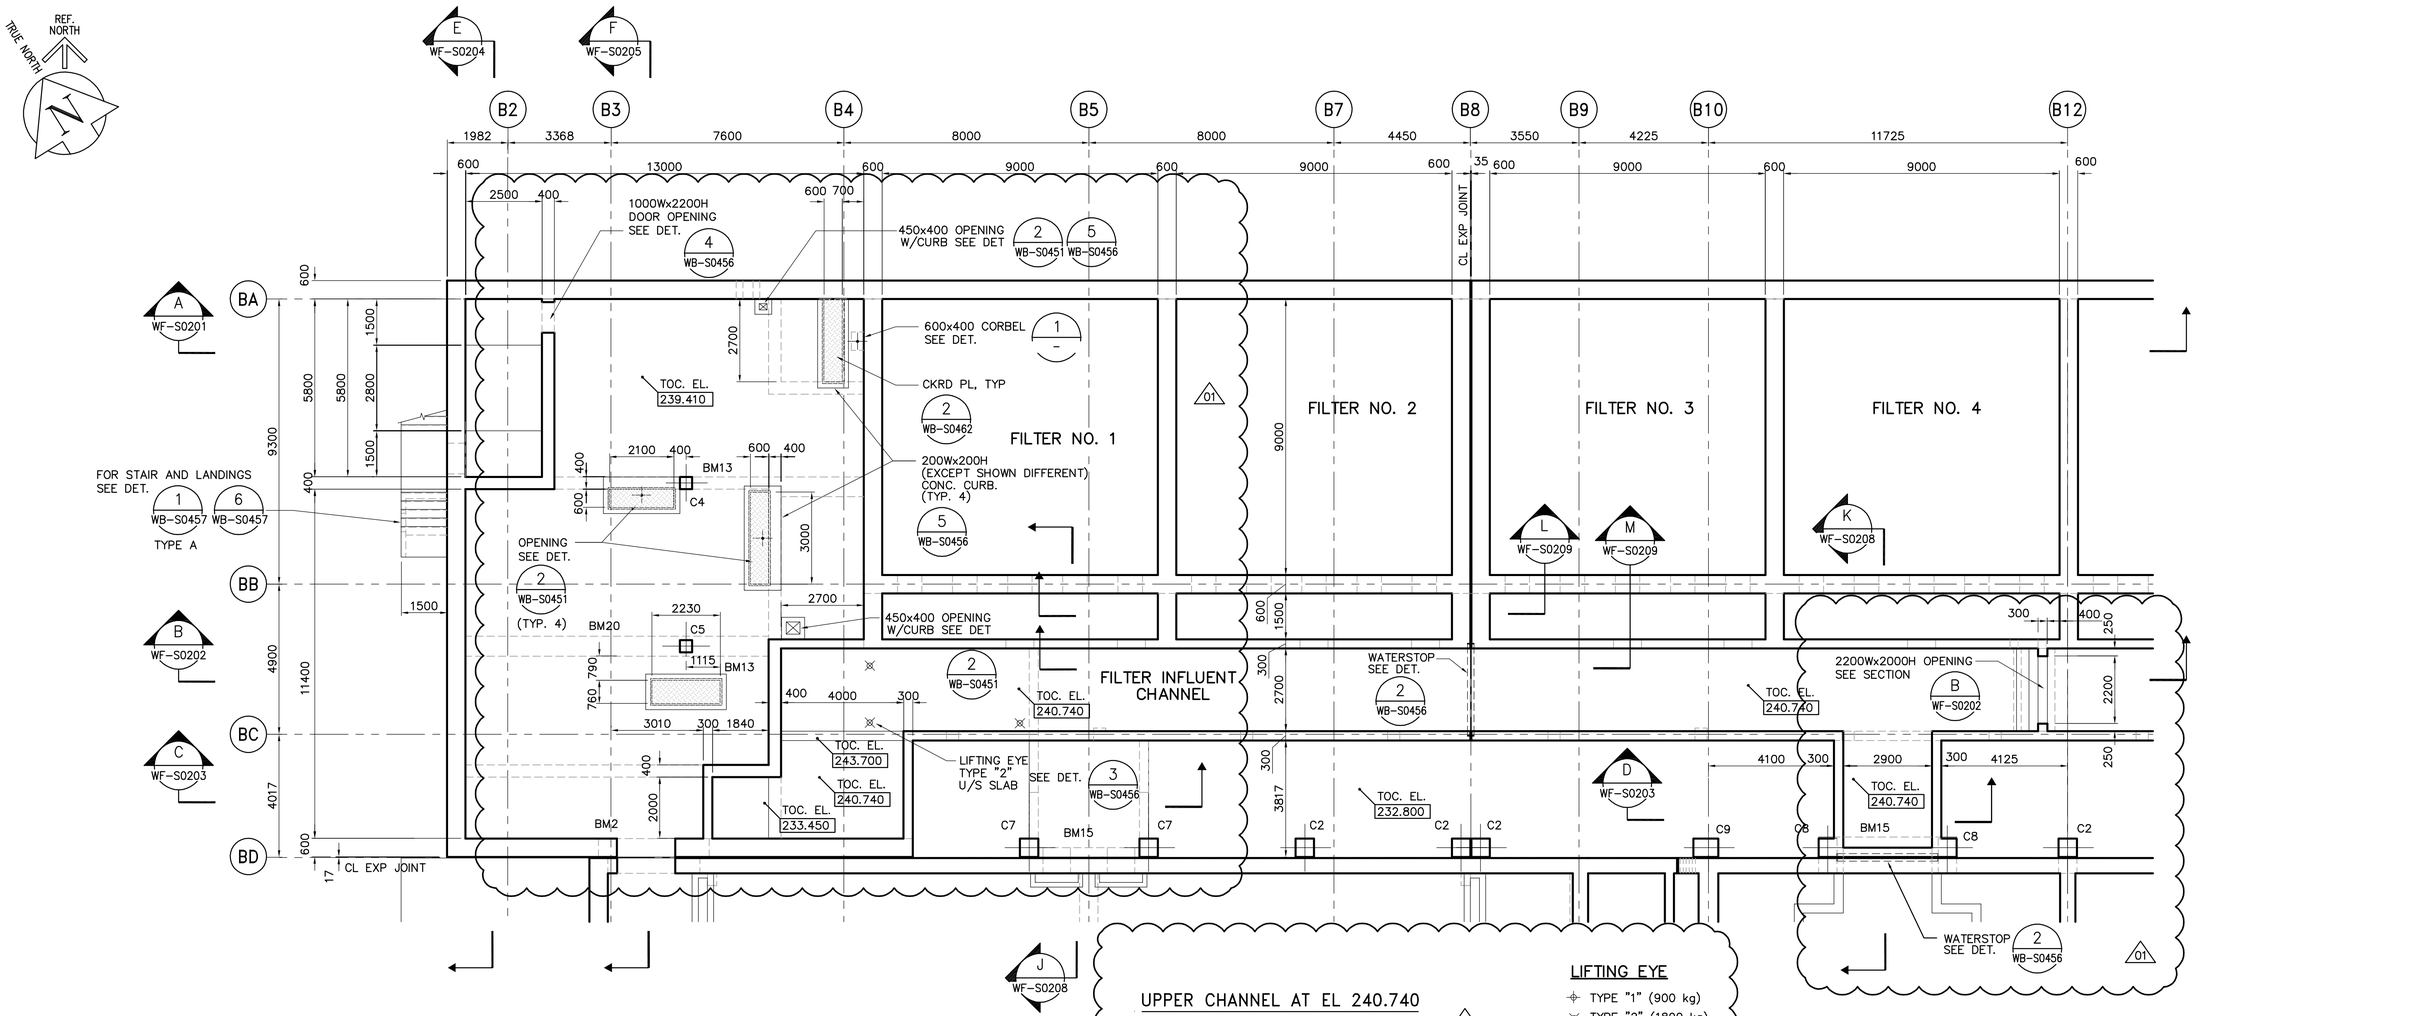

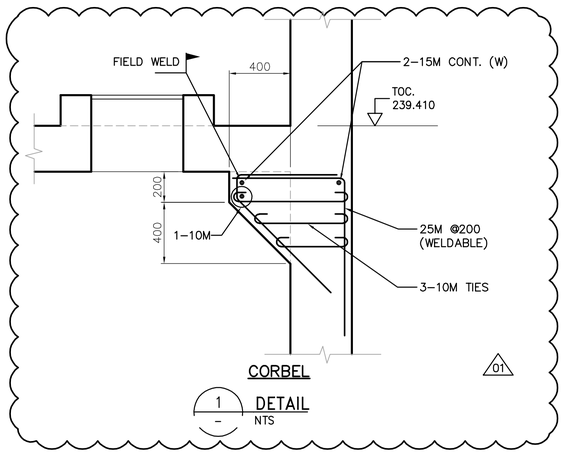

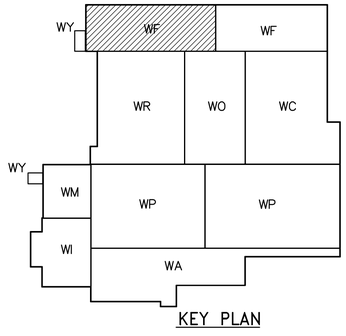

SCALE 1:100 METRES 0 2 4 6 8 10

SCALE 1:1 MILLIMETRES 0 20 40 60 80 100

APEGM
Certificate of Authorization
CH2M HILL Canada Ltd.
No. 1441 Expiry: April 30, 2006

B.M. ELEV.

NO.	REVISIONS	DATE	BY
01	583-2005 ADDENDUM 3	06/03/10	KA
00	ISSUED FOR TENDER	2006/02/03	KA

CH2MHILL
Fredericksen Cooper ARCHITECTS
EarthTech A Tyco International Ltd. Company

DESIGNED BY	KA	CHECKED BY	AP
DRAWN BY	PM	APPROVED BY	DJT
SCALE:	1:100	RELEASED FOR CONSTRUCTION BY:	R. SOROKOWSKI
DATE	2005/08/10	DATE	2006/02/08

ENGINEER'S SEAL
ORIGINAL SIGNED BY
D. KRUGER
2006/02/06

CONSULTANT DRAWING NO.
WF-S0121

Winnipeg
THE CITY OF WINNIPEG
WATER AND WASTE DEPARTMENT
ENGINEERING DIVISION

WATER TREATMENT PLANT
FILTRATION
FOUNDATIONS AND CONCRETE STRUCTURES

CITY FILE NUMBER

SHEET OF

STRUCTURAL
FILTRATION AREA 1
UPPER CHANNEL PLAN

CITY DRAWING NUMBER
1-0601F-A-S0121-001-01D

Last Save: 2006-03-13 5:21 PM

P:\EARTHTECH\321352WINNIPEGWTP\NDM\DESIGN\ACAD\583-POSTTENDER\DN_WF-S0121_CH2M.DWG