




PLAN AT EL 239.410
1:100

- NOTES:**
- DESIGN LIVE LOAD IS 14.4 kPa
 - FOR BEAM AND COLUMN SCHEDULE SEE DWG. WF-S0515

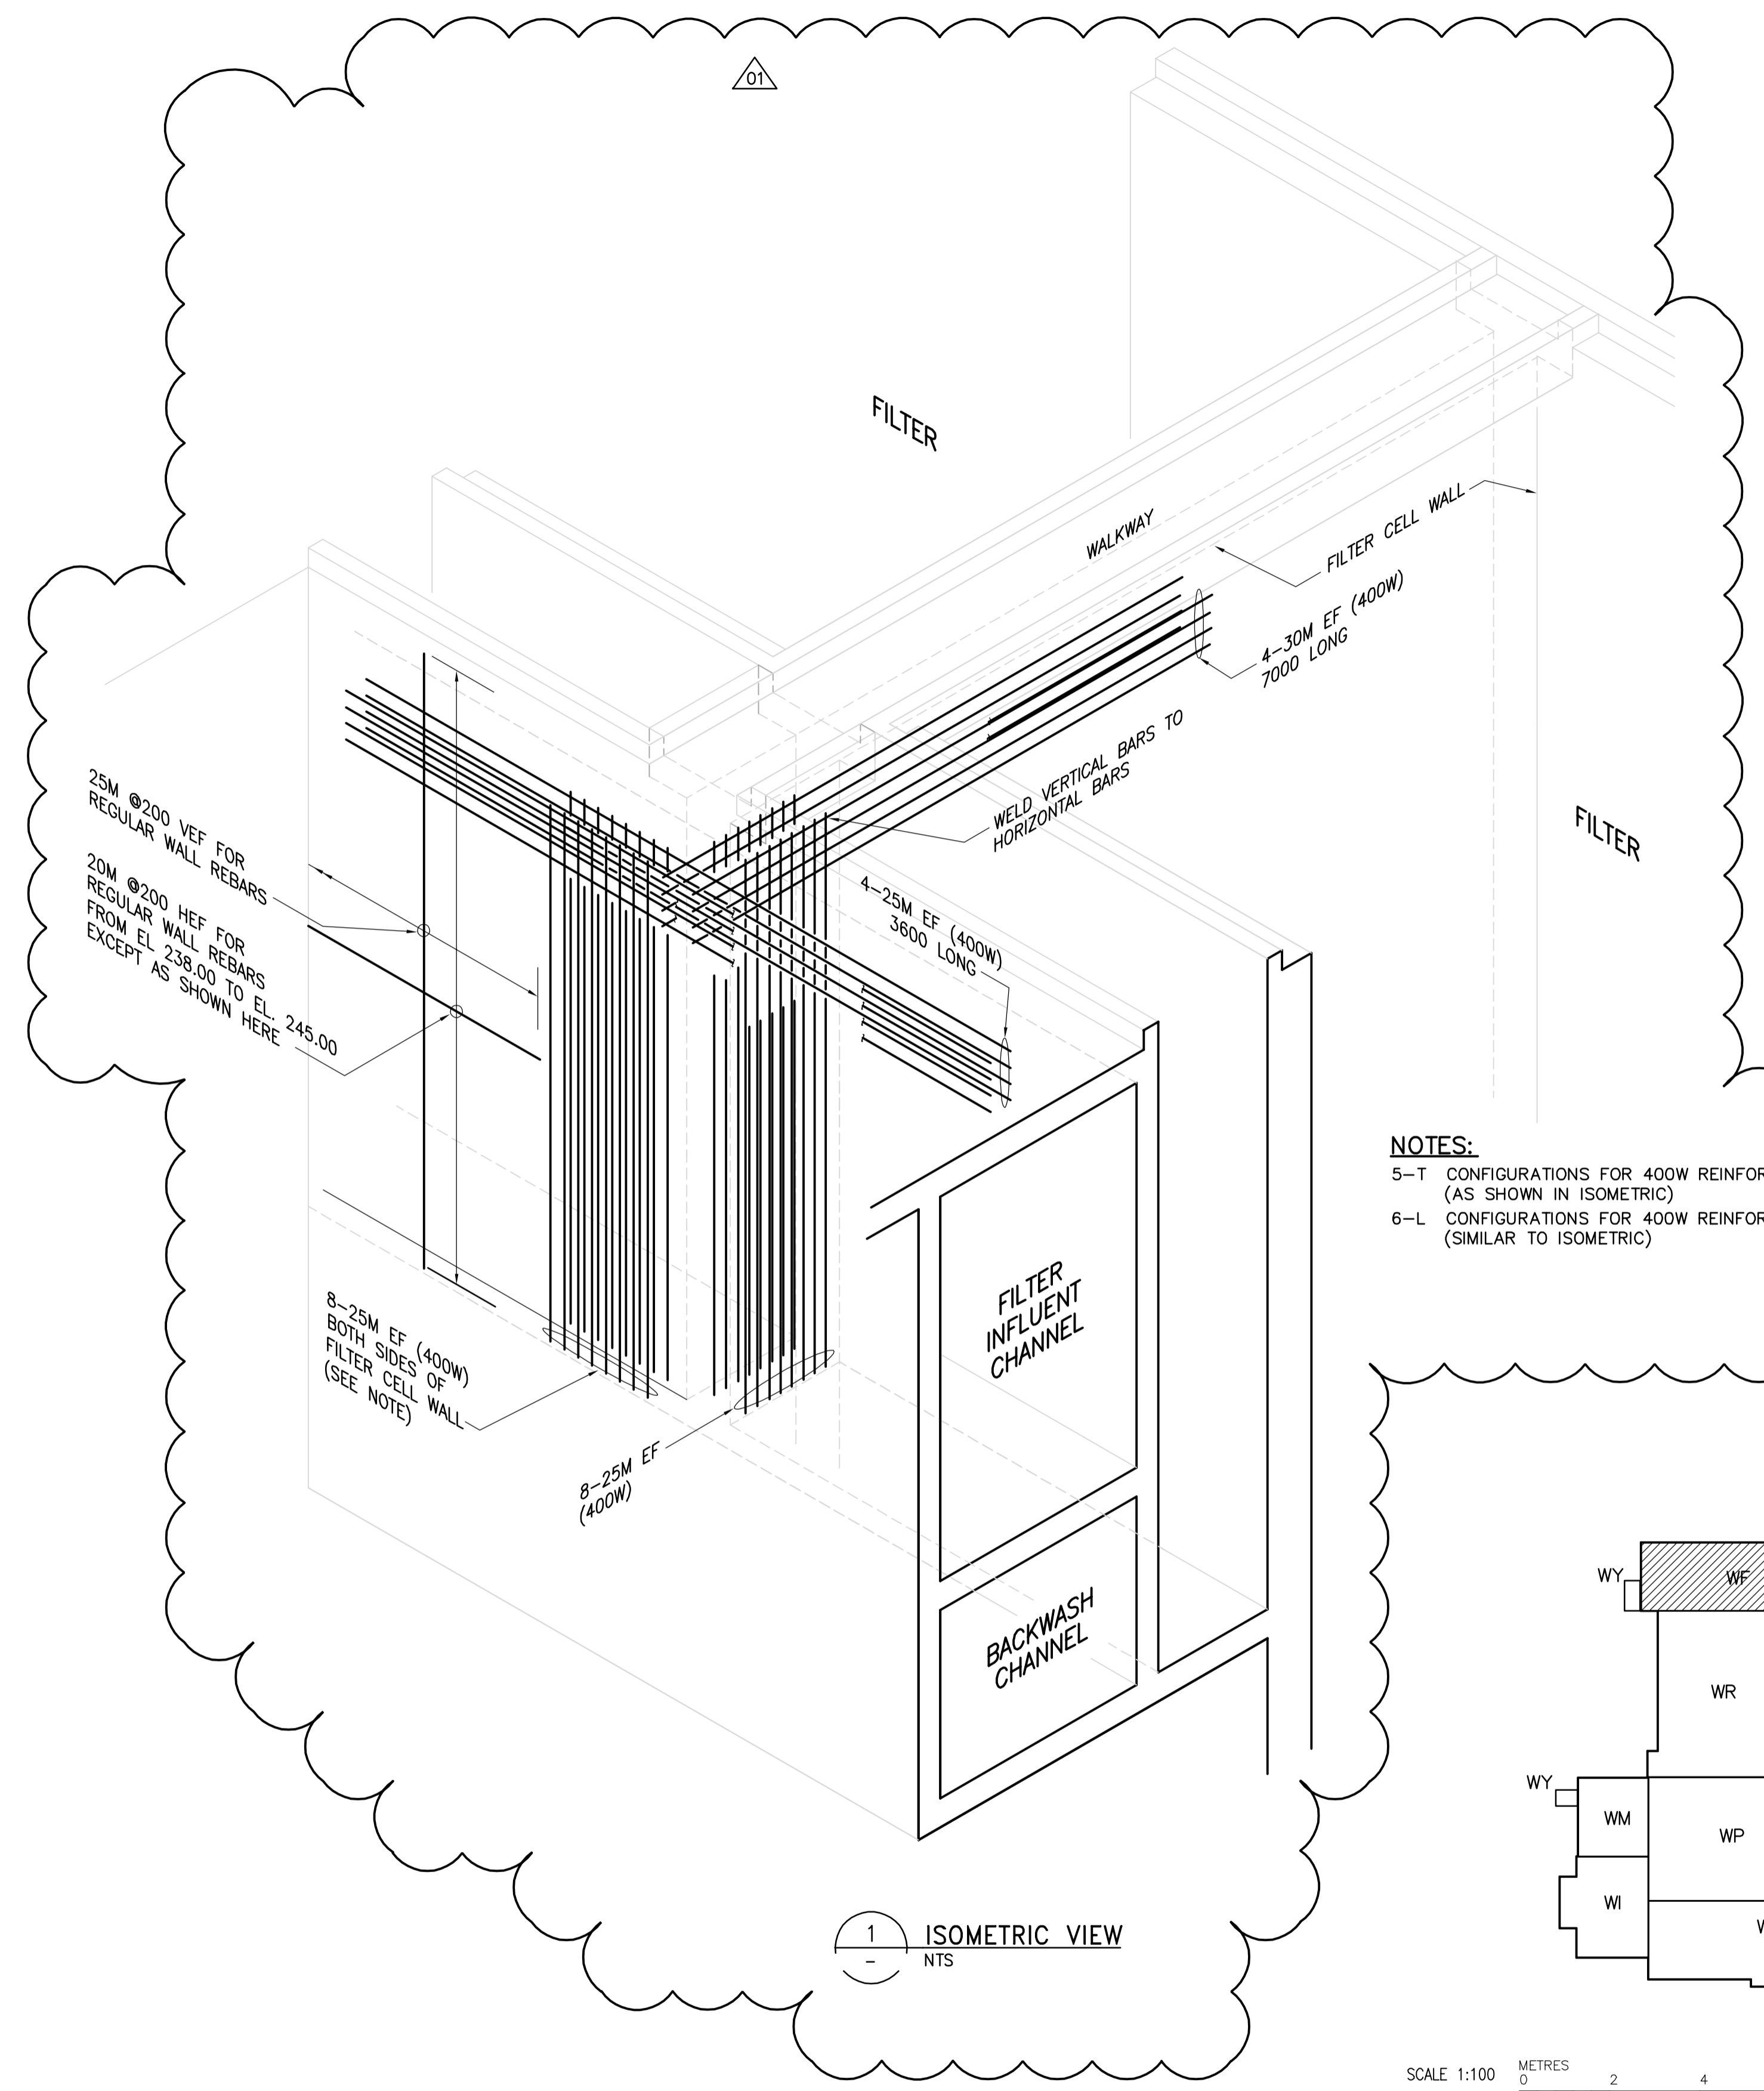

1 ISOMETRIC VIEW
NTS

- NOTES:**
- 5-T CONFIGURATIONS FOR 400W REINFORCEMENT (AS SHOWN IN ISOMETRIC)
 - 6-L CONFIGURATIONS FOR 400W REINFORCEMENT (SIMILAR TO ISOMETRIC)

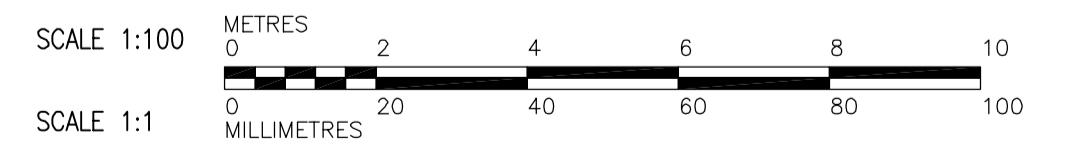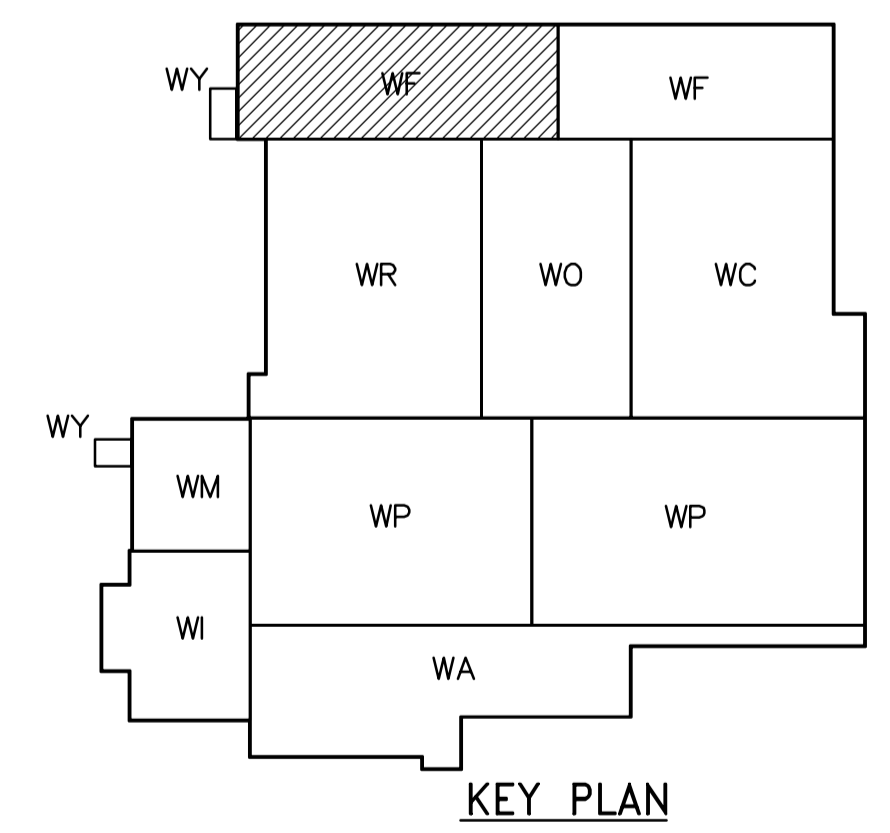

<p>APEGN Certificate of Authorization CH2M HILL Canada Ltd. No. 1441 Expiry: April 30, 2006</p>	<p>Frederickson Cooper ARCHITECTS</p>	<p>EarthTech A Tyco International Ltd. Company</p>	ENGINEER'S SEAL	<p>THE CITY OF WINNIPEG WATER AND WASTE DEPARTMENT ENGINEERING DIVISION</p>																																						
			DESIGNED BY: KA		CHECKED BY: AP	ORIGINAL SIGNED BY: D. KRUGER																																				
			DRAWN BY: PM		APPROVED BY: DJT	2006/02/06																																				
			SCALE: 1:100		RELEASED FOR CONSTRUCTION BY: R. SOROKOWSKI	CONSULTANT DRAWING NO. WF-S0125																																				
<table border="1"> <tr> <th>B.M.</th> <th>ELEV.</th> </tr> <tr><td> </td><td> </td></tr> <tr><td> </td><td> </td></tr> <tr><td> </td><td> </td></tr> <tr><td> </td><td> </td></tr> <tr><td> </td><td> </td></tr> <tr><td> </td><td> </td></tr> <tr><td> </td><td> </td></tr> <tr><td> </td><td> </td></tr> <tr><td> </td><td> </td></tr> <tr><td> </td><td> </td></tr> </table>	B.M.	ELEV.																					<table border="1"> <tr> <th>NO.</th> <th>REVISIONS</th> <th>DATE</th> <th>BY</th> </tr> <tr> <td>01</td> <td>583-2005 ADDENDUM 3</td> <td>06/03/10</td> <td>KA</td> </tr> <tr> <td>00</td> <td>ISSUED FOR TENDER</td> <td>2006/02/03</td> <td>KA</td> </tr> </table>	NO.	REVISIONS	DATE	BY	01	583-2005 ADDENDUM 3	06/03/10	KA	00	ISSUED FOR TENDER	2006/02/03	KA	<table border="1"> <tr> <th>DATE</th> <th>DATE</th> </tr> <tr> <td>2005/08/10</td> <td>2006/02/08</td> </tr> </table>	DATE	DATE	2005/08/10	2006/02/08	<p>STRUCTURAL FILTRATION AREA 1 UPPER CHANNEL REINFORCING PLAN</p>	<p>CITY FILE NUMBER</p> <p>SHEET OF</p> <p>CITY DRAWING NUMBER</p> <p>1-060F-A-50125-001-0D</p>
B.M.	ELEV.	
NO.	REVISIONS	DATE	BY																																							
01	583-2005 ADDENDUM 3	06/03/10	KA																																							
00	ISSUED FOR TENDER	2006/02/03	KA																																							
DATE	DATE	
2005/08/10	2006/02/08	