
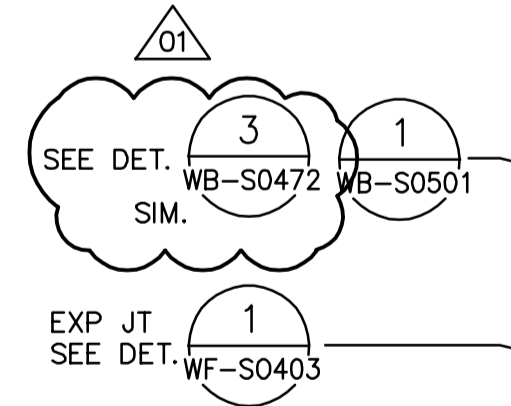


1 DETAIL
1:20

H SECTION
WF-S0102 1:50

- WF-S0106
- WF-S0112
- WF-S0116
- WF-S0118
- WF-S0122
- WF-S0125
- WF-S0132
- WF-S0136
- WF-S0142
- WF-S0147

NOTES:
1. SEE PLANS FOR SLAB REINFORCEMENT.

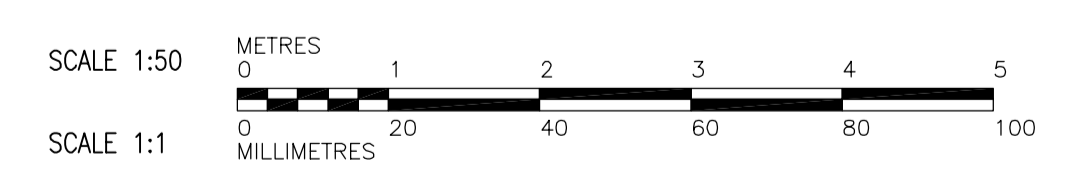

3 SEE DET. WB-S0472
1 SEE DET. WB-S0501
1 EXP JT SEE DET. WF-S0403



NO.	REVISIONS	DATE	BY
01	583-2005 ADDENDUM 3	06/03/10	KA
00	ISSUED FOR TENDER	2006/02/03	KA

DESIGNED BY	KA	CHECKED BY	AP
DRAWN BY	PM	APPROVED BY	DJT
SCALE:	1:50	RELEASED FOR CONSTRUCTION BY:	R. SOROKOWSKI
DATE	2005/08/10	DATE	2006/02/08

ENGINEER'S SEAL
 ORIGINAL SIGNED BY
 D. KRUGER
 2006/02/06
 CONSULTANT DRAWING NO.
 WF-S0207

THE CITY OF WINNIPEG
 WATER AND WASTE DEPARTMENT
 ENGINEERING DIVISION

WATER TREATMENT PLANT
 FILTRATION
 FOUNDATIONS AND CONCRETE STRUCTURES

STRUCTURAL
 FILTRATION AREA
 SECTION

CITY FILE NUMBER
 SHEET OF
 CITY DRAWING NUMBER
1-060F-A-50207-001-0D