




R SECTION - SUPERNATANT AND SLUDGE LINES
WP-M9106 1:50

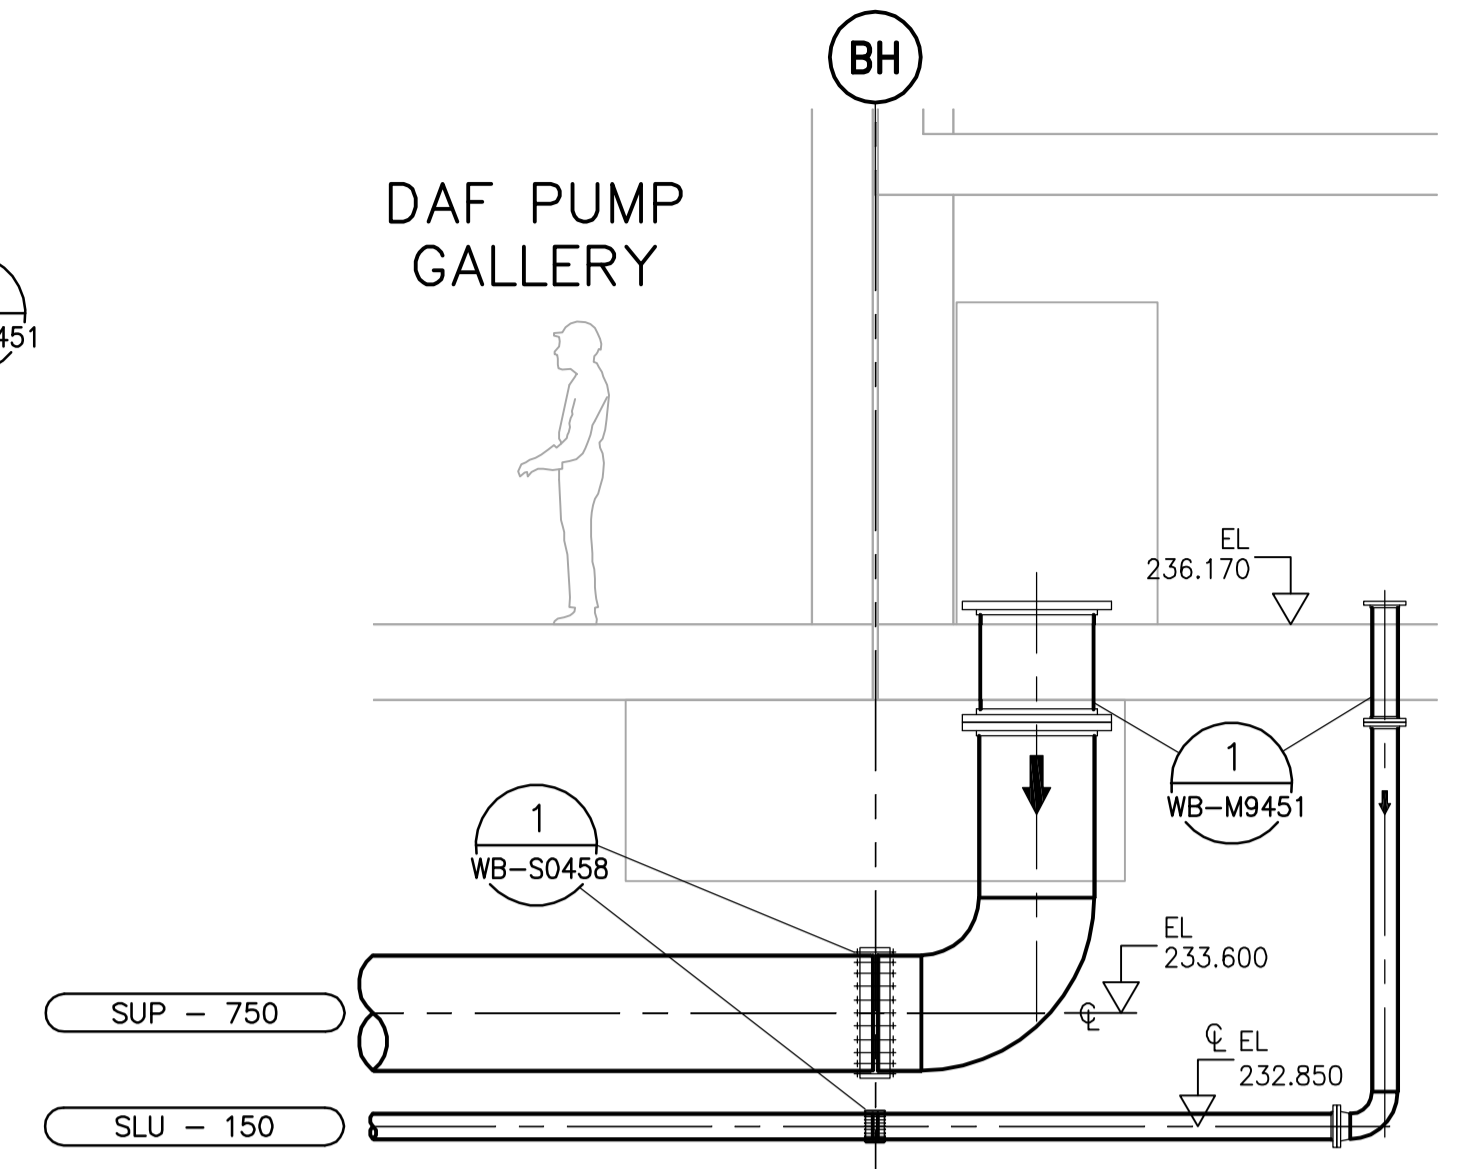


S SECTION - SUPERNATANT AND SLUDGE LINES
WP-M9106 1:50

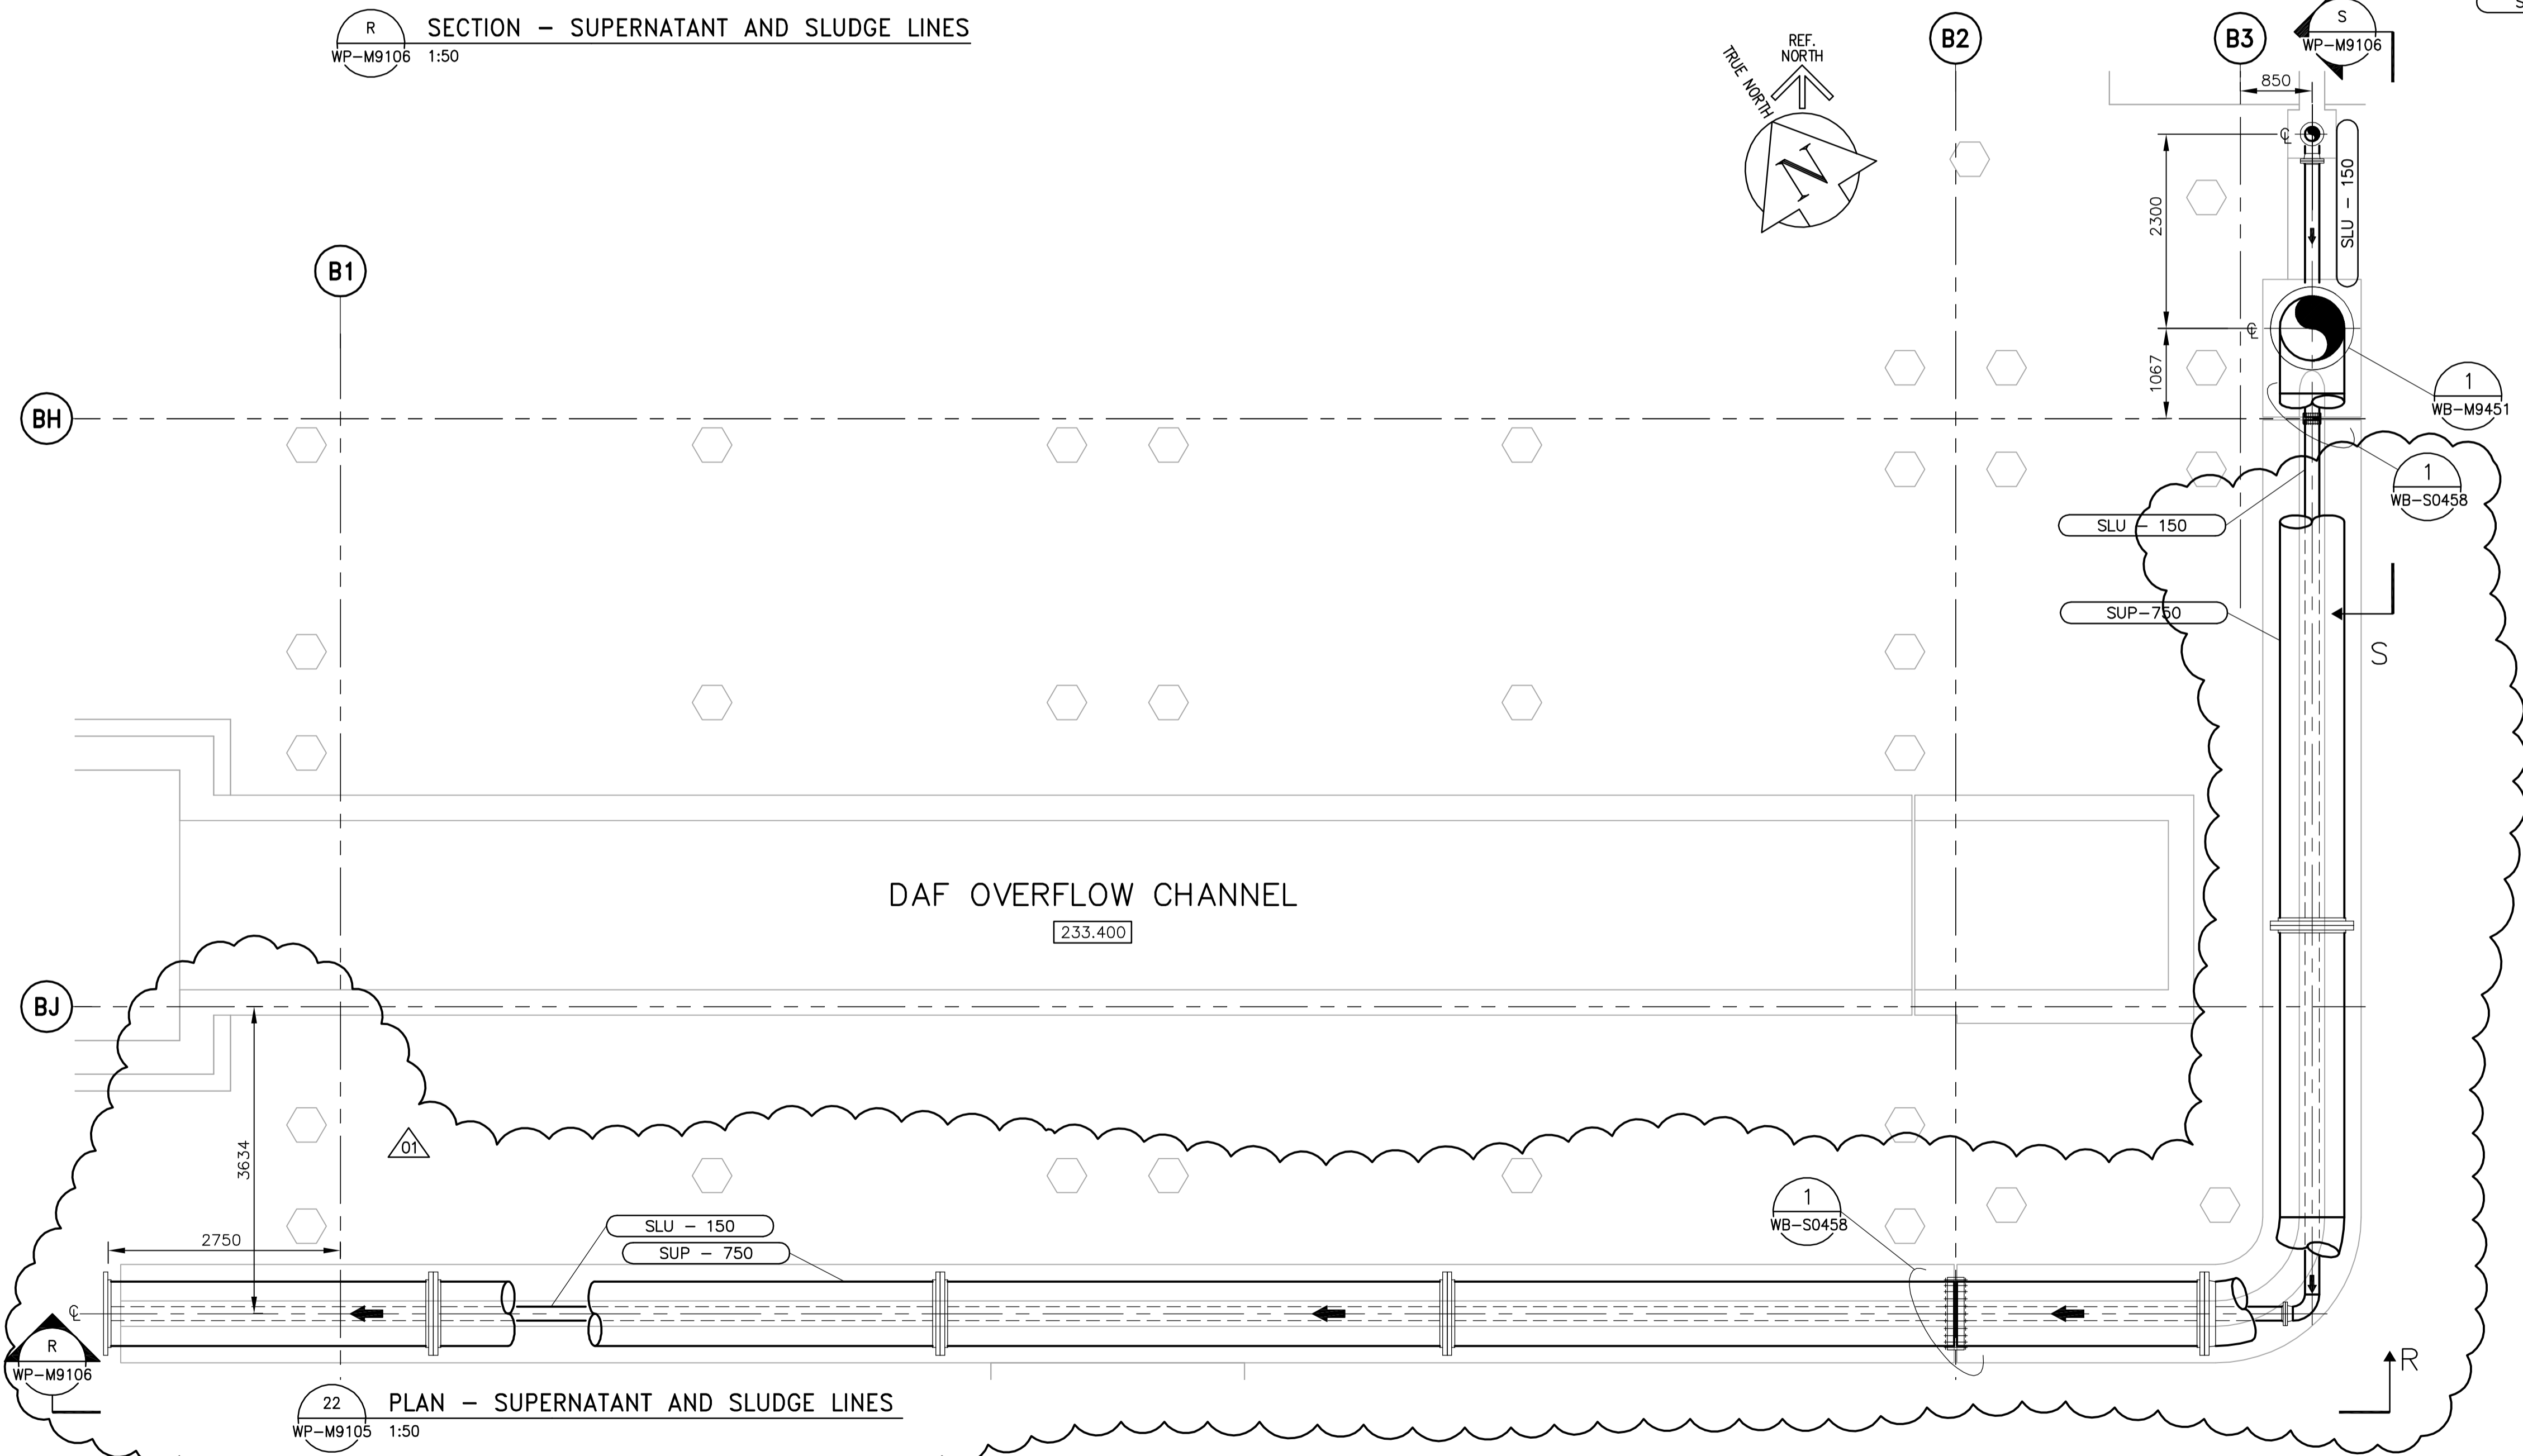

22 PLAN - SUPERNATANT AND SLUDGE LINES
WP-M9105 1:50

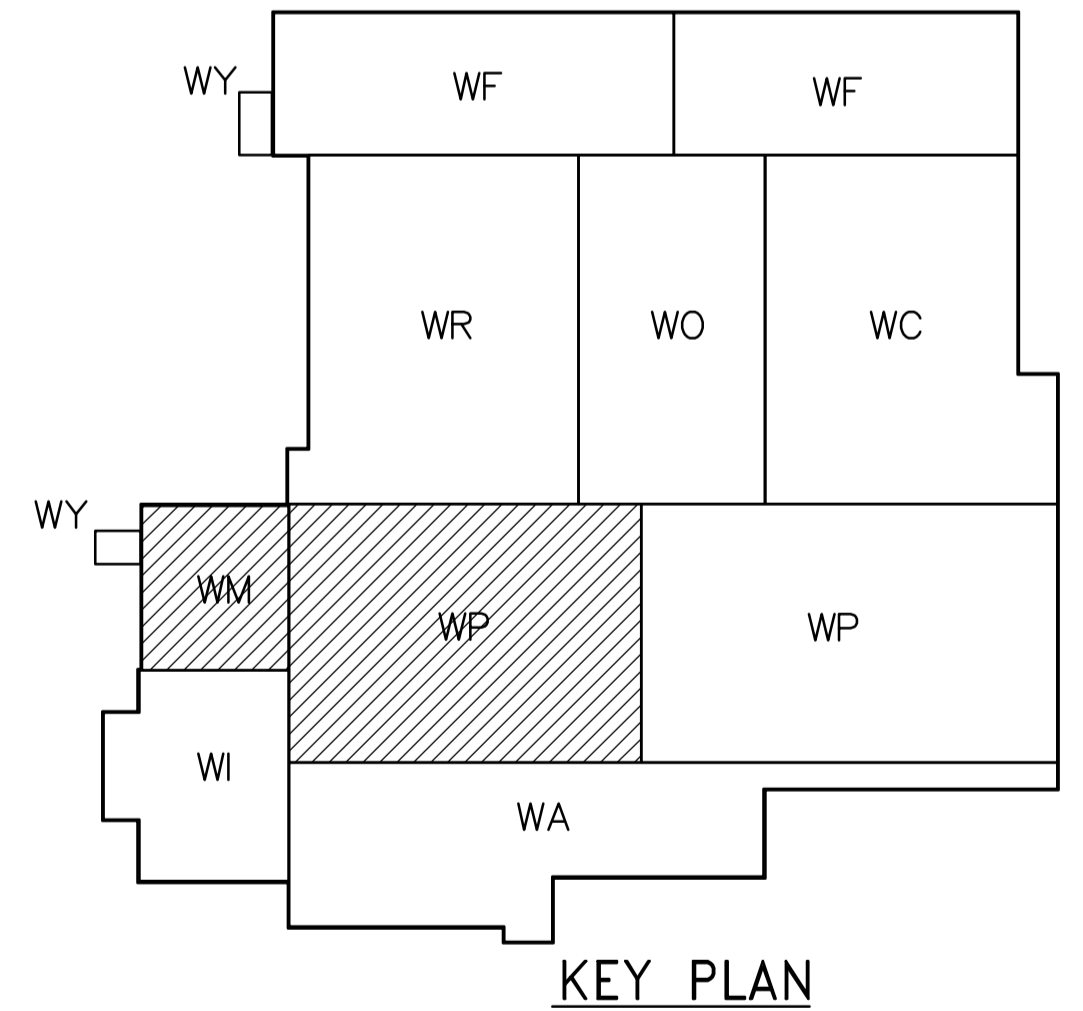

KEY PLAN

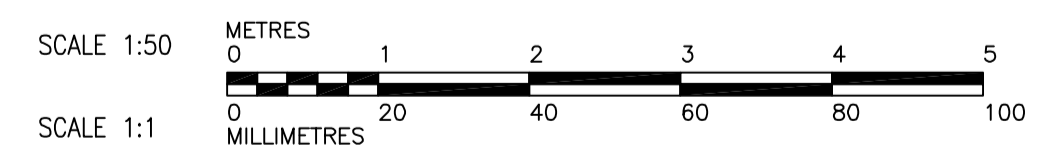

<p>Certificate of Authorization Earth Tech Canada Inc. No. 730 Expiry: April 30, 2006</p>	<table border="1"> <tr> <th>B.M.</th> <th>ELEV.</th> <th>DATE</th> <th>BY</th> </tr> <tr> <td> </td> <td> </td> <td> </td> <td> </td> </tr> </table>	B.M.	ELEV.	DATE	BY													<p>Frederickson Cooper ARCHITECTS</p>	<p>A Tech International Ltd. Company</p>	<p>ENGINEER'S SEAL</p> <p>ORIGINAL SIGNED BY S.R. BILEVICIUS 2006/02/07</p>	<p>THE CITY OF WINNIPEG WATER AND WASTE DEPARTMENT ENGINEERING DIVISION</p>						
		B.M.	ELEV.	DATE	BY																						
<table border="1"> <tr> <td>DESIGNED BY</td> <td>KAS</td> <td>CHECKED BY</td> <td>SRB</td> </tr> <tr> <td>DRAWN BY</td> <td>PL</td> <td>APPROVED BY</td> <td>DJT</td> </tr> <tr> <td>SCALE:</td> <td>AS SHOWN</td> <td>RELEASED FOR CONSTRUCTION BY:</td> <td>R. SOROKOWSKI</td> </tr> <tr> <td>NO.</td> <td>REVISIONS</td> <td>DATE</td> <td>DATE</td> </tr> <tr> <td>01</td> <td>583-2005 ADDENDUM 3</td> <td>06/03/10</td> <td>JBC</td> </tr> <tr> <td>00</td> <td>ISSUED FOR TENDER</td> <td>06/02/03</td> <td>PL</td> </tr> </table>	DESIGNED BY	KAS	CHECKED BY	SRB	DRAWN BY	PL	APPROVED BY	DJT	SCALE:	AS SHOWN	RELEASED FOR CONSTRUCTION BY:	R. SOROKOWSKI	NO.	REVISIONS	DATE	DATE	01	583-2005 ADDENDUM 3	06/03/10	JBC	00	ISSUED FOR TENDER	06/02/03	PL	<p>CONSULTANT DRAWING NO. WP-M9106</p>	<p>WATER TREATMENT PLANT FLOCCULATION AND DAF FOUNDATIONS AND CONCRETE STRUCTURES</p> <p>PIPE EMBEDS PLAN AND SECTIONS SUPERNATANT AND SLUDGE LINES</p>	<p>CITY FILE NUMBER</p> <p>SHEET OF</p> <p>CITY DRAWING NUMBER 1-0601P-A-M9106-001-01D</p>
DESIGNED BY	KAS	CHECKED BY	SRB																								
DRAWN BY	PL	APPROVED BY	DJT																								
SCALE:	AS SHOWN	RELEASED FOR CONSTRUCTION BY:	R. SOROKOWSKI																								
NO.	REVISIONS	DATE	DATE																								
01	583-2005 ADDENDUM 3	06/03/10	JBC																								
00	ISSUED FOR TENDER	06/02/03	PL																								