


- NOTES:**
1. SEE PLANS FOR SLAB REINFORCEMENT.
 2. DRAINAGE AND FILL DETAILS SHOWN HERE APPLY ALL AROUND THE RAW WATER PUMPING STATION.

D SECTION
WI-S0101 1:50

WI-F0105, WI-S0111,
WI-S0131, WI-S0141

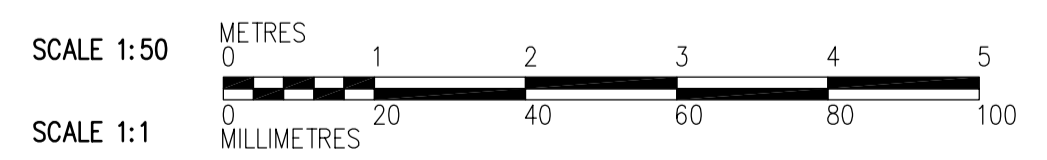

<p>Certificate of Authorization CH2M Hill Canada Limited (ON) No. 1441 Expiry: April 30, 2006</p>	<p>Frederickson Cooper ARCHITECTS</p>	<p>A Tyco International Ltd. Company</p>	ENGINEER'S SEAL 	<p>THE CITY OF WINNIPEG WATER AND WASTE DEPARTMENT ENGINEERING DIVISION</p> <p>WATER TREATMENT PLANT</p> <p>FOUNDATIONS AND CONCRETE STRUCTURES 1</p> <p>STRUCTURAL RAW WATER PUMP STATION AREA SECTION</p>	CITY FILE NUMBER SHEET OF CITY DRAWING NUMBER 1-0601-A-80204-001-0D
	DESIGNED BY: EL CHECKED BY: AP	DRAWN BY: RL APPROVED BY:	CONSULTANT DRAWING NO. WI-S0204		
	SCALE: 1:50 RELEASED FOR CONSTRUCTION BY:	DATE: 2005/08/02 DATE:			
	NO. REVISIONS DATE BY	01 650-2005 ADDENDUM 2 05/11/16 EL 00 ISSUED FOR TENDER 05/10/28 EL			