SHEET: COW-A1 (05/2005)

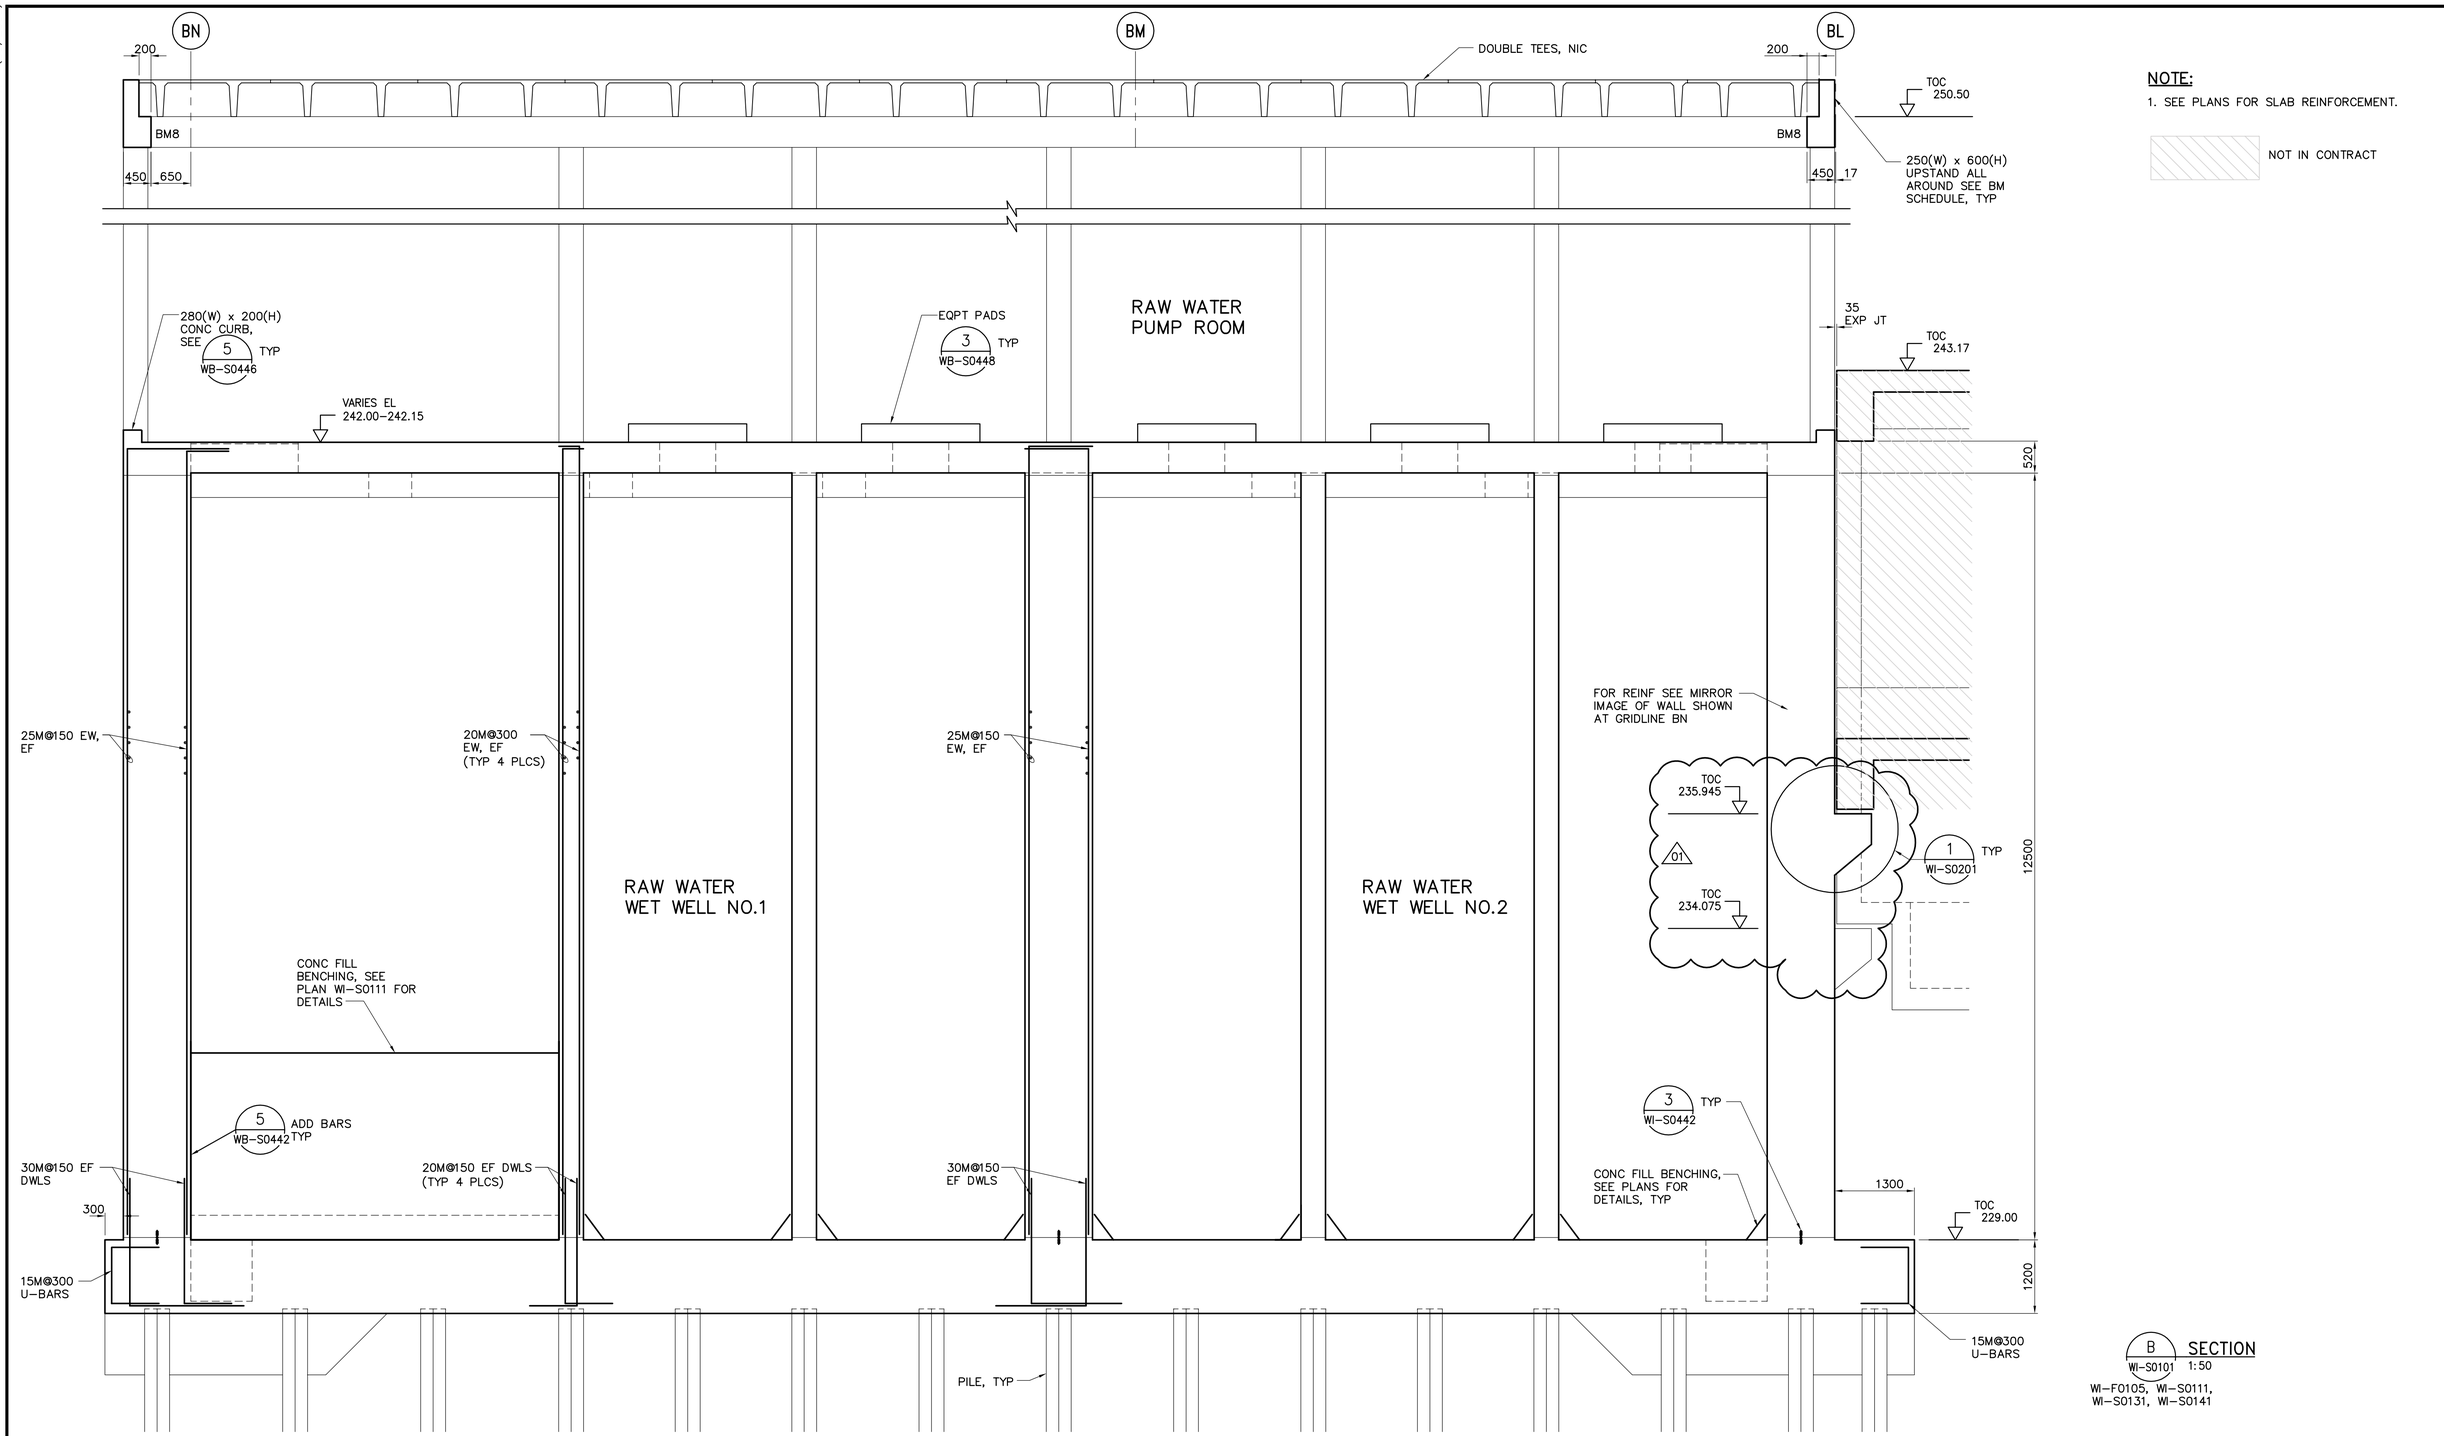

B SECTION
WI-S0101 1:50

WI-F0105, WI-S0111,
WI-S0131, WI-S0141

NOTE:

1. SEE PLANS FOR SLAB REINFORCEMENT.

NOT IN CONTRACT

SCALE 1:50

SCALE 1:1

METRES 0 1 2 3 4 5

MILLIMETRES 0 20 40 60 80 100

APEGM
Certificate of Authorization
CH2M Hill Canada Limited (ON)
No. 1441 Expiry: April 30, 2006

B.M.
ELEV.

NO.	REVISIONS	DATE	BY
01	650-2005 ADDENDUM 3	05/11/24	EL
00	ISSUED FOR TENDER	05/10/28	EL

CH2MHILL
Fredericksson Cooper ARCHITECTS
EarthTech A Tyco International Ltd. Company

DESIGNED BY	EL	CHECKED BY	AP
DRAWN BY	RL	APPROVED BY	AHL
SCALE:	1:50	RELEASED FOR CONSTRUCTION BY:	R. SOROKOWSKI
DATE	2005/08/02	DATE	2005/10/28

ENGINEER'S SEAL
ORIGINAL SIGNED BY
D. KRUGER
2005/10/28

CONSULTANT DRAWING NO.
WI-S0202

Winnipeg
THE CITY OF WINNIPEG
WATER AND WASTE DEPARTMENT
ENGINEERING DIVISION

WATER TREATMENT PLANT
FOUNDATIONS AND CONCRETE STRUCTURES 1
STRUCTURAL
RAW WATER PUMP STATION AREA
SECTION

CITY FILE NUMBER
SHEET OF
CITY DRAWING NUMBER
1-0601-A-S0202-001-01D

Last Save: 2005-11-24 2:11 PM

C:\DOCUMENTS AND SETTINGS\SEVERITT\MY DOCUMENTS\NDMPROJ\321352 - WINNIPEGWTP\DN_WI-S0202_CH2M-R01.DWG