


SHEET: 06-11-WW (17/0202)

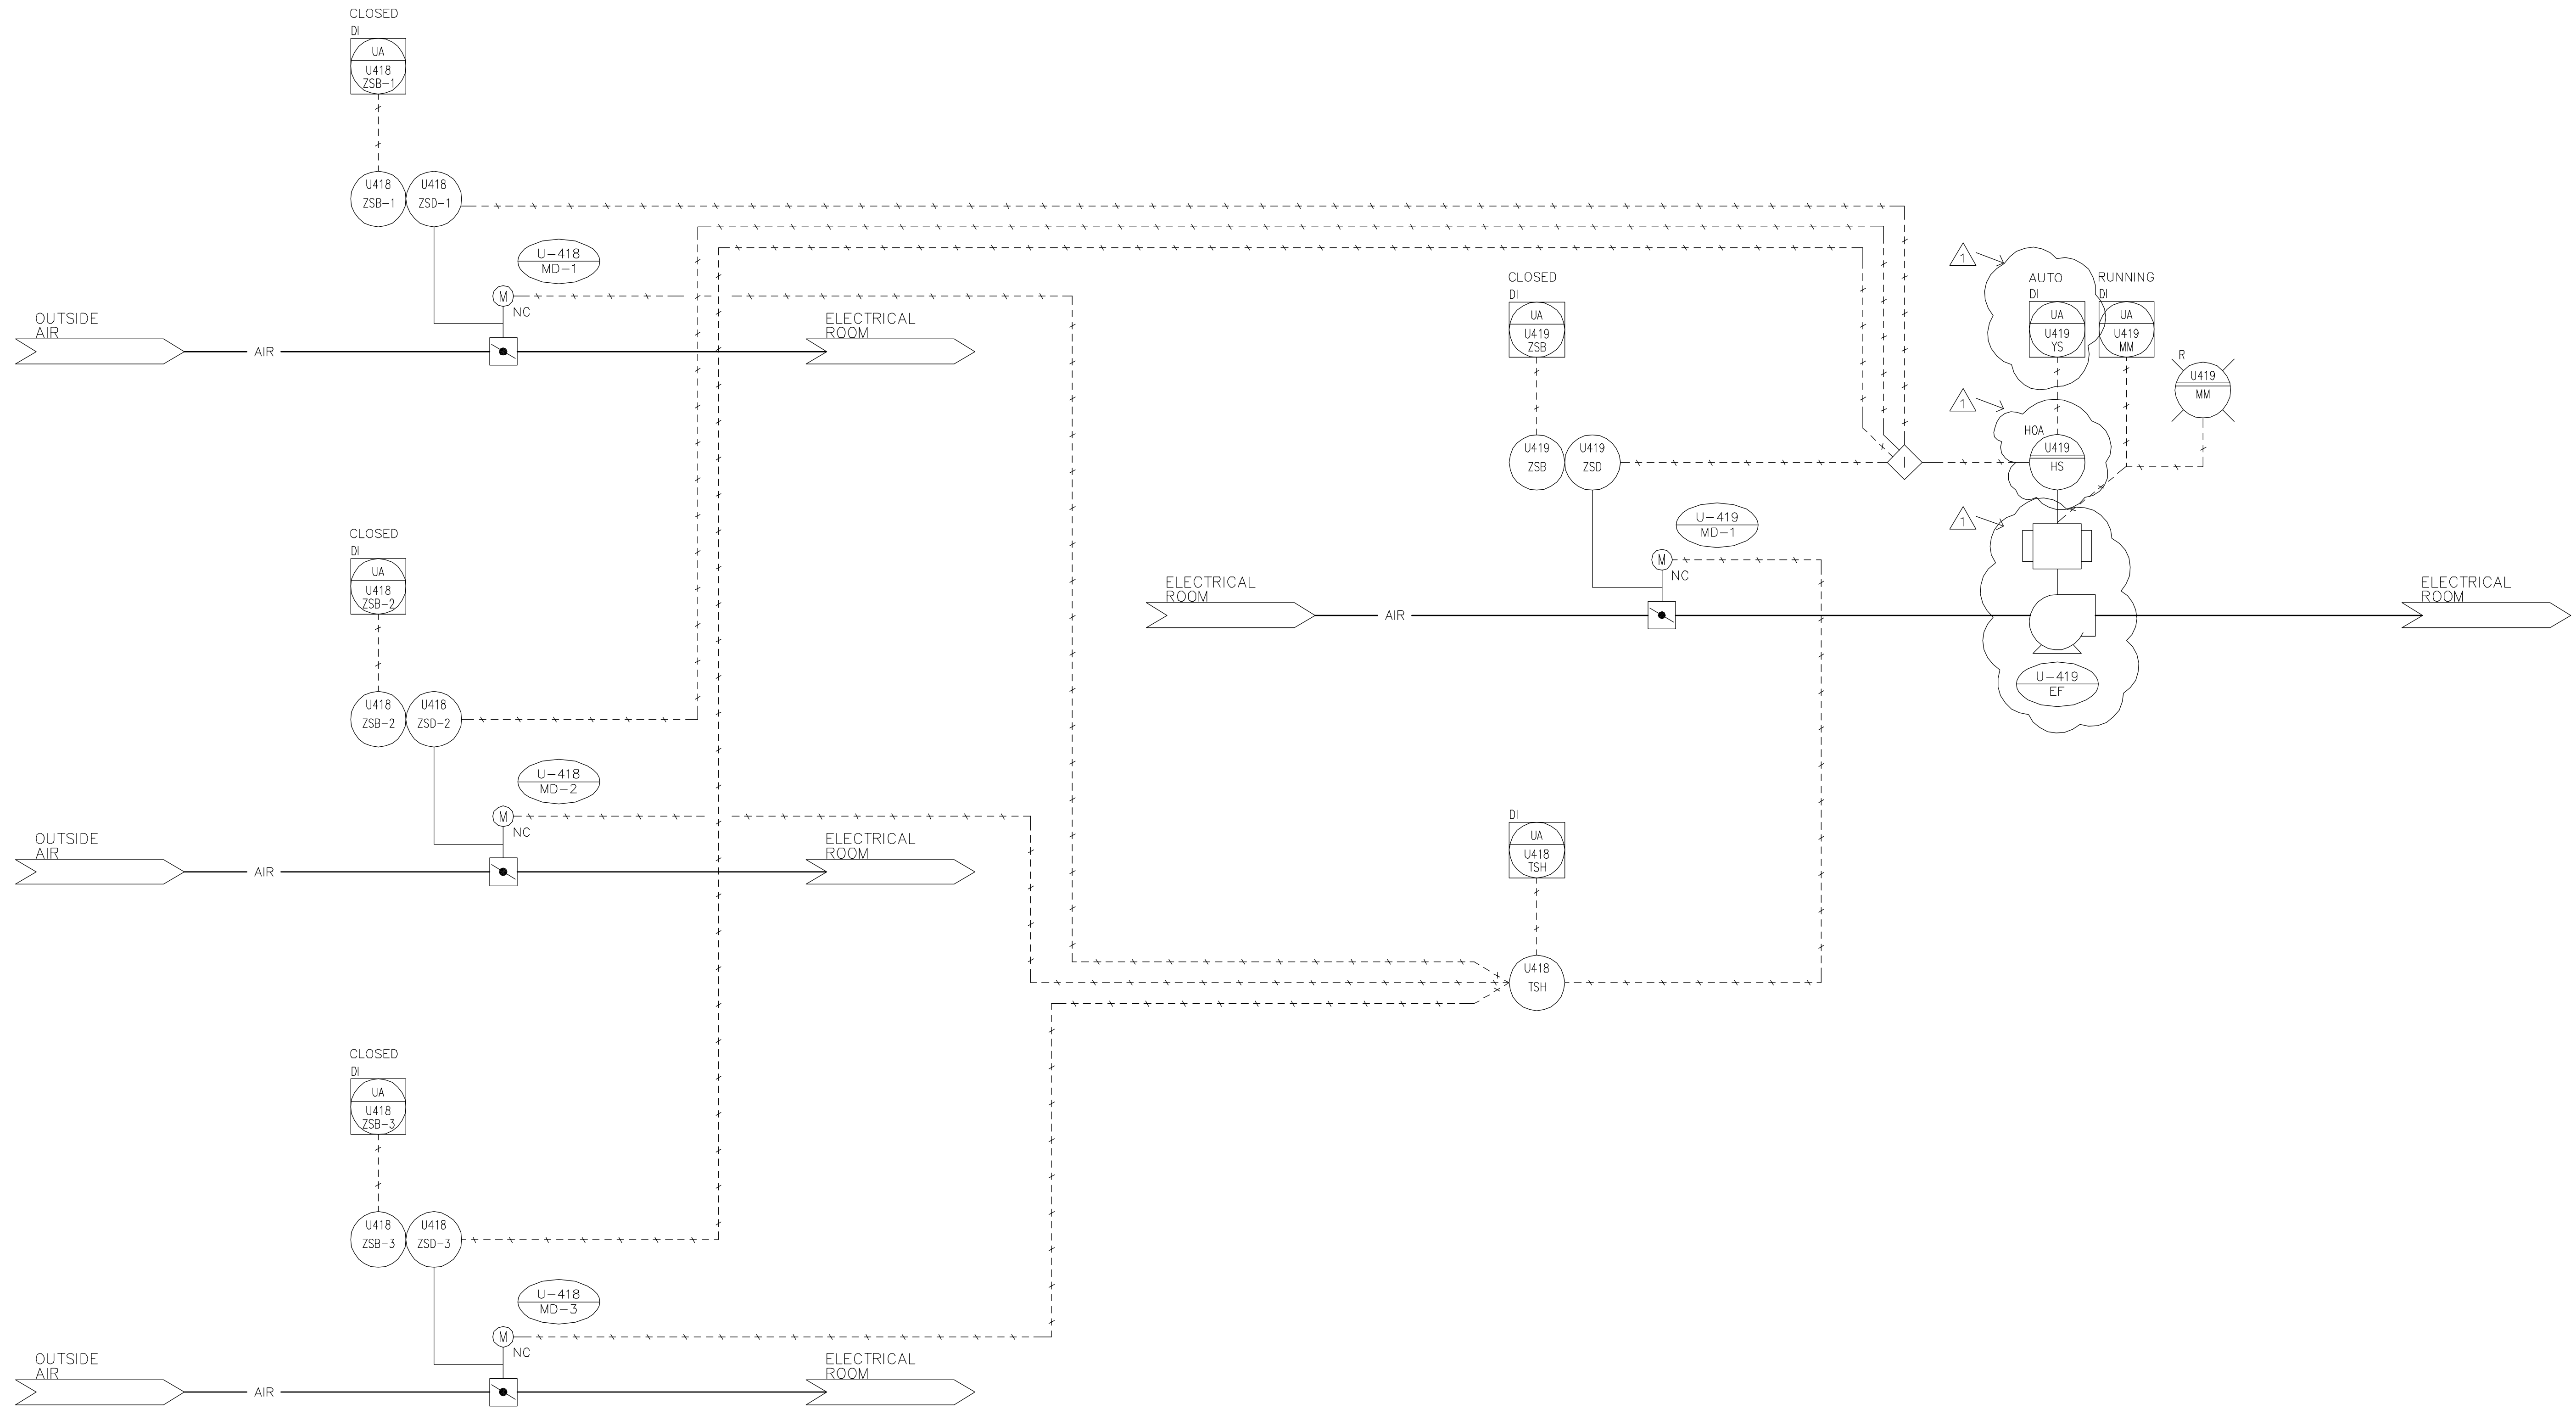

B.M. ELEV.	<b>EARTH TECH</b>		ENGINEER'S SEAL ORIGINAL SIGNED BY P.V. LAITINEN FEB. 18/05	<b>THE CITY OF WINNIPEG</b> Winnipeg WATER AND WASTE DEPARTMENT	
	DESIGNED BY: BLM	CHECKED BY: DT		<b>NEWPCC - SECONDARY EFFLUENT</b> UV DISINFECTION FACILITY	
	DRAWN BY: ERC	APPROVED BY: DT	PROCESS ELECTRICAL ROOM EMERGENCY COOLING		CITY FILE NUMBER
1 ISSUED FOR ADDENDUM 1 05/03/11 ERC	HOR. SCALE:		RELEASED FOR CONSTRUCTION BY: T. KJAR TANSON		SHEET # OF #S
0 ISSUED FOR TENDER 05/02/18 JEJ	VERTICAL SCALE:		CONSULTANT DRAWING NO. 66303D-CP1.13		CITY DRAWING NUMBER
NO. REVISIONS	DATE	BY	DATE 2005/02/15	DATE 2005-02-18	