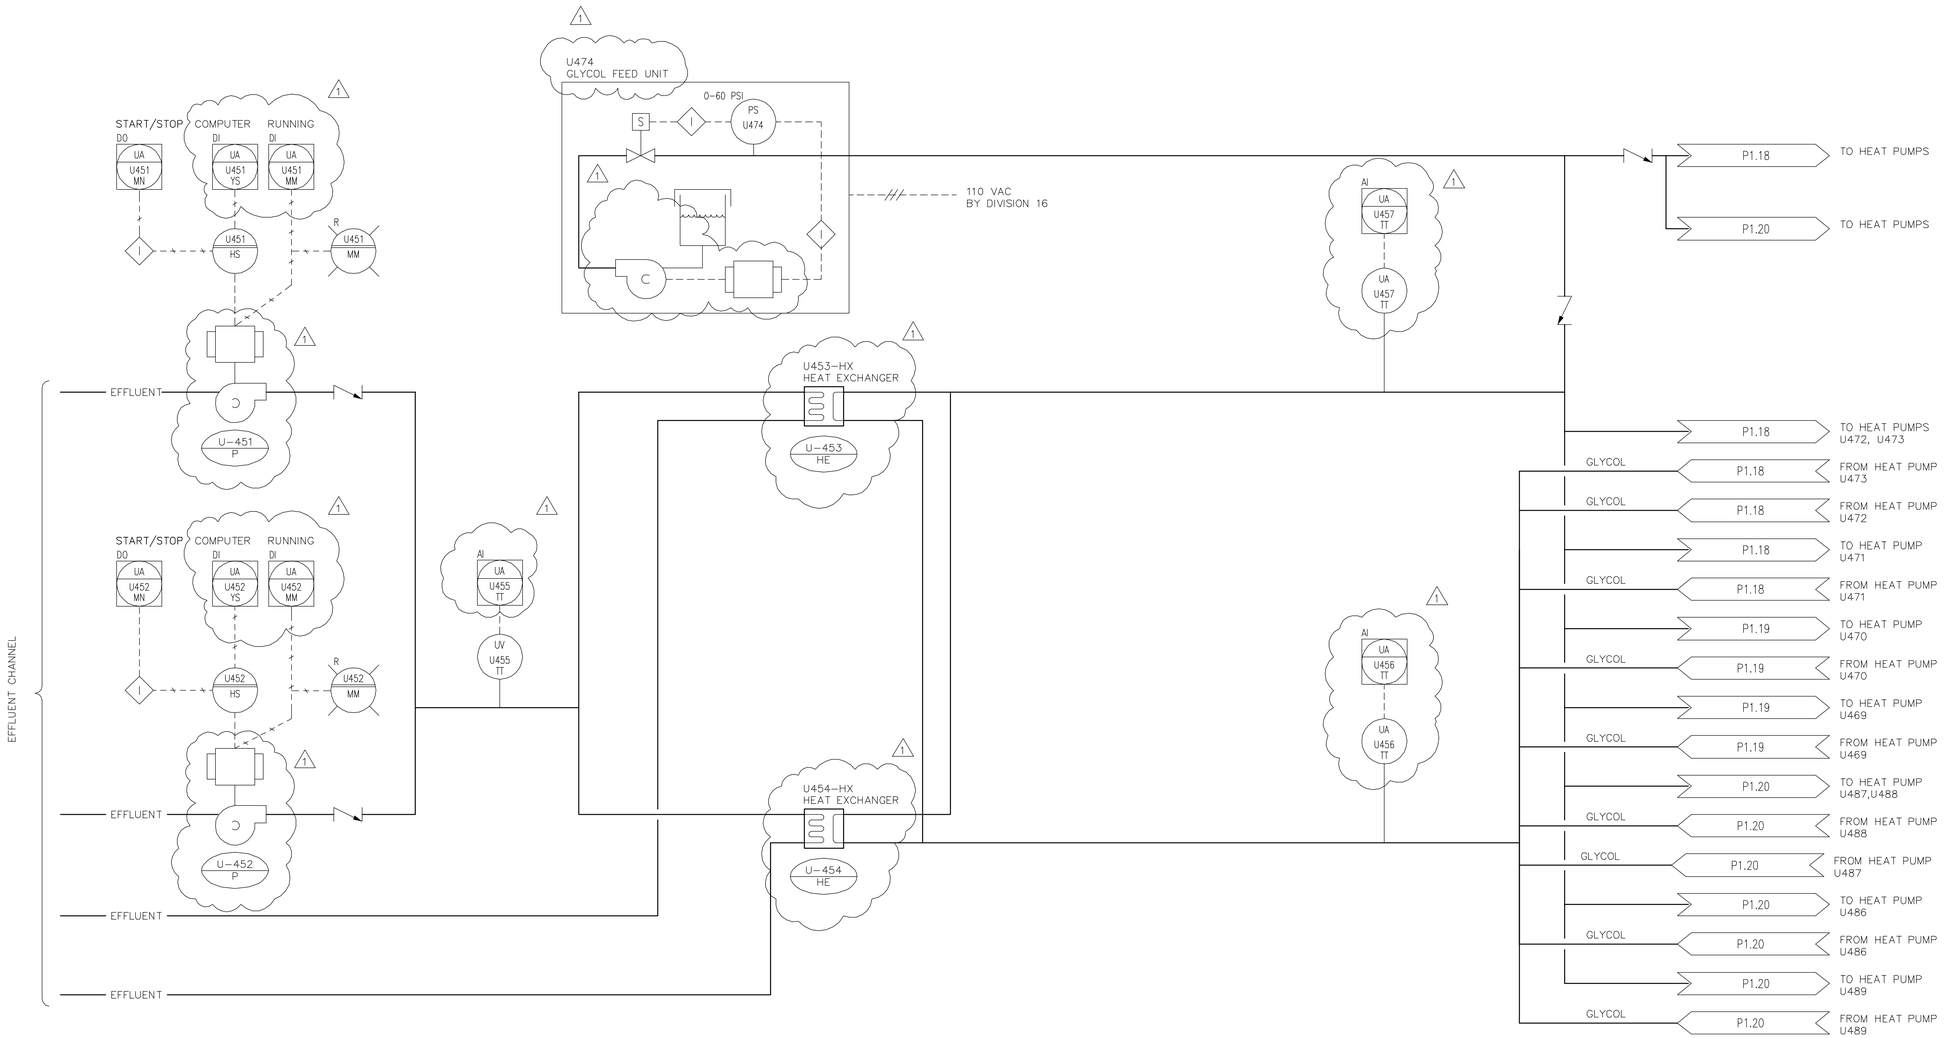

APEGM
Certificate of Authorization
Earth Tech Canada Inc.
No. 730 Expiry: April 30, 2005

B.M.
ELEV.

NO.	REVISIONS	DATE	BY
1	ISSUED FOR ADDENDUM 1	05/03/11	ERC
0	ISSUED FOR TENDER	05/02/18	JEH

EARTH TECH
Earth Tech (Canada) Inc. Winnipeg, Manitoba 204.477.5381

DESIGNED BY	NT	CHECKED BY	DT
DRAWN BY	ERC	APPROVED BY	DT
HOR. SCALE: VERTICAL SCALE:		RELEASED FOR CONSTRUCTION BY:	T. KJARTANSON
DATE	2005/02/15	DATE	2005-02-18

ENGINEER'S SEAL
ORIGINAL SIGNED BY
P.V. LAITINEN
FEB. 18/05

CONSULTANT DRAWING NO.
66303D-CP1.17

Winnipeg
THE CITY OF WINNIPEG
WATER AND WASTE DEPARTMENT

NEWPCC - SECONDARY EFFLUENT
UV DISINFECTION FACILITY

PROCESS
U453, U454 HEAT EXCHANGERS

CITY FILE NUMBER
SHEET # OF #S
CITY DRAWING NUMBER

Mar 17, 2005 - 4:36pm PLOTTED BY: clint.genus LAYOUT:Layout1 FILE:L:\work\66000\66303Dis\06g-Cdocs\Contract 2\addendum01\drawings need immediate attention!!\CP1-17.dwg