


1 RAILCAR SHELTER VENTILATION
N.T.S.

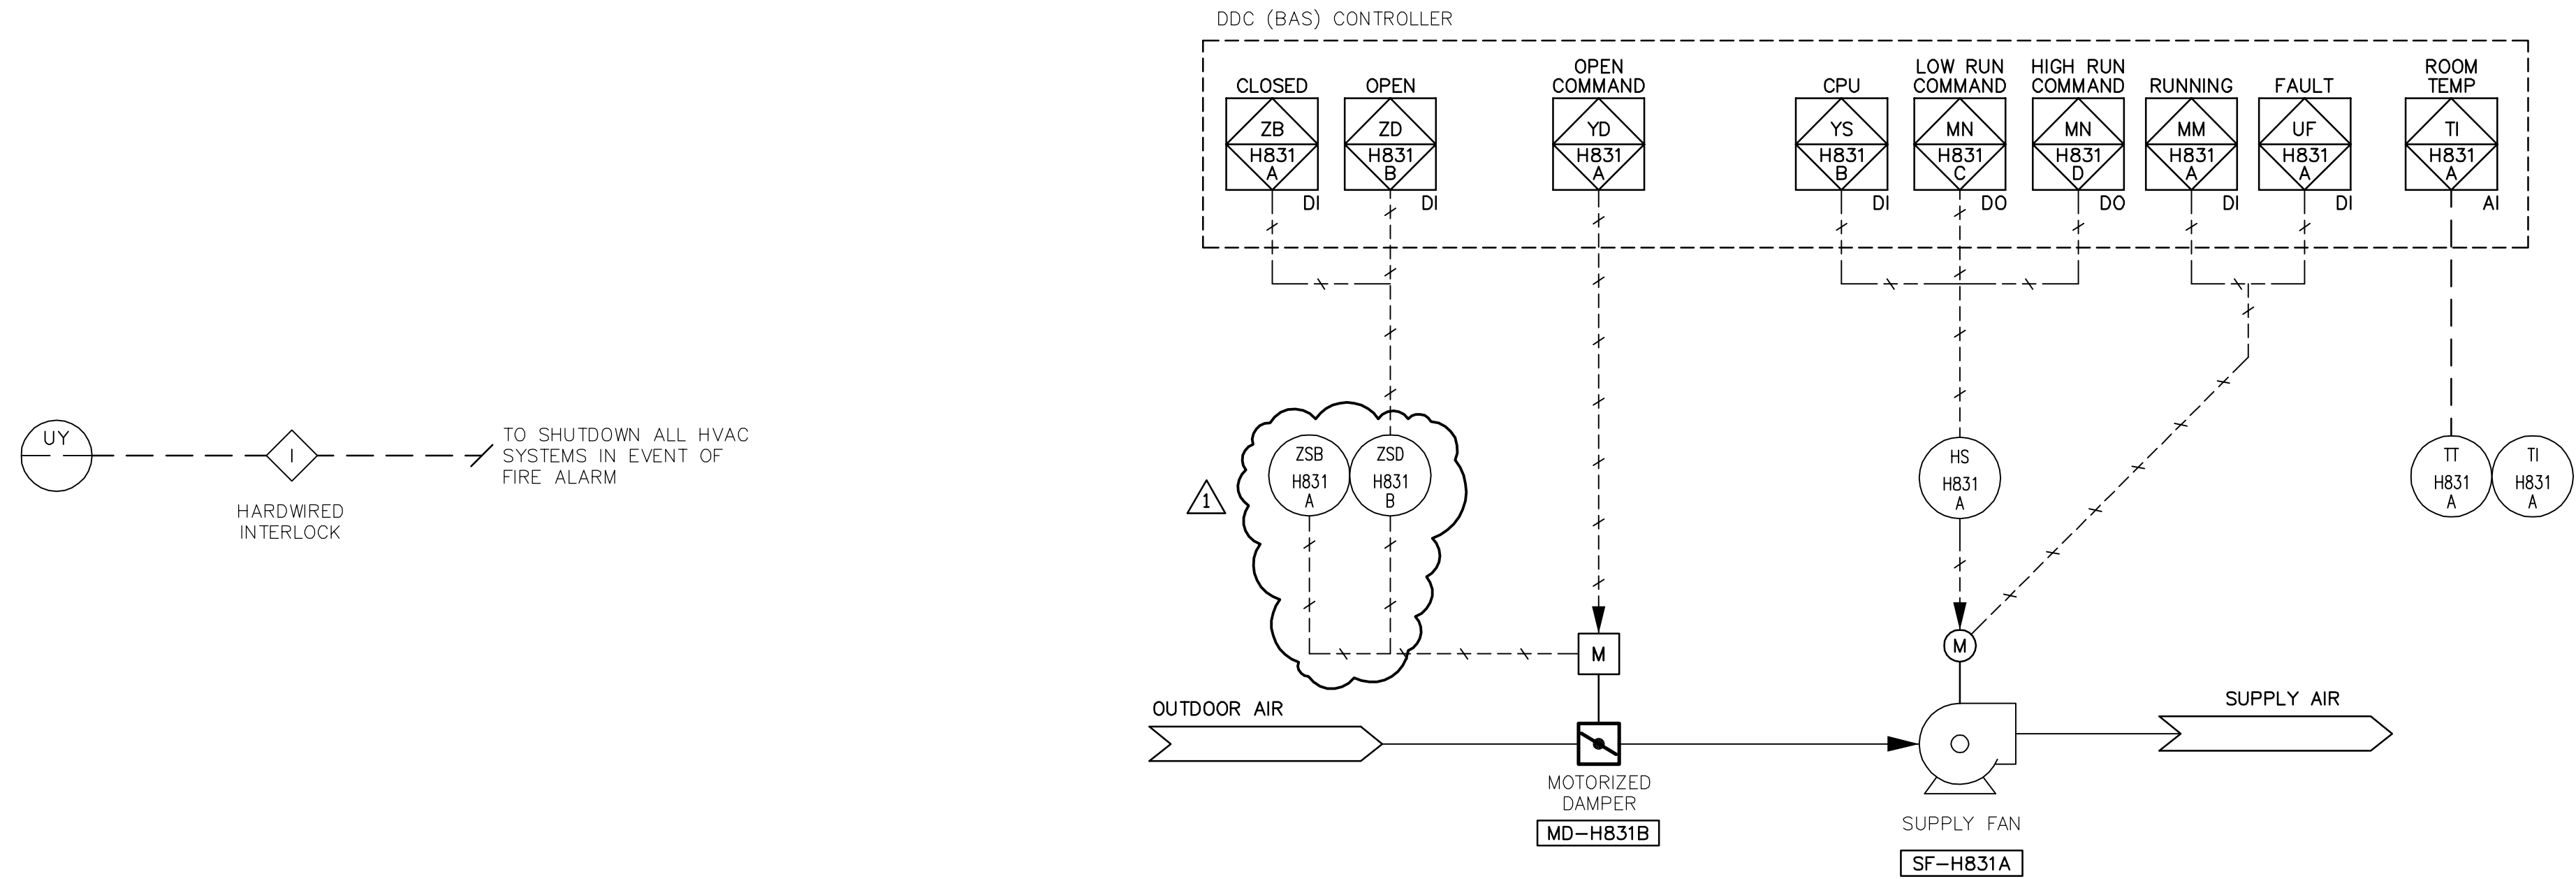

2 MECHANICAL ROOM SUPPLY FAN (SF-H831A)
N.T.S.

APECA
Certificate of Authorization
Earth Tech Canada Inc.
No. 730 Expiry: April 30, 2007

B.M. ELEV.			
DESIGNED BY	GD	CHECKED BY	PVL/AMA
DRAWN BY	DL	APPROVED BY	AHL
SCALE:	N.T.S.	RELEASED FOR CONSTRUCTION BY:	R. SOROKOWSKI
NO. REVISIONS	DATE	DATE	DATE
01	792-2006 ADDENDUM 2	07/03/20	LJW
00	ISSUED FOR TENDER	07/01/31	DL
DATE	2007/01/26	DATE	2007/01/31

CH2M HILL
Frederickson Cooper ARCHITECTS

EarthTech
A Tech International Ltd. Company

ENGINEER'S SEAL
ORIGINAL SIGNED BY
A. M. AFTANAS
2007/01/31
CONSULTANT DRAWING NO.
WS-H0519

THE CITY OF WINNIPEG
WATER AND WASTE DEPARTMENT
ENGINEERING DIVISION

WATER TREATMENT PLANT
BULK CHEMICAL BUILDING
SODIUM HYPOCHLORITE AND CHEMICAL STORAGE BUILDING

MECHANICAL
RAILCAR SHELTER
HEATING AND VENTILATION SYSTEM SCHEMATIC

CITY FILE NUMBER
SHEET OF
CITY DRAWING NUMBER
1-0608-G-H058-001-01D