SHEET: COW-A1 (05/2005)

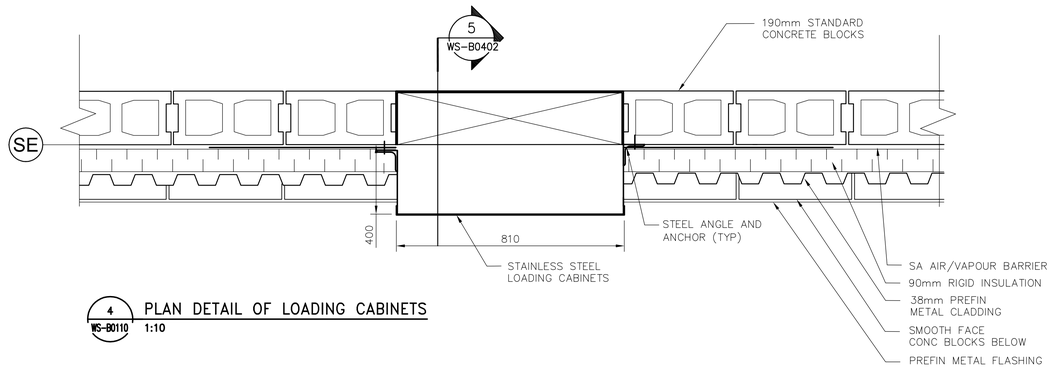

4 WS-B0110 PLAN DETAIL OF LOADING CABINETS 1:10

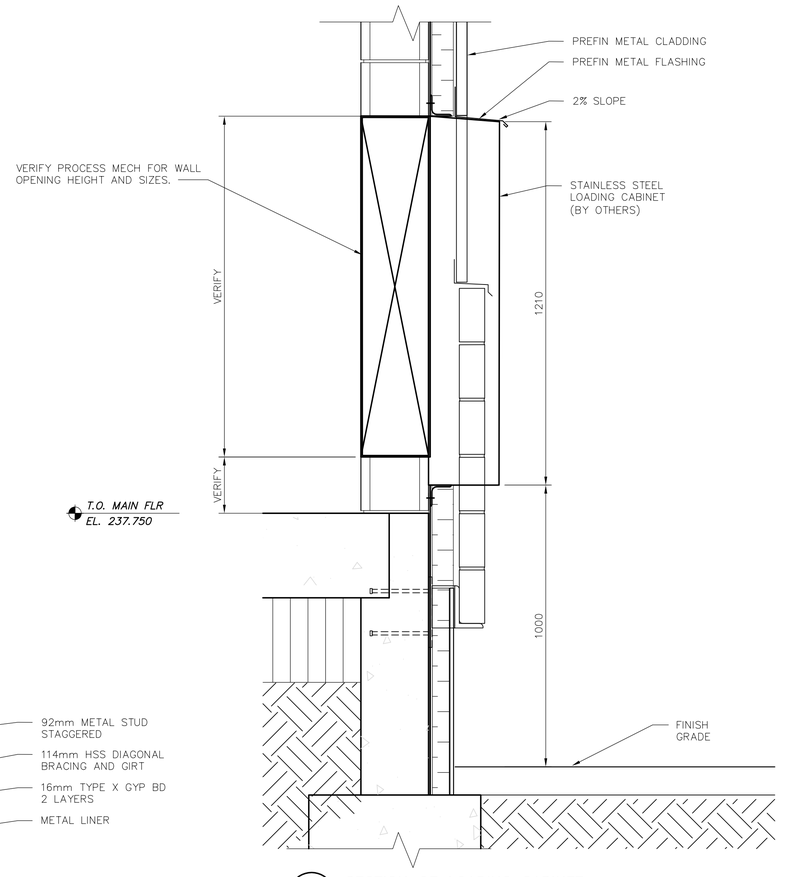

5 WS-B0402 SECTION OF LOADING CABINET 1:10

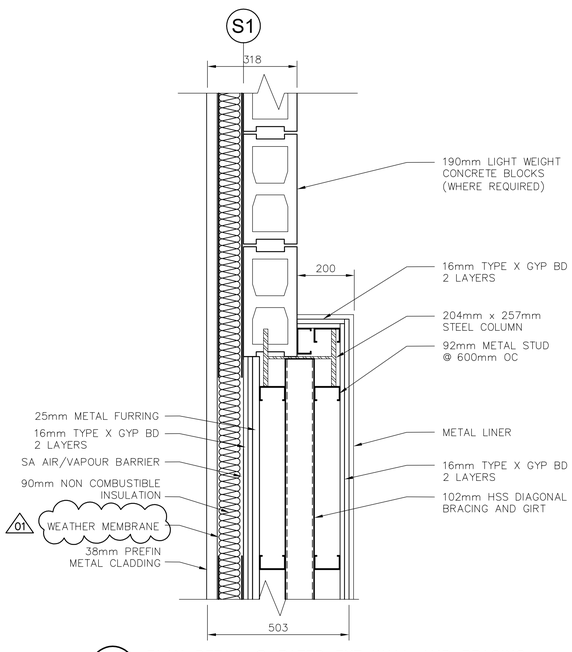

1 WS-B0100 PLAN DETAIL @ RATED EXT WALL AND BRACING 1:10

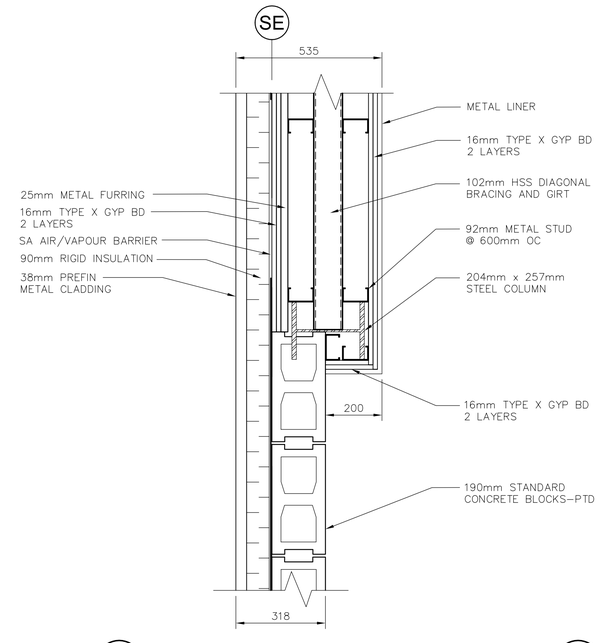

2 WS-B0100 PLAN DETAIL @ EXT WALL AND BRACING 1:10

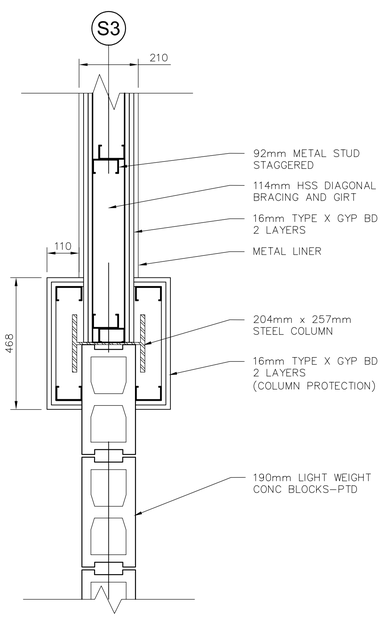

3 WS-B0100 PLAN DETAIL @ INT WALL AND BRACING 1:10

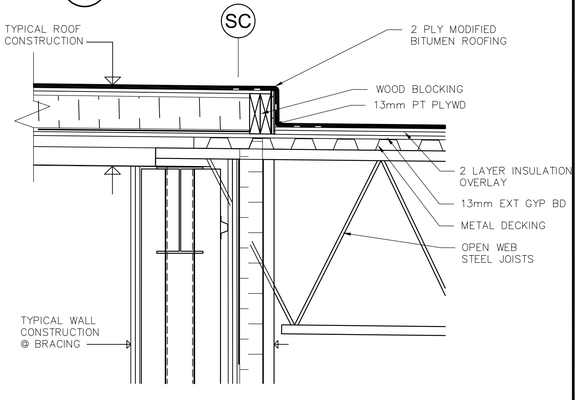

6 WS-B0204 SECTION @ ROOF TRANSITION 1:10

PROVINCE OF MANITOBA — NEIL COOPER ARCHITECT INC. №090 — APPROVED ARCHITECTURAL CORPORATION

B.M.
ELEV.

NO.	REVISIONS	DATE	BY
01	792-2006 ADDENDUM 3	07/03/30	AL
00	ISSUED FOR TENDER	07/01/31	AL

CH2MHILL — Fredericksson Cooper ARCHITECTS — EarthTech, A Tyco International Ltd. Company

DESIGNED BY	NC	CHECKED BY	LK
DRAWN BY	AL	APPROVED BY	AHL
SCALE:	AS SHOWN	RELEASED FOR CONSTRUCTION BY:	R. SOROKOWSKI
DATE	2006/10/02	DATE	2007/01/31

ENGINEER'S SEAL

ORIGINAL SIGNED BY
NEIL COOPER
2007/01/31

CONSULTANT DRAWING NO.
WS-B0402

Winnipeg

THE CITY OF WINNIPEG
WATER AND WASTE DEPARTMENT
ENGINEERING DIVISION

WATER TREATMENT PLANT
BULK CHEMICAL BUILDING
SODIUM HYPOCHLORITE AND CHEMICAL STORAGE BUILDING

ARCHITECTURAL
DETAILS

CITY FILE NUMBER
SHEET OF
CITY DRAWING NUMBER
1-0601S-A-B0402-001-01D

Last Save: 2007-03-29 1:33 PM

\\FCA-S\DATA\NC\JOBDATA\2004\04018 WINNIPEG WATER TREATMENT\02A-CAD\BULK CHEMICAL BUILDING\CONT DWGS\ARCH DWGS\ADDENDUM 3\DN_WS-B0402_FC.DWG