
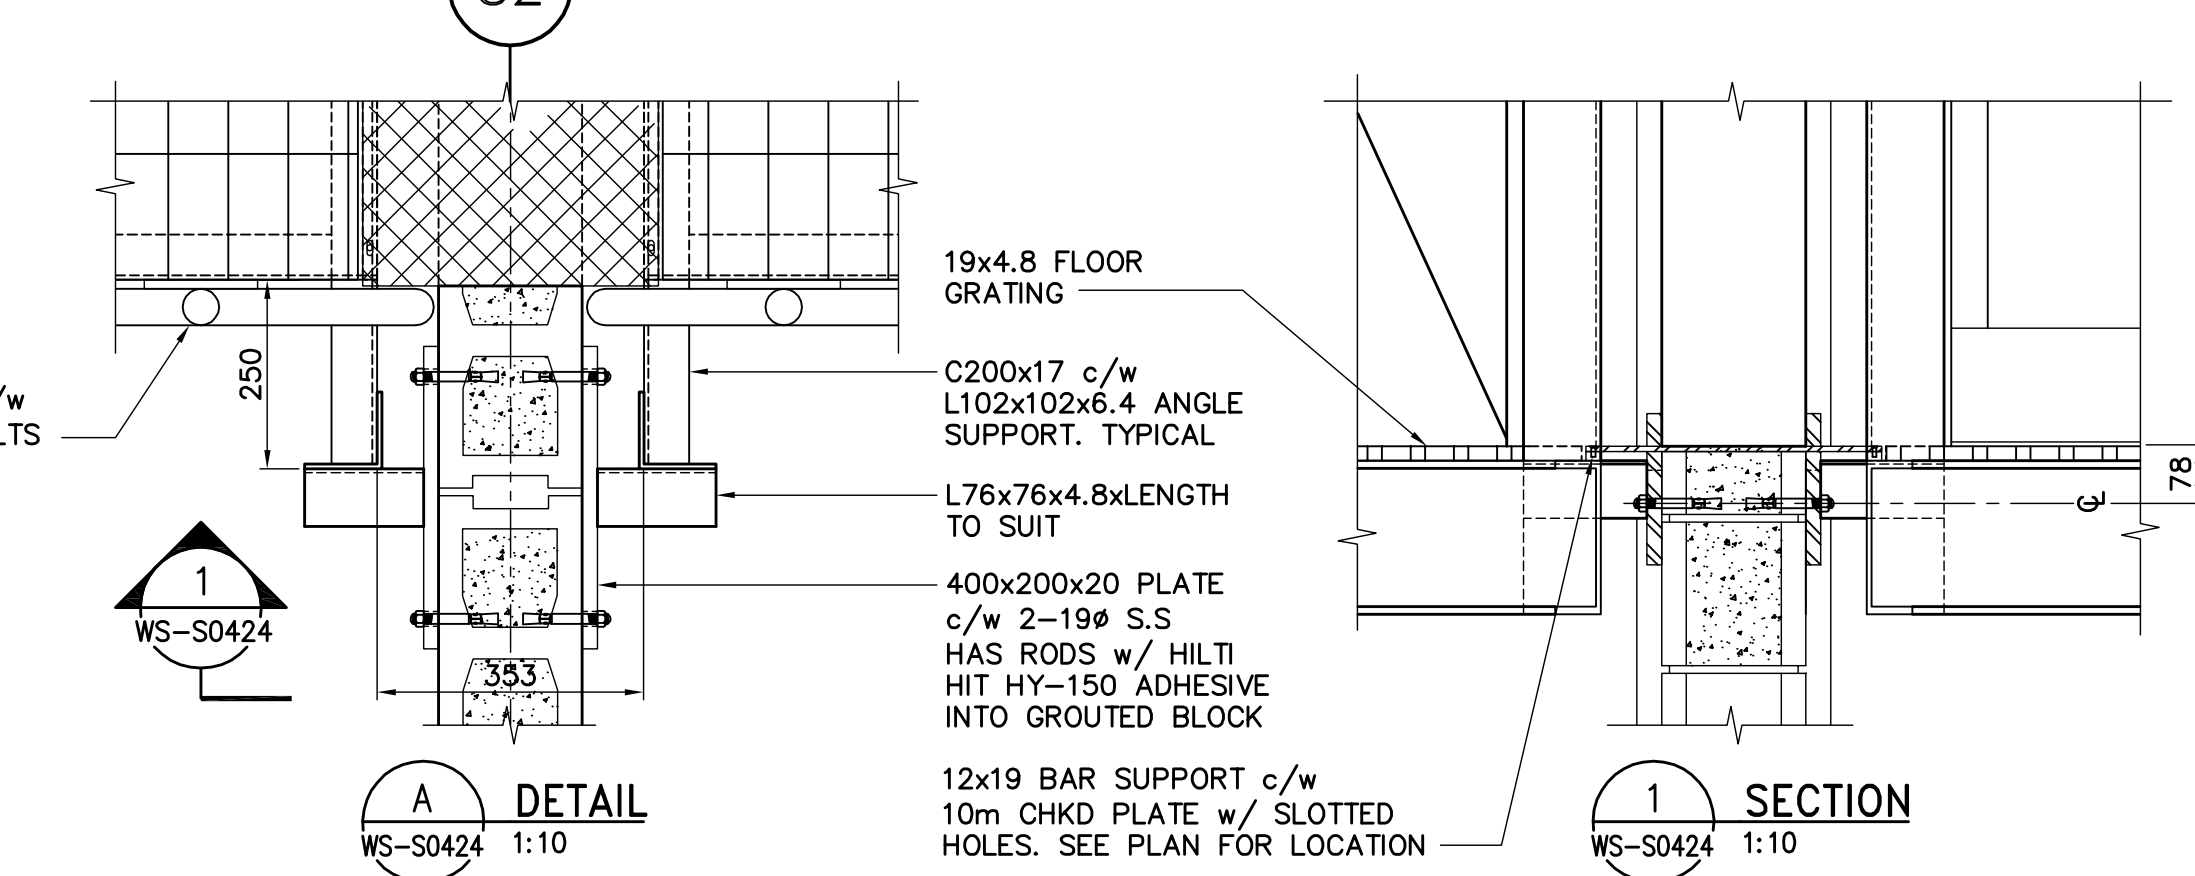
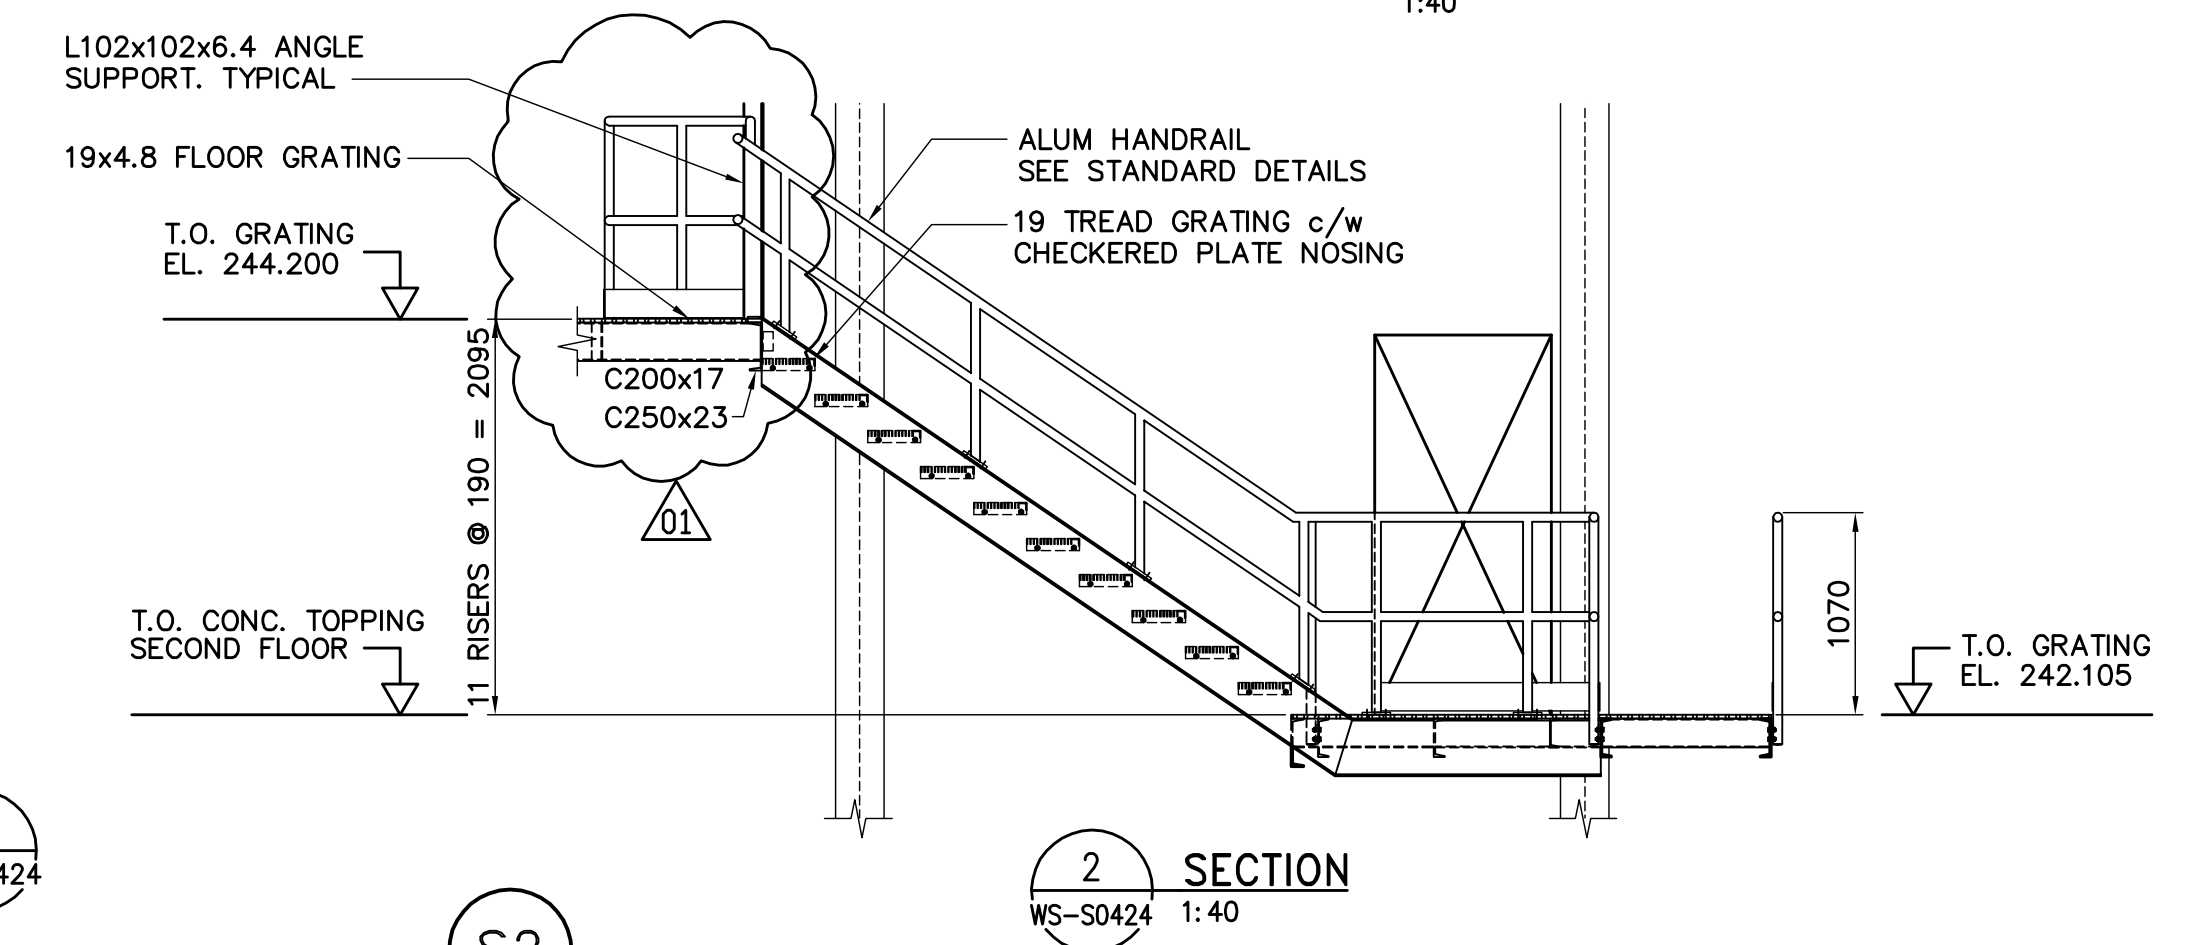


NOTE:
ALL STAIR STRINGERS REVISED TO C310x31

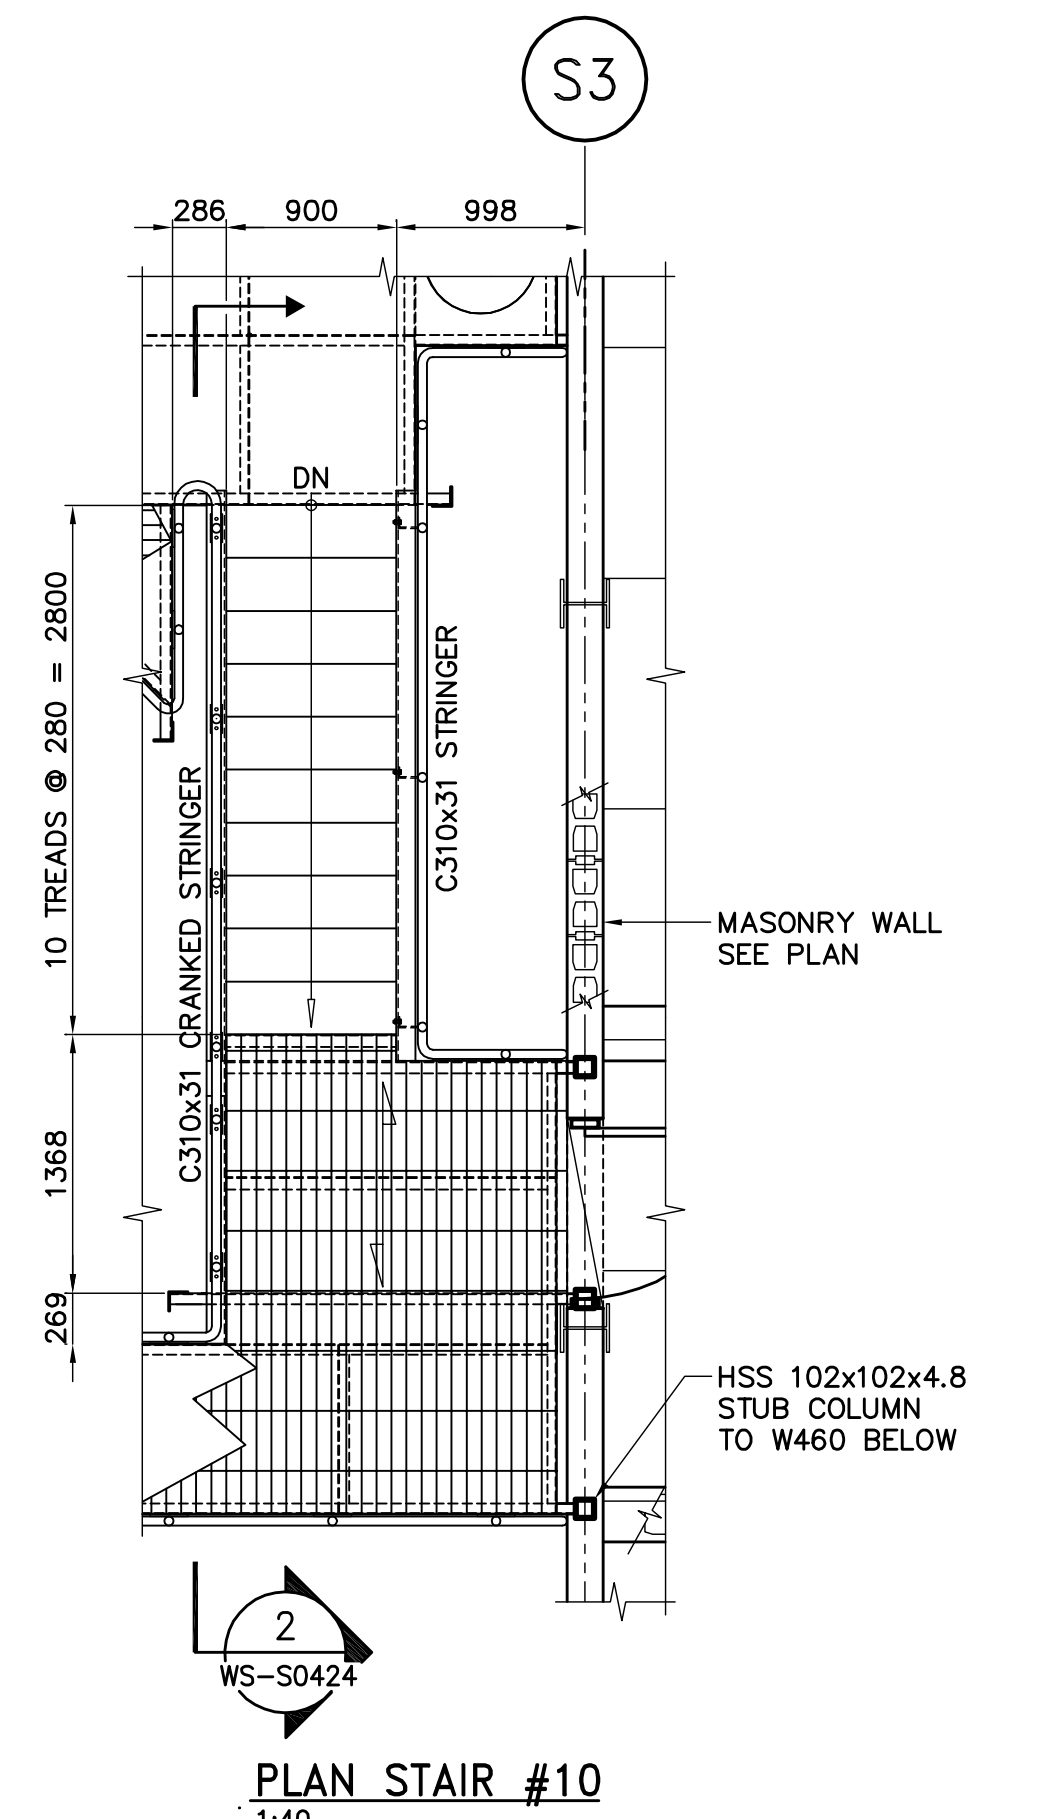

B.M. ELEV.	CH2M HILL Frederickson Cooper ARCHITECTS	EarthTech A Tyco International Ltd. Company	ENGINEER'S SEAL ORIGINAL SIGNED BY A. POCHANART 2007/01/31	THE CITY OF WINNIPEG WATER AND WASTE DEPARTMENT ENGINEERING DIVISION
	DESIGNED BY: ARA	CHECKED BY: AP	CONSULTANT DRAWING NO. WS-S0424	WATER TREATMENT PLANT BULK CHEMICAL BUILDING SODIUM HYPOCHLORITE AND CHEMICAL STORAGE BUILDING
	DRAWN BY: WDB	APPROVED BY: AHL		
	SCALE: AS NOTED	RELEASED FOR CONSTRUCTION BY: R. SOROKOWSKI		SHEET OF
02 792-2006 ADDENDUM 3 07/03/30 WDB				CITY DRAWING NUMBER
01 792-2006 ADDENDUM 2 07/03/22 WDB				1-06016-A-0424-001-02D
00 ISSUED FOR TENDER 07/01/31 WDB				
NO. REVISIONS	DATE	BY	DATE	
	2006/09/12		2007/01/31	