SHEET: COW-A1 (05/2005)

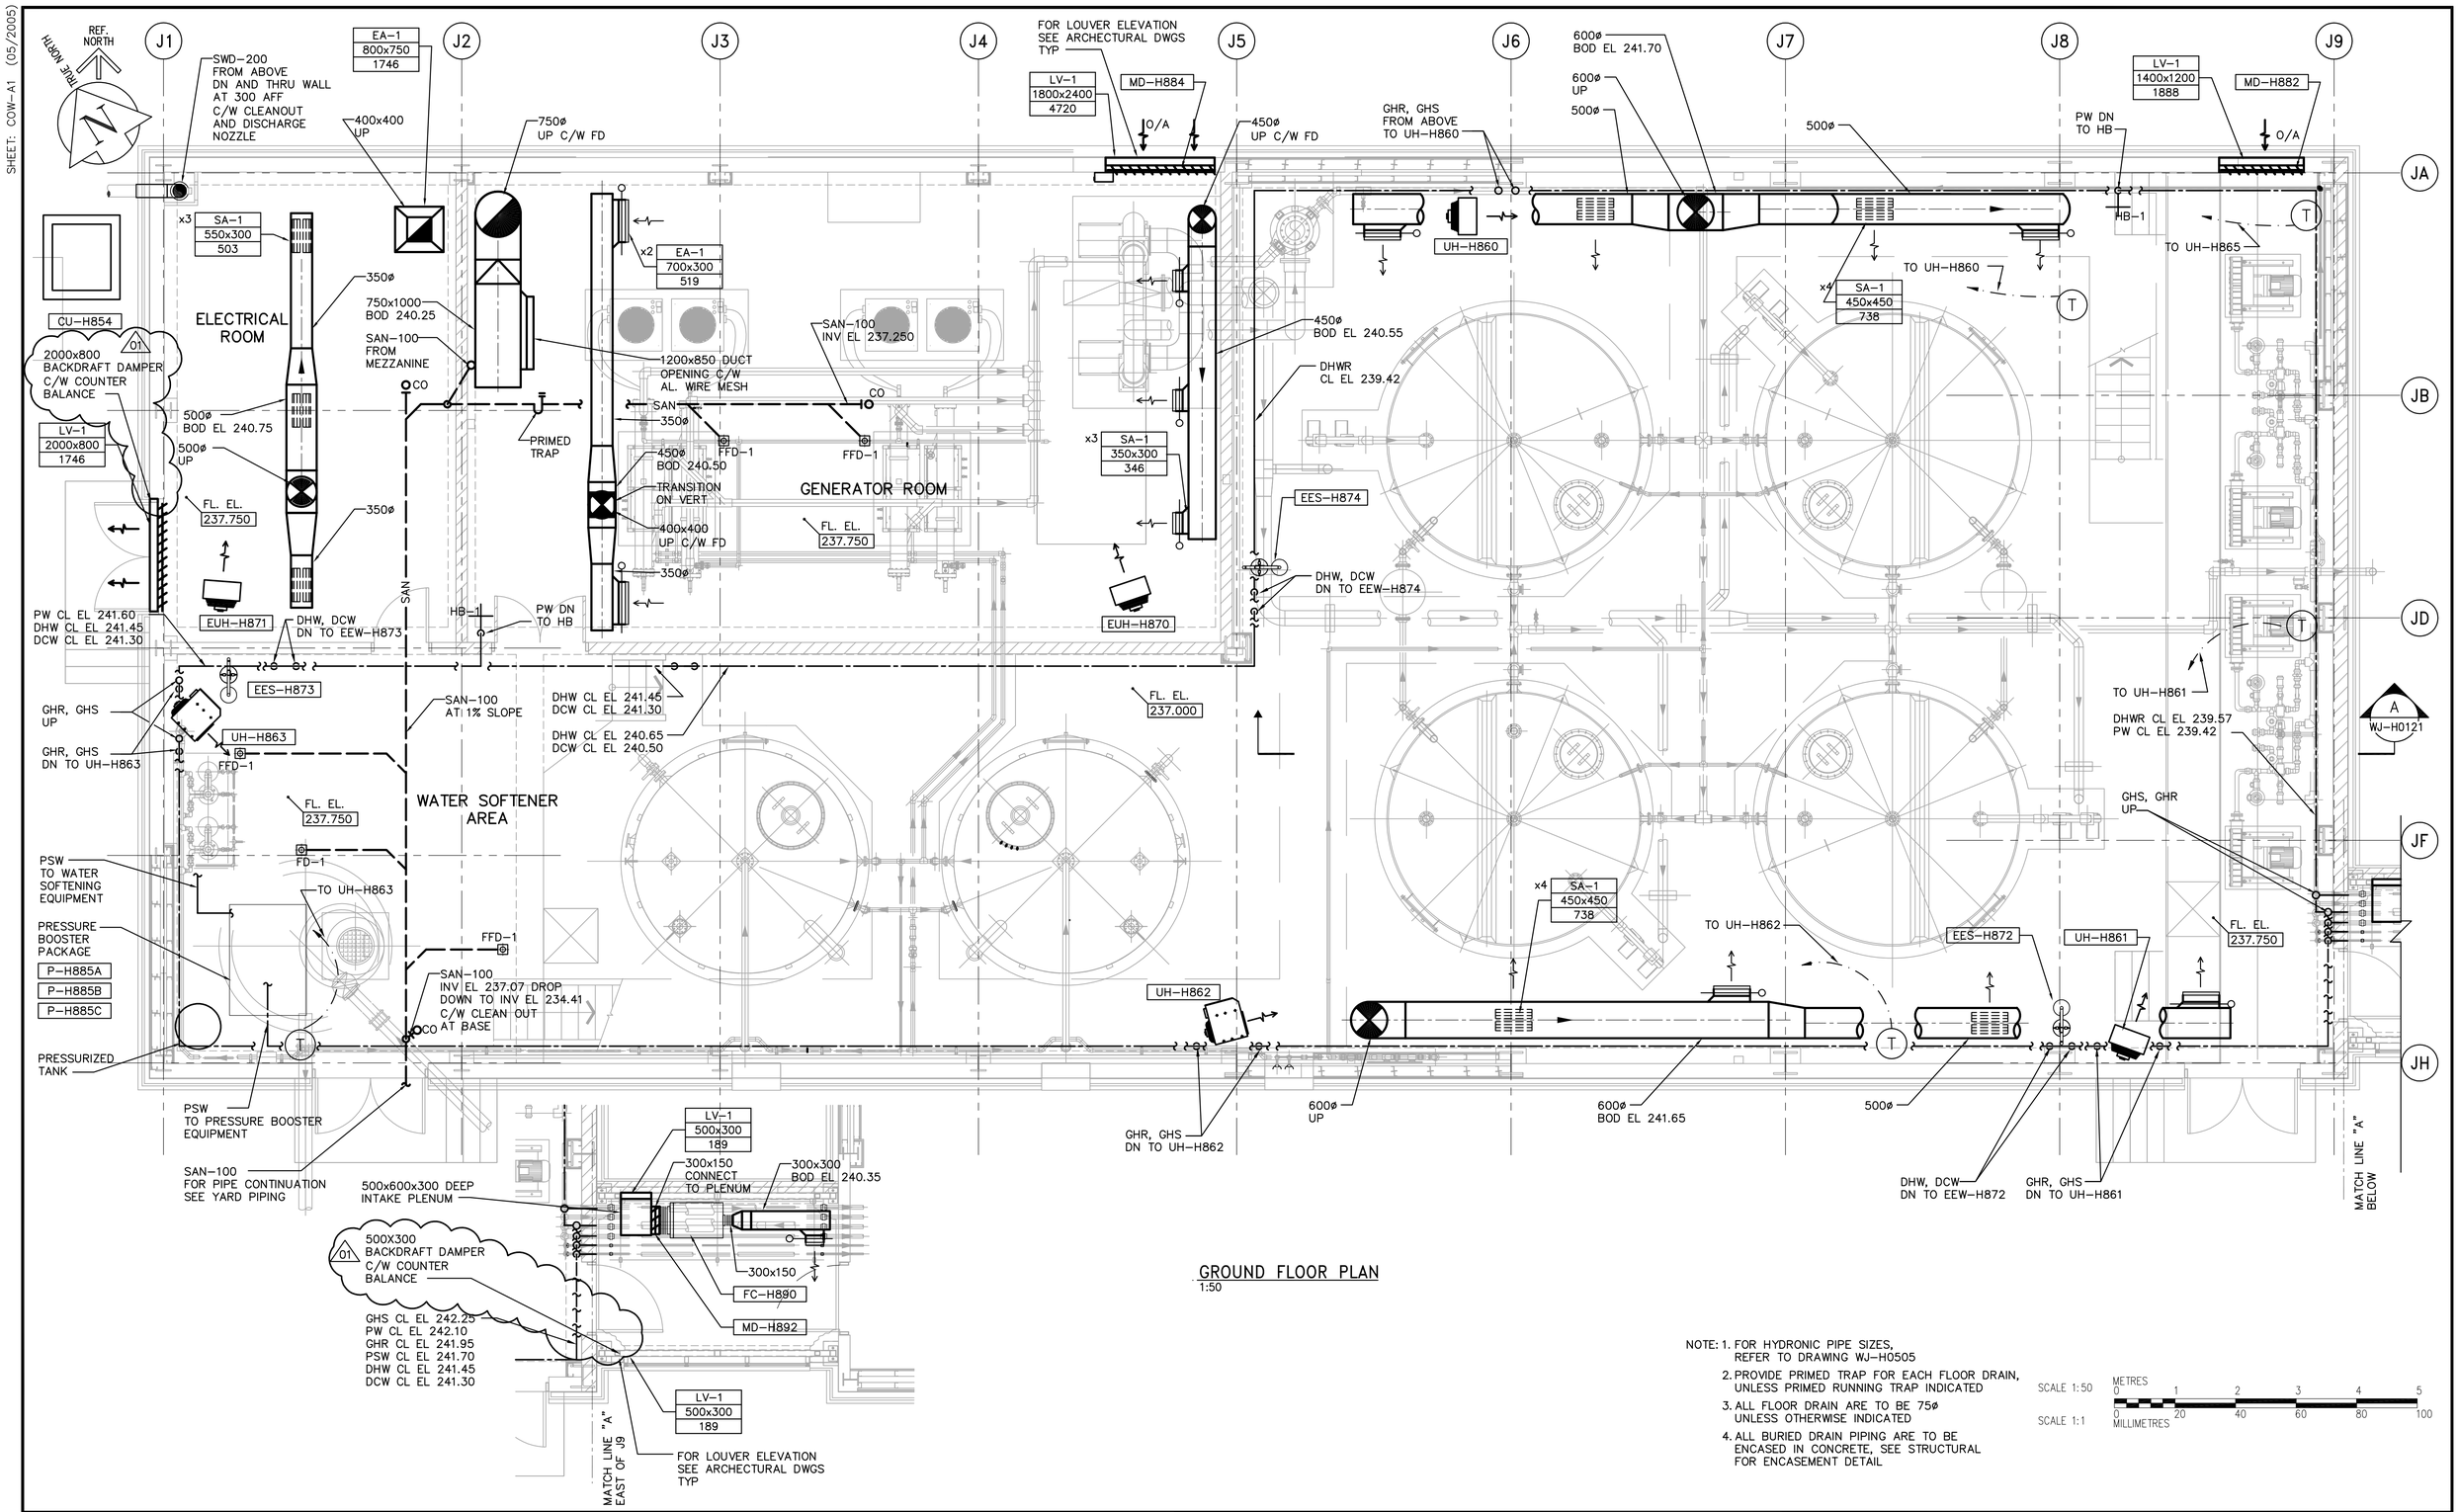

GROUND FLOOR PLAN
1:50

NOTE: 1. FOR HYDRONIC PIPE SIZES, REFER TO DRAWING WJ-H0505
2. PROVIDE PRIMED TRAP FOR EACH FLOOR DRAIN, UNLESS PRIMED RUNNING TRAP INDICATED
3. ALL FLOOR DRAIN ARE TO BE 75ø UNLESS OTHERWISE INDICATED
4. ALL BURIED DRAIN PIPING ARE TO BE ENCASED IN CONCRETE, SEE STRUCTURAL FOR ENCASEMENT DETAIL

SCALE 1:50 METRES 0 1 2 3 4 5
SCALE 1:1 MILLIMETRES 0 20 40 60 80 100

APEGM
Certificate of Authorization
CH2M HILL Canada Ltd.
No. 1441 Expiry: April 30, 2007

NO.	REVISIONS	DATE	BY
01	792-2006 ADDENDUM 5	07/04/11	TT
00	ISSUED FOR TENDER	07/01/31	TT

B.M. ELEV.

CH2MHILL Fredericksen Cooper ARCHITECTS
EarthTech A Tyco International Ltd. Company

DESIGNED BY	TT	CHECKED BY	DKC
DRAWN BY	KF	APPROVED BY	AHL
SCALE:	1:50	RELEASED FOR CONSTRUCTION BY:	R. SOROKOWSKI
DATE	2006/10/10	DATE	2007/01/31

ENGINEER'S SEAL
ORIGINAL SIGNED BY
D.K. CUDDINGTON
2007/01/31

CONSULTANT DRAWING NO.
WJ-H0111

Winnipeg
THE CITY OF WINNIPEG
WATER AND WASTE DEPARTMENT
ENGINEERING DIVISION

WATER TREATMENT PLANT
SODIUM HYPOCHLORITE BUILDING
SODIUM HYPOCHLORITE AND CHEMICAL STORAGE BUILDINGS

HVAC AND PLUMBING
SODIUM HYPOCHLORITE BUILDING
GROUND FLOOR PLAN

CITY FILE NUMBER
SHEET OF
CITY DRAWING NUMBER
1-0601J-A-H0111-001-00D

Last Save: 2007-04-10 12:02 PM

C:\DOCUMENTS AND SETTINGS\KFONG\MY DOCUMENTS\NDMPROJ\321352 - WINNIPEGWTP\DN_WJ-H0111_CH2M.DWG