


CDW-A3 (02/2006)

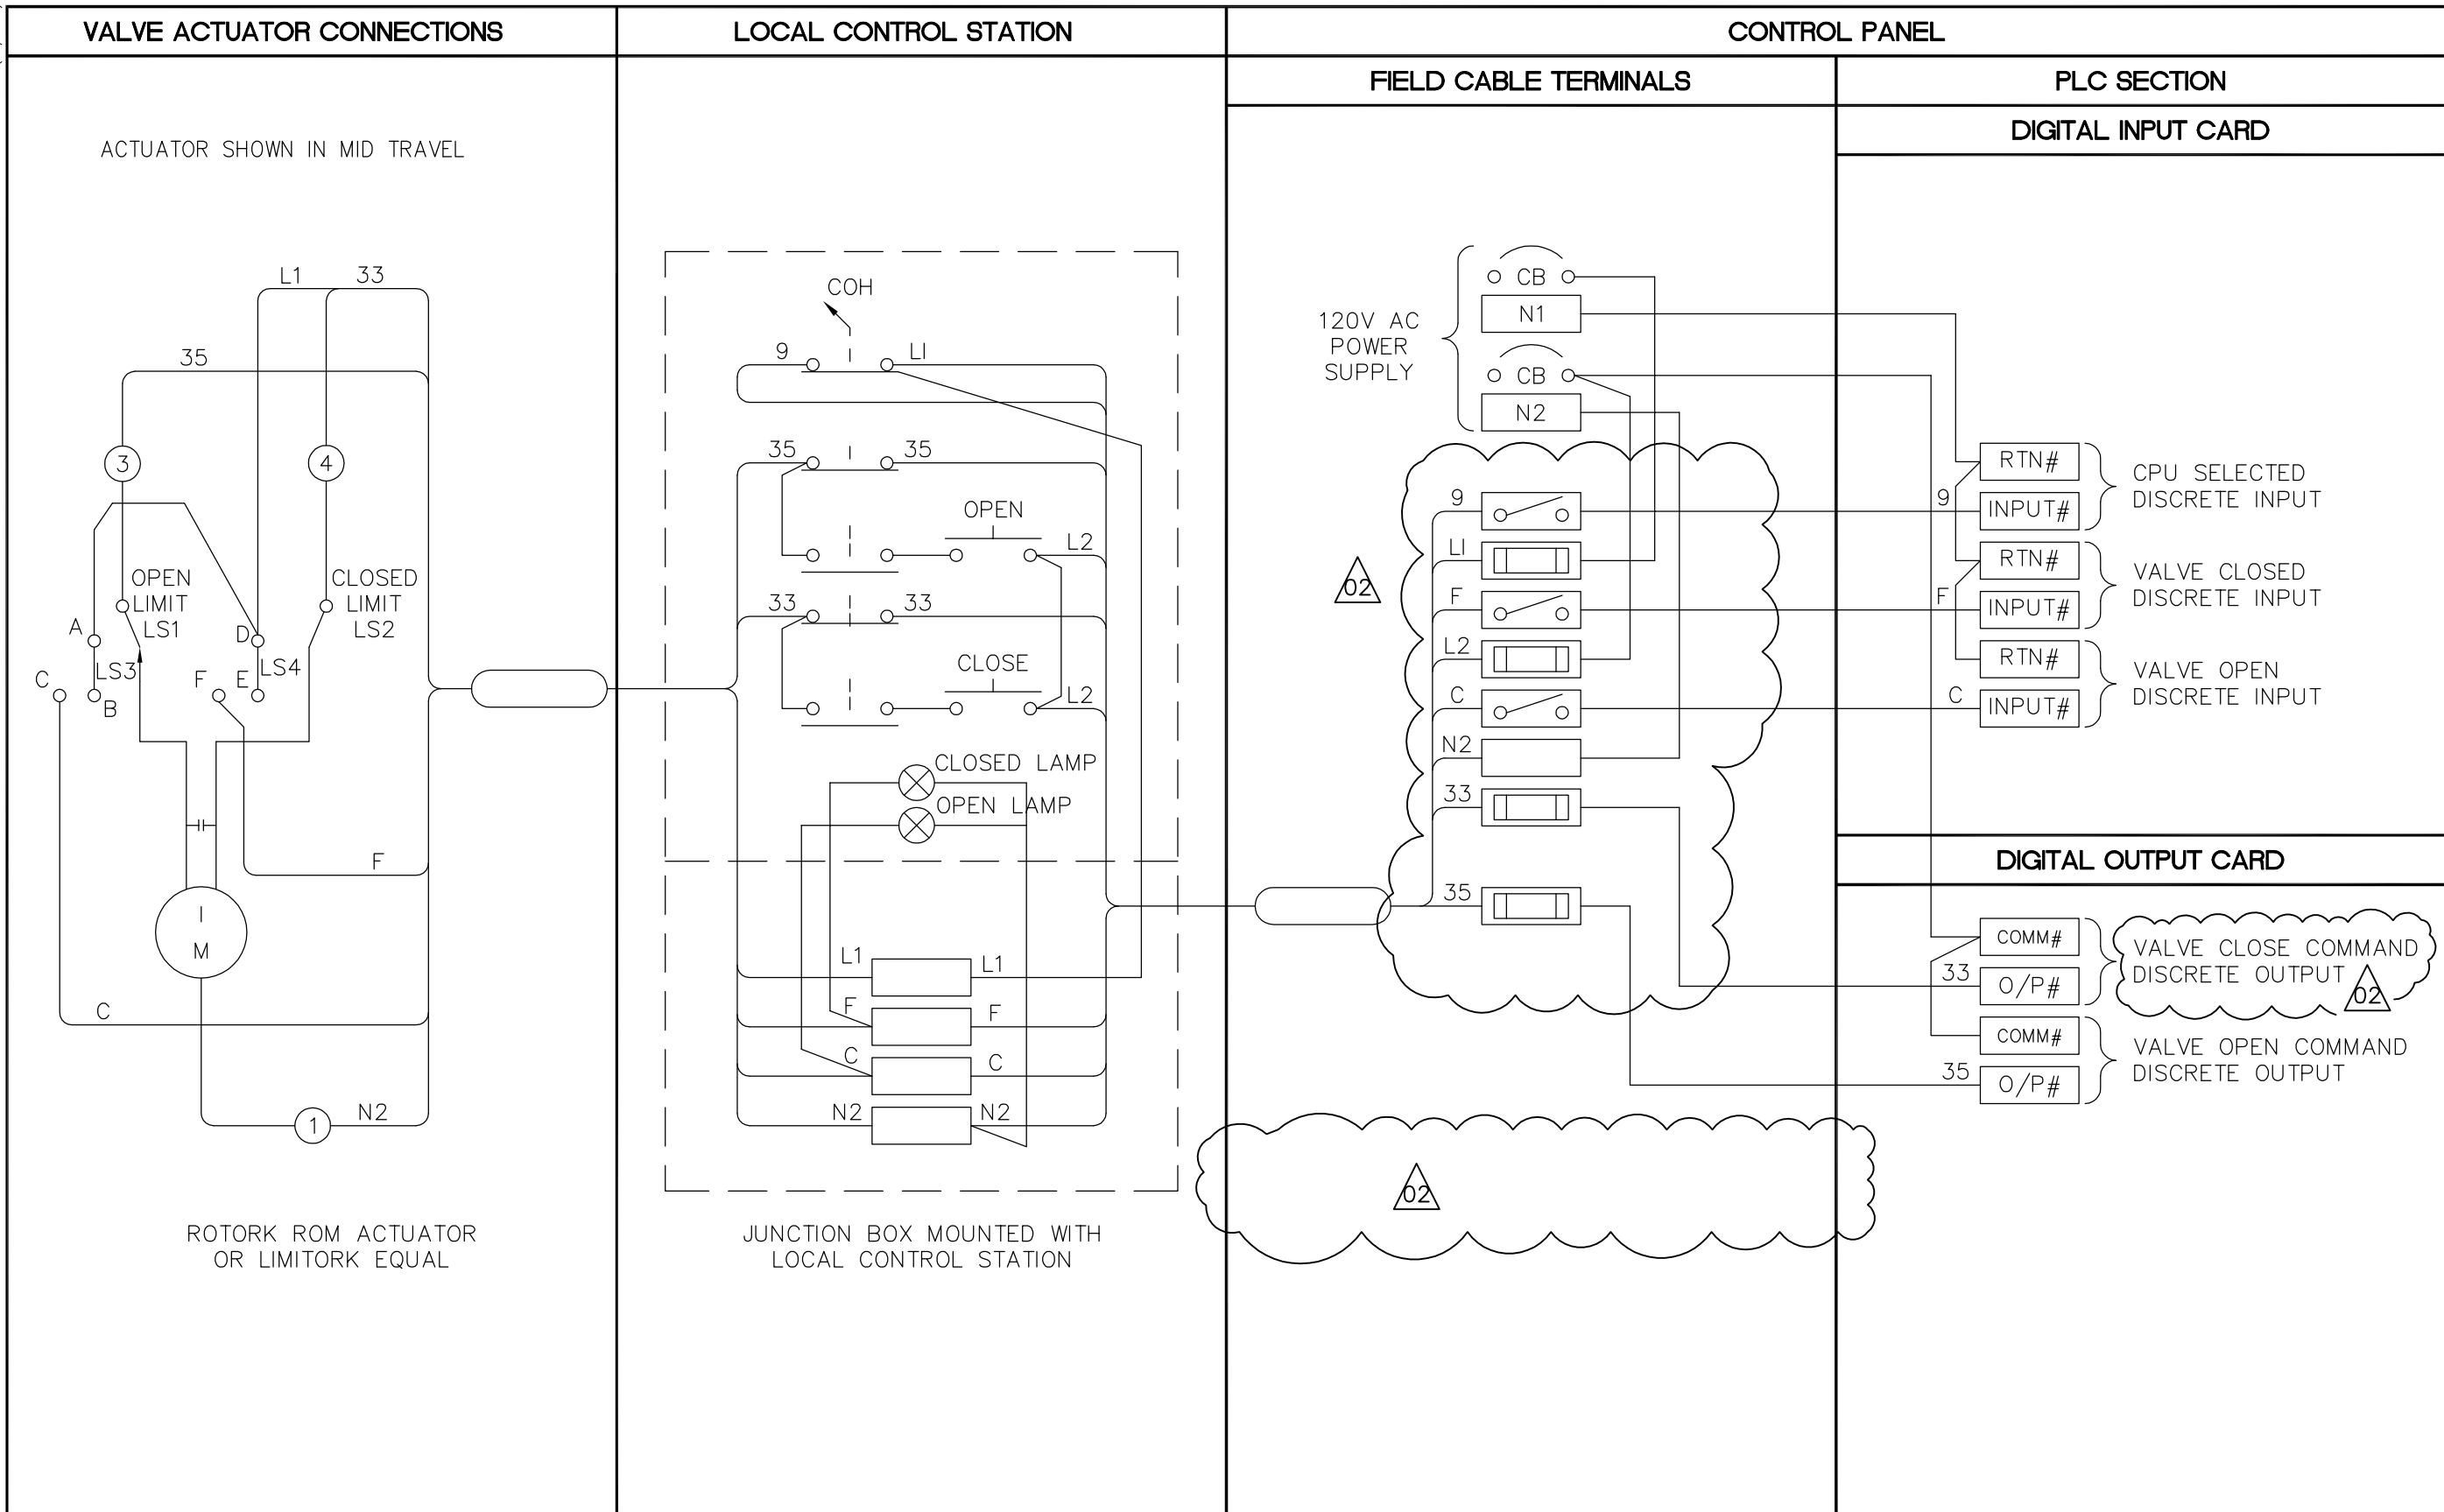

**NOTE:**

1. IF ACTUATOR CONTROLS ARE INACCESSIBLE THEN THIS ARRANGEMENT WILL APPLY.



NO.	REVISIONS	DATE	BY
02	792-2006 ADDENDUM 5	07/04/11	JBC
01	792-2006 ADDENDUM 4	07/04/05	LAE
00	ISSUED FOR TENDER	07/01/01	LAE

DESIGNED BY	NT	CHECKED BY	SWT
DRAWN BY	GLG	APPROVED BY	AHL
SCALE:	NTS	RELEASED FOR CONSTRUCTION BY:	R. SOROKOWSKI
DATE	2007/01/19	DATE	2007/01/31

ENGINEER'S SEAL

ORIGINAL SIGNED BY

S.W. TORMEY

2007/01/31

CONSULTANT DRAWING NO.

WS-A0454

**THE CITY OF WINNIPEG**  
**WATER AND WASTE DEPARTMENT**  
**ENGINEERING DIVISION**

WATER TREATMENT PLANT  
 BULK CHEMICAL BUILDING  
 SODIUM HYPOCHLORITE AND CHEMICAL STORAGE BUILDING

AUTOMATION / I&C  
 MOTORIZED VALVE OPEN/CLOSE WITH LOCAL CONTROL STATION  
 INSTRUMENTATION LOOP DIAGRAM

CITY FILE NUMBER

SHEET OF

CITY DRAWING NUMBER

1-0601S-H-A0454-001-02B