SHEET: COW-A1 (05/2005)

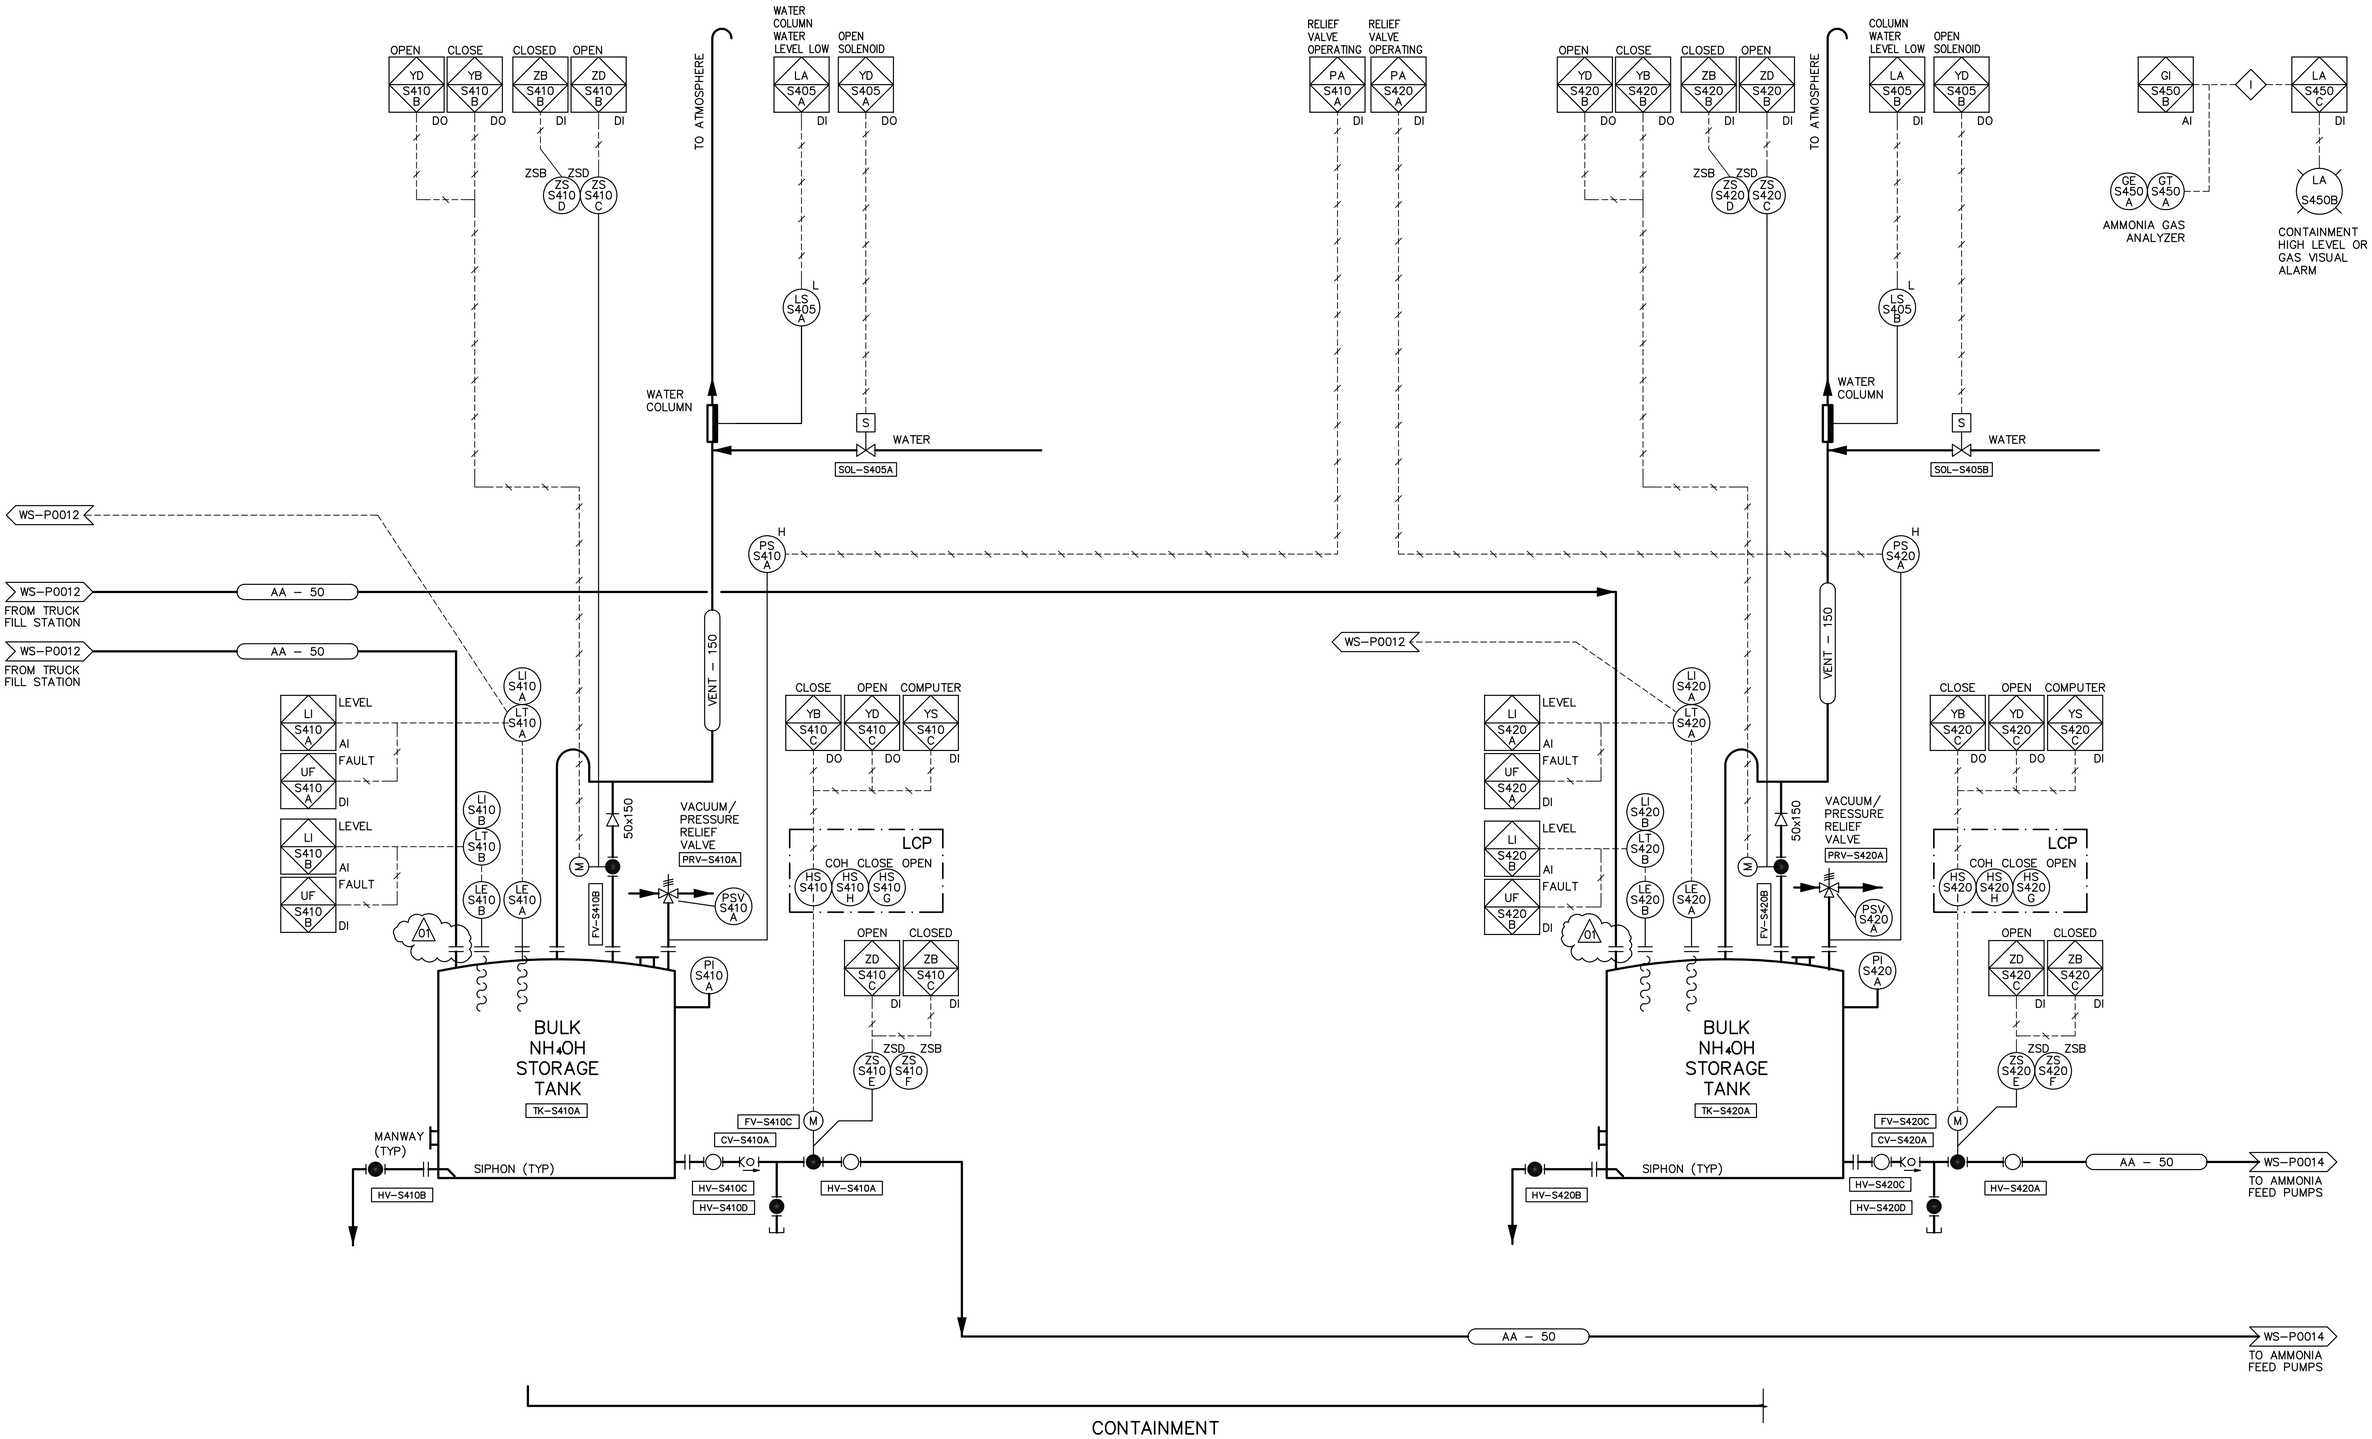

NH_4OH BULK TANKS

QTY: 2
CAPACITY: 37.5m^3 EACH
DIMENSIONS: 3.0mø x 5.5m H
MATERIAL: 316 STAINLESS STEEL

APEGM
Certificate of Authorization
Earth Tech Canada Inc.
No. 730 Expiry: April 30, 2007

B.M.
ELEV.

NO.	REVISIONS	DATE	BY
02	ISSUED FOR CONSTRUCTION	07/05/25	LAE
01	792-2006 ADDENDUM 4	07/04/05	JBC
00	ISSUED FOR TENDER	07/01/31	JBC

CH2MHILL
Fredericksen Cooper ARCHITECTS
EarthTech A Tyco International Ltd. Company

DESIGNED BY	SBW	CHECKED BY	NT
DRAWN BY	GLG	APPROVED BY	AHL
SCALE:	NONE	RELEASED FOR CONSTRUCTION BY:	R. SOROKOWSKI
DATE	2006/01/12	DATE	2007/01/31

ENGINEER'S SEAL
ORIGINAL SIGNED BY
S.B. WILLIAMSON
2007/01/31

CONSULTANT DRAWING NO.
WS-P0013

Winnipeg
THE CITY OF WINNIPEG
WATER AND WASTE DEPARTMENT
ENGINEERING DIVISION

WATER TREATMENT PLANT
BULK CHEMICAL STORAGE
SODIUM HYPOCHLORITE AND CHEMICAL STORAGE BUILDING

PROCESS
BULK AMMONIA OFFLOADING AND STORAGE
PROCESS AND INSTRUMENTATION DIAGRAM

CITY FILE NUMBER
SHEET OF
CITY DRAWING NUMBER
1-0601S-G-P0013-001-02D

Last Save: 2007-05-16 3:14 PM

L:\WORK\79000\79538\02A-CAD\ALL\SUBMISSION\CONSTRUCTION\C40 - CHEMICAL STORAGE & SODIUM HYPO GEN BUILDINGS\ET\DRAWINGS\DN_WS-P0013_ET.DWG