
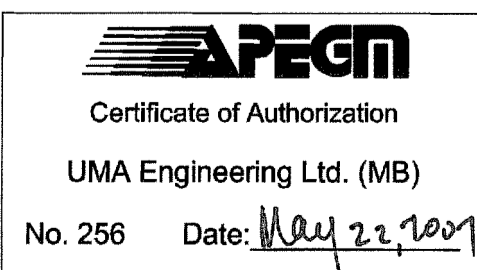


A1 SIZE 23.4" x 33.1" (594mm x 841mm)

PLOT: 07/05/22 14:17:12 PM


UMA FILE NAME: 0265-397-00_01-S-0203_RX.dwg Saved By: mayyugie

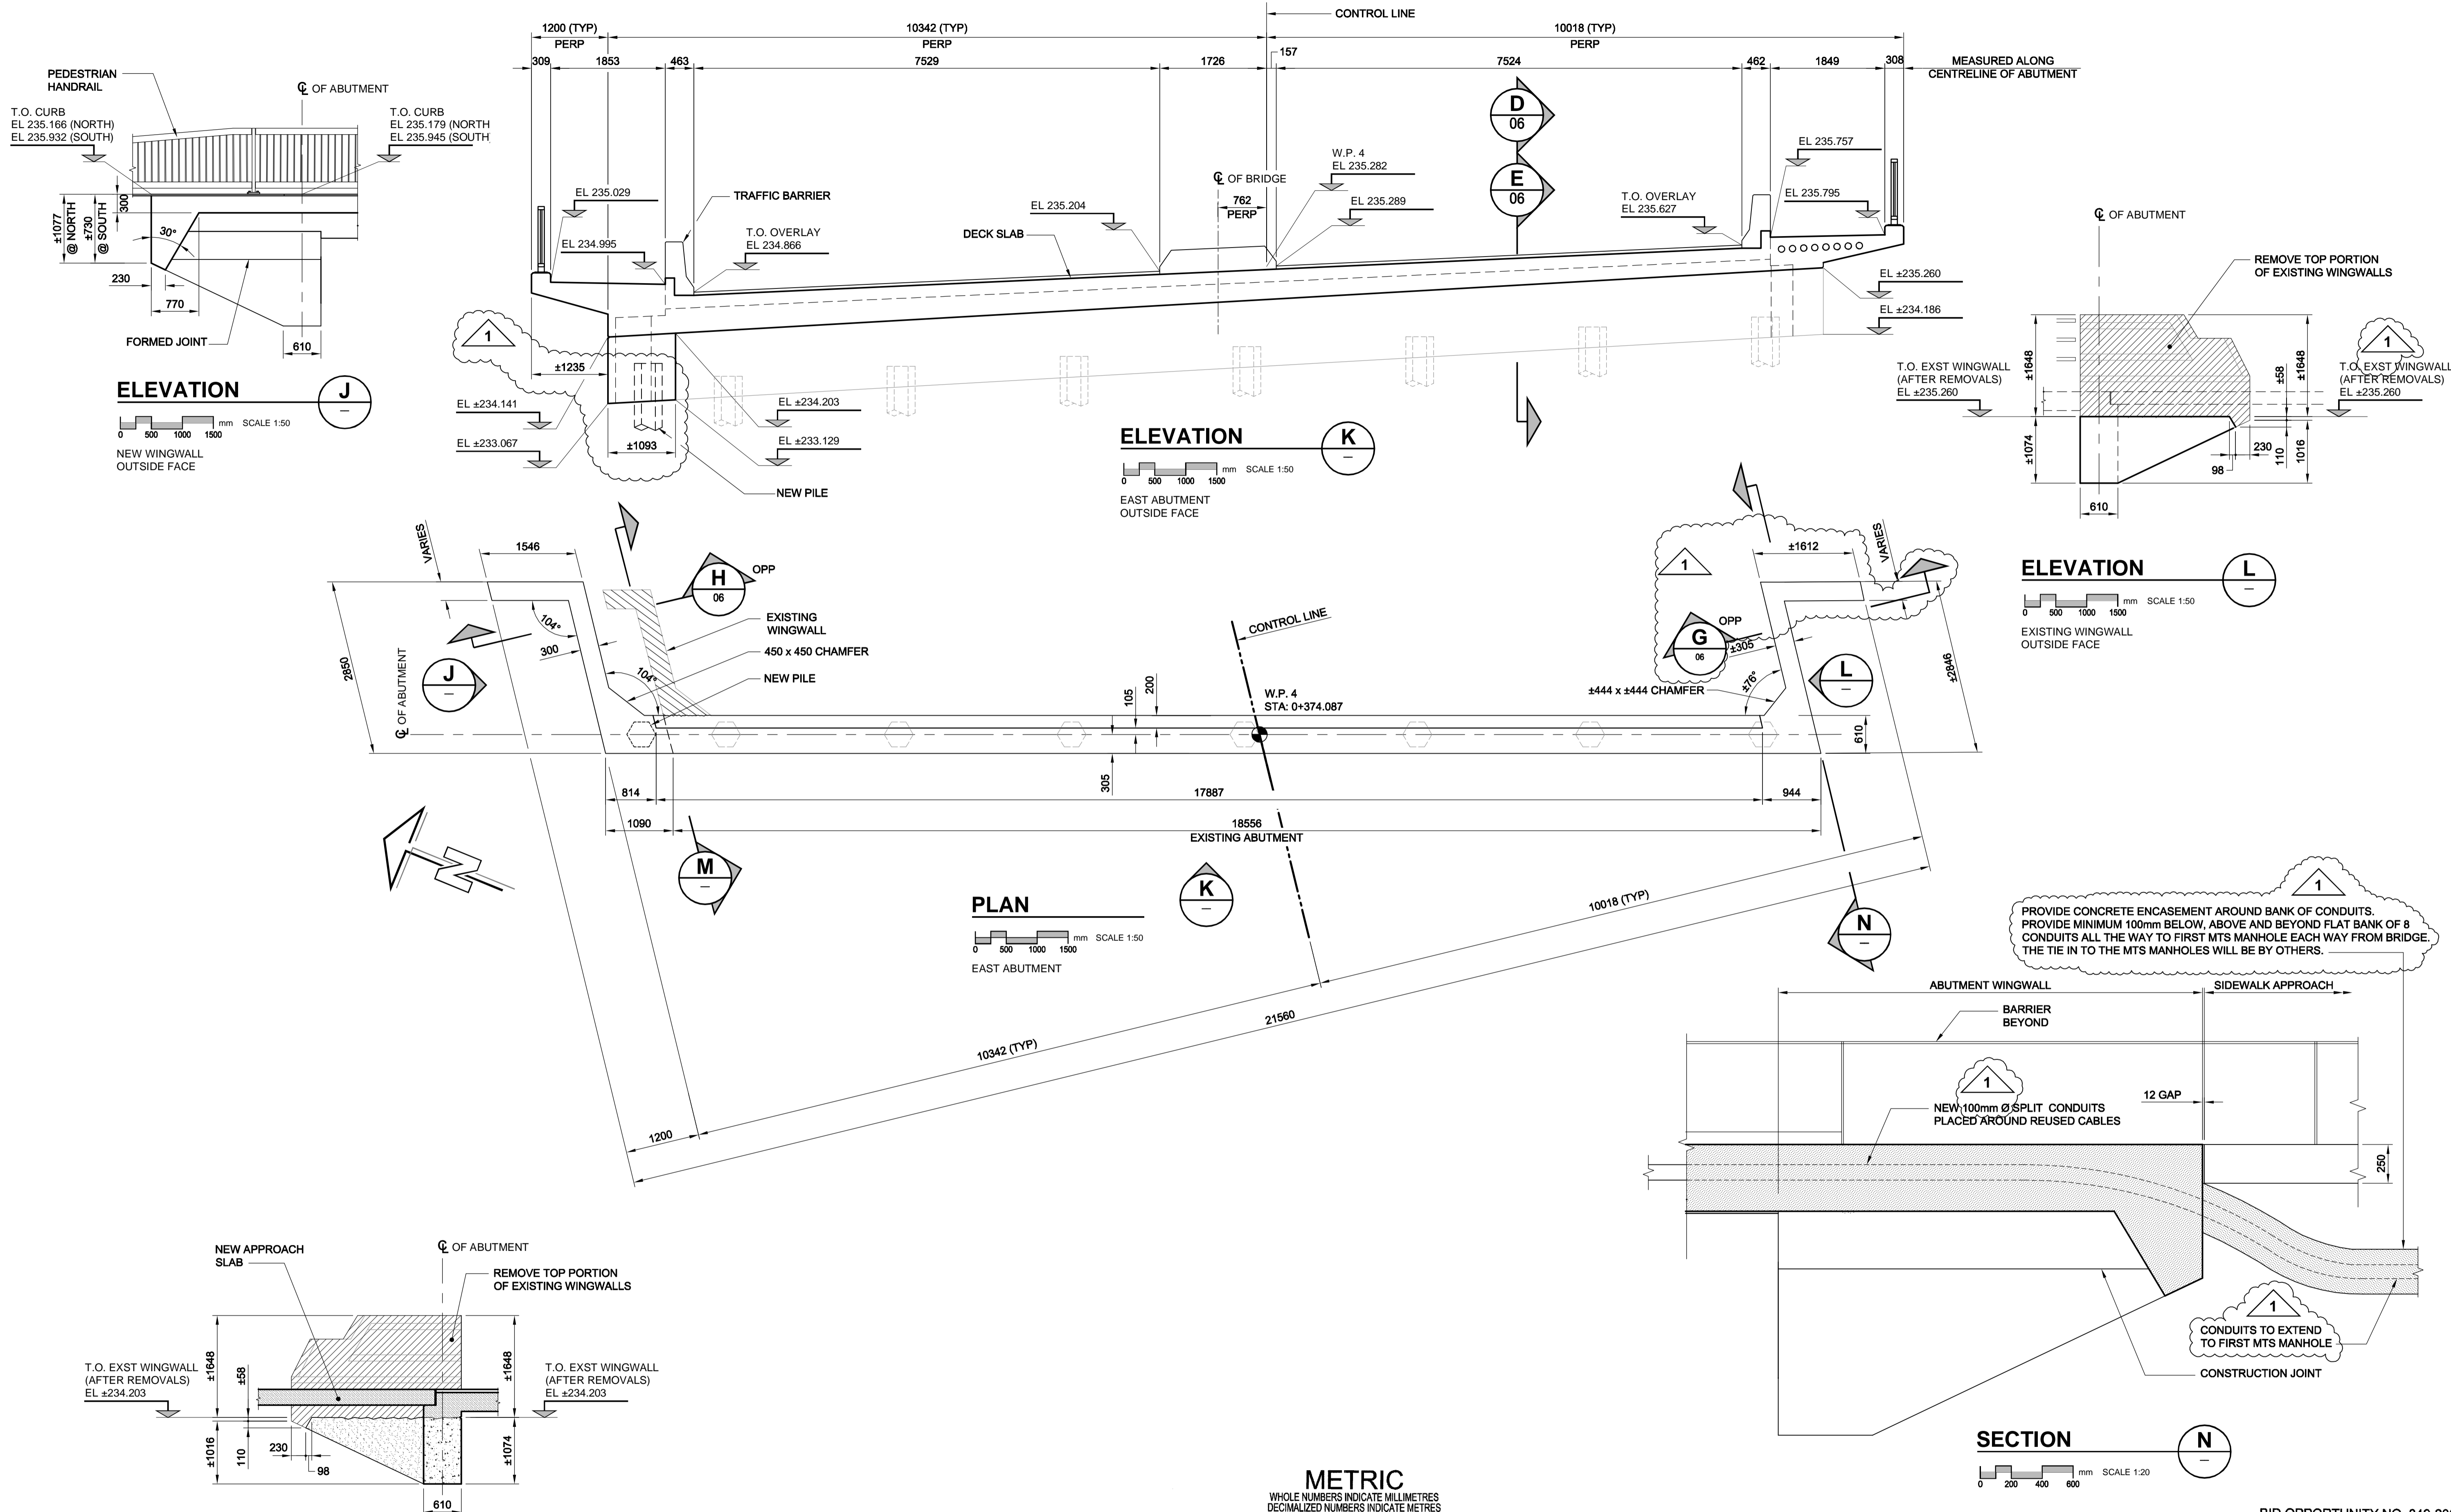

METRIC
WHOLE NUMBERS INDICATE MILLIMETRES
DECIMALIZED NUMBERS INDICATE METRES

BM 40-012 ELEV 238.149m			
DESIGNED BY BLL	CHECKED BY SBB		
DRAWN BY EDM	APPROVED BY <i>[Signature]</i>		
HOR. SCALE AS NOTED	RELEASED FOR CONSTRUCTION		
VERT. SCALE AS NOTED			
NO. REVISIONS	DATE	BY	
1	07/05/22	EDM	
0	07/05/10	DJH	
	YYMMDD		

UMA AECOM <small>© 2007 UMA ENGINEERING LTD. ALL RIGHTS RESERVED.</small>	
DESIGNED BY BLL	CHECKED BY SBB
DRAWN BY EDM	APPROVED BY <i>[Signature]</i>
HOR. SCALE AS NOTED	RELEASED FOR CONSTRUCTION
VERT. SCALE AS NOTED	
NO. REVISIONS	DATE
1	07/03/23

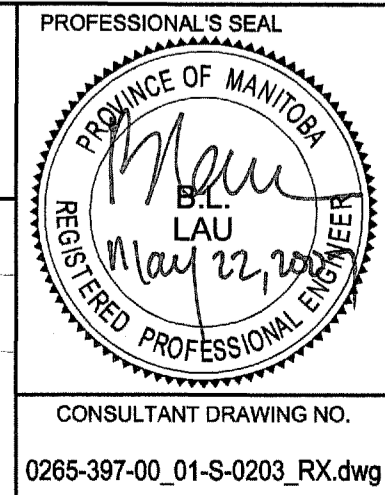

BID OPPORTUNITY NO. 349-2007

THE CITY OF WINNIPEG
 PUBLIC WORKS DEPARTMENT
 TRANSPORTATION ENGINEERING DIVISION

**HAMILTON AVENUE BRIDGE
 REHABILITATION
 EAST ABUTMENT CONCRETE DETAILS**

CITY DRAWING NUMBER B133-07-07	REV 1
SHEET 7 OF 30	
DRAWING No. 07	