


MAIN FLOOR PLAN - LIGHTING

0 1000 2000 3000 mm SCALE 1:100

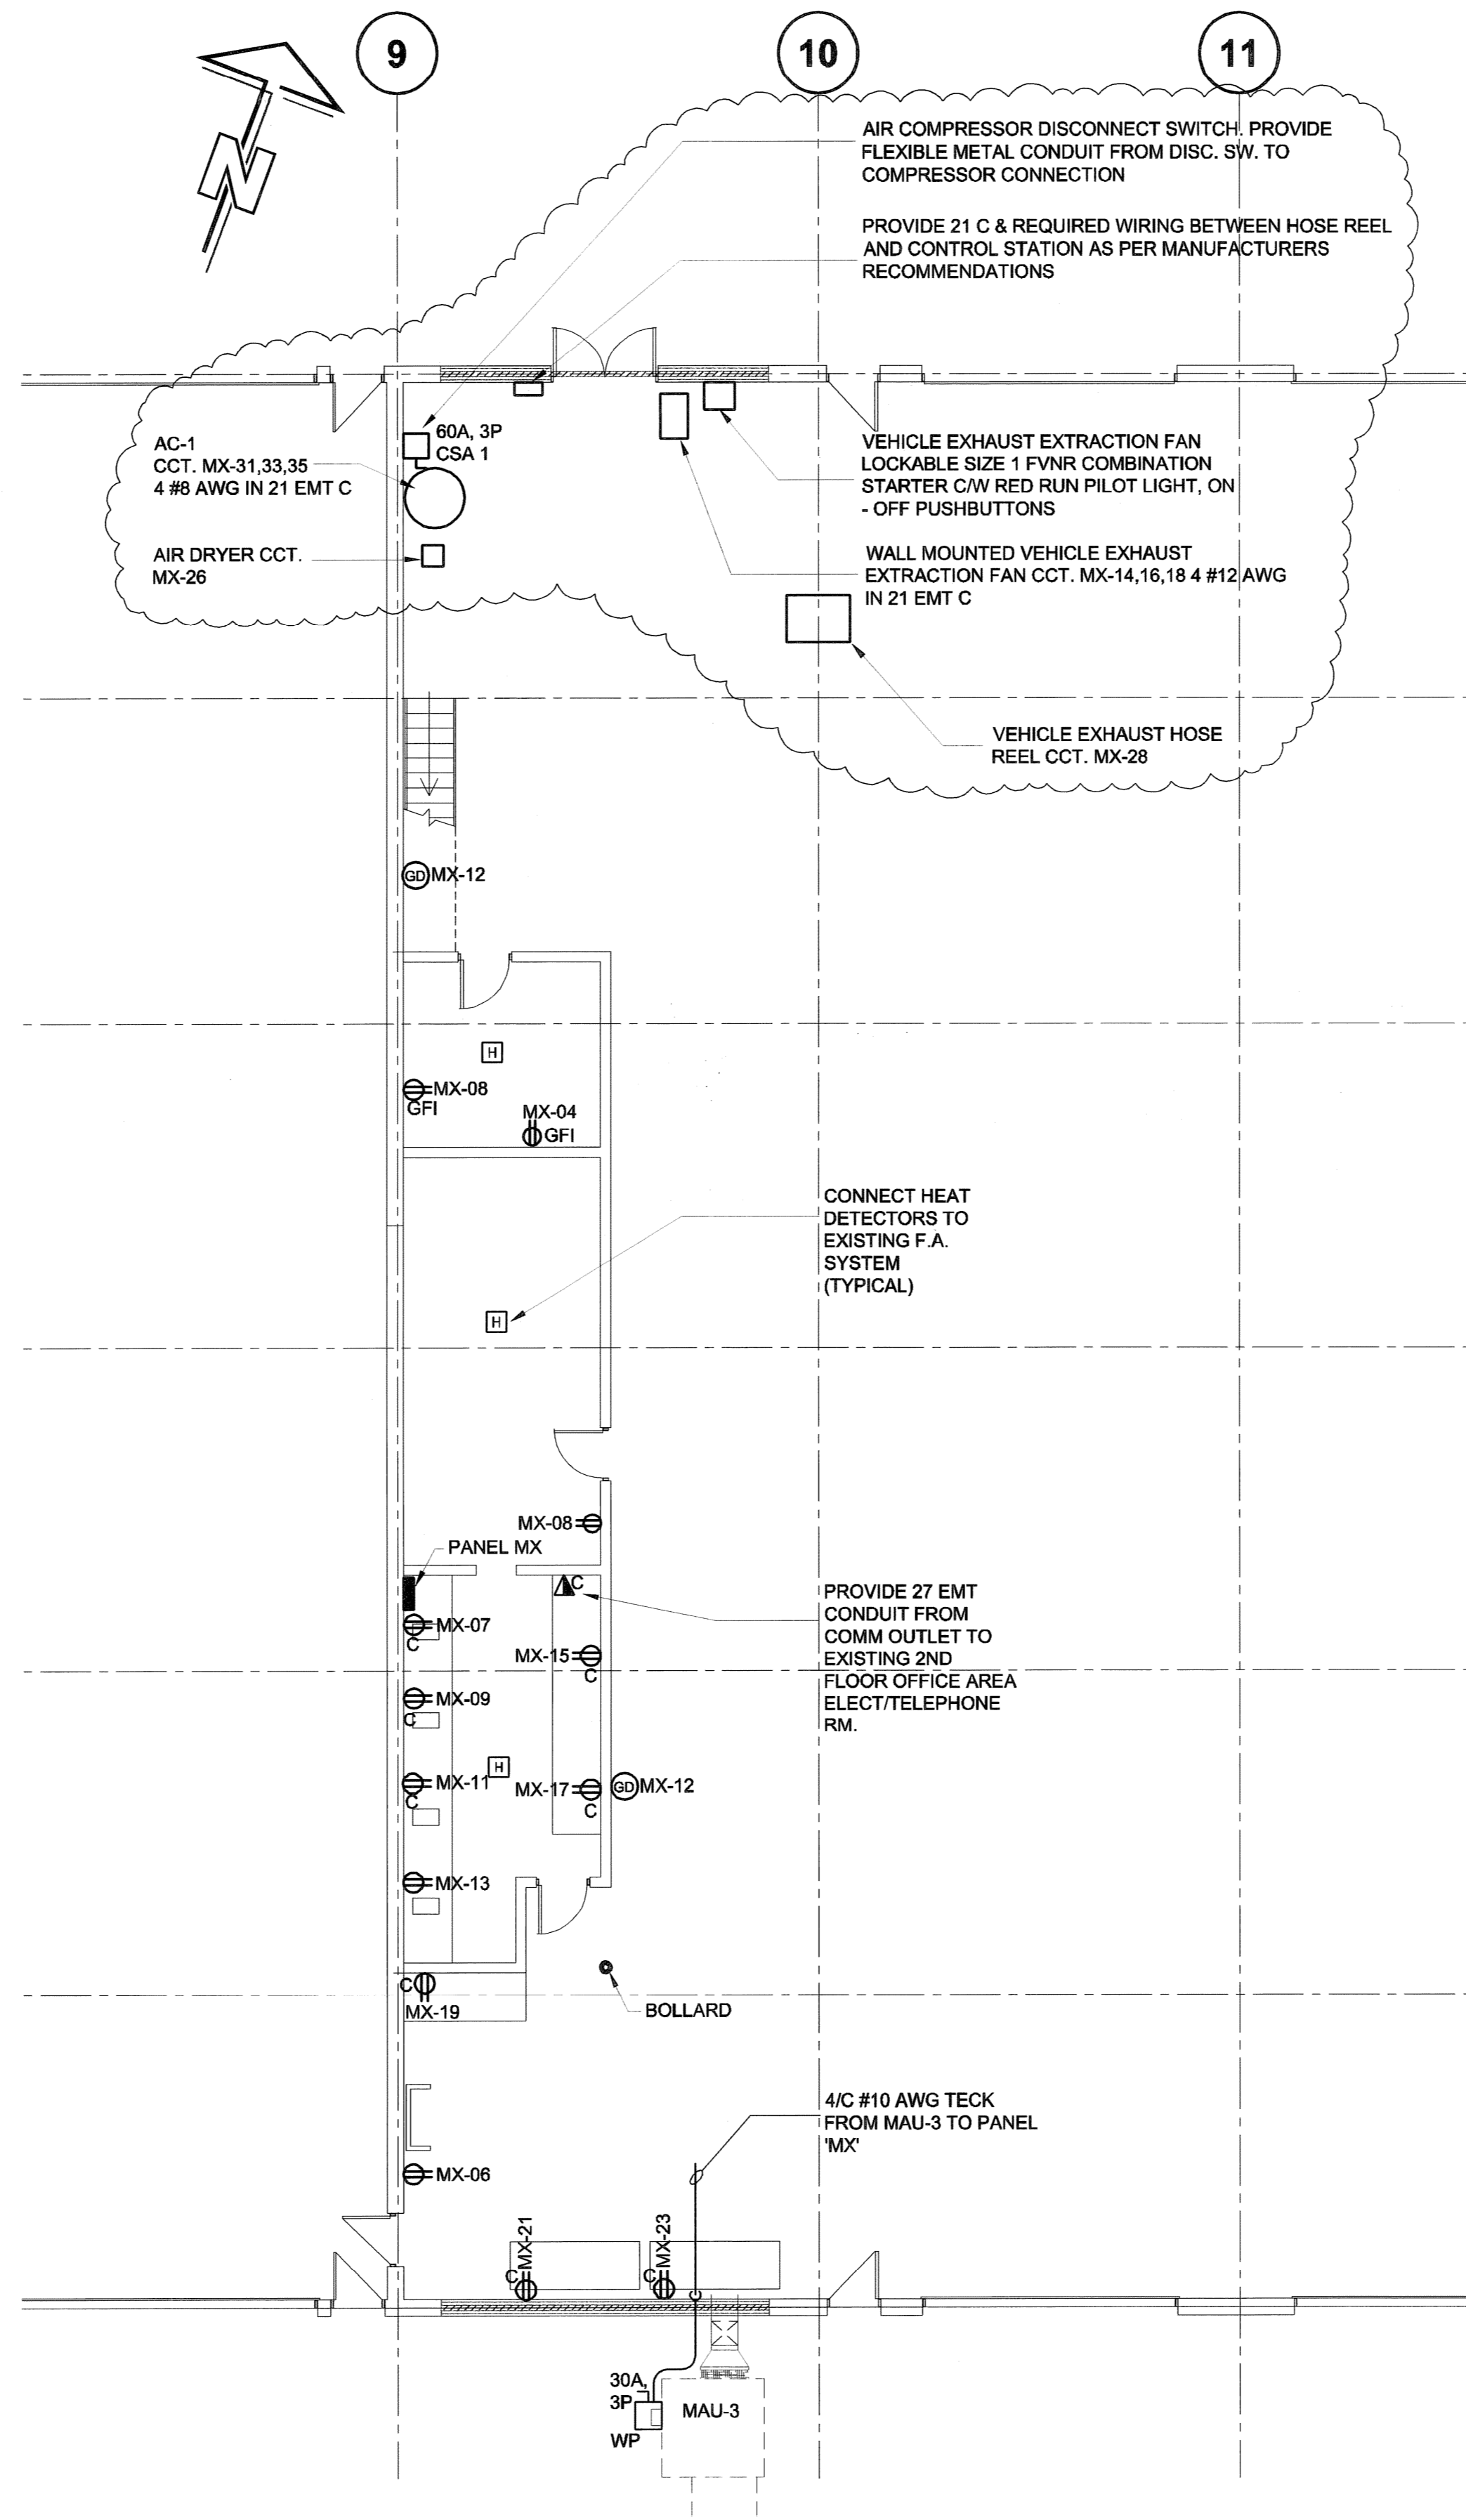

MAIN FLOOR PLAN - POWER

0 1000 2000 3000 mm SCALE 1:100


PANEL 'MX'									
CCT NO	DESCRIPTION	LOAD	TRIP AMPS	N	TRIP AMPS	LOAD	DESCRIPTION	CCT NO	
01	MEZZANINE FLUOR. LTG.		15		15		MEZZANINE RECEPT.	02	
03	WASHROOM & STORAGE RM. LTG		15		15		WASHER RECEPT.	04	
05	WORK BENCH FLUOR. LTG.		15		15		GARAGE RECEPT.	06	
07	WORKBENCH RECEPT.		15		15		WASH. RM. & STOR. RM. RECEPT	08	
09	WORKBENCH RECEPT.		15		15		METASYS CABINET	10	
11	WORKBENCH RECEPT.		15		15		CO & NO2 DETECTORS	12	
13	WORKBENCH RECEPT.		15		15			14	
15	WORKBENCH RECEPT.		15		15		VEHICLE EXHAUST EXTRACTION FAN	16	
17	WORKBENCH RECEPT.		15		3P		1 1/2 HP	18	
19	GARAGE WORKBENCH RECEPT.		15					20	
21	GARAGE WORKBENCH RECEPT.		15				MAU-3	22	
23	GARAGE WORKBENCH RECEPT.		15		3P			24	
25					15		AIR DRYER	26	
27	EF-1		25		15		EXHAUST HOSE REEL	28	
29			3P		15		SPARE	30	
31							SPARE	32	
33	AC-1 AIR COMPRESSOR		40				SPARE	34	
35	5 HP		3P				SPARE	36	
37							SPARE	38	
39	SPARE		25				SPARE	40	
41			3P				SPARE	42	

VOLTAGE: 120/208V PHASE: 3 WIRE: 4 BREAKER I.C.: 10kA  
 MAIN BREAKER: - MAINS: 225A FEEDER: 4 - 250 MCM R90 IN 78 C  
 MOUNTING: SURFACE LOCATION: GARAGE  
 FED FROM: MAIN 2000A DISTRIBUTION  
 NOTES: PANEL ENCLURE TO BE NEMA 12



E	ISSUED FOR ADDENDUM No.1	SCK	07/11/14
D	ISSUED FOR TENDER	SCK	07/11/10
C	ISSUED FOR FINAL REVIEW	SCK	07/10/19
B	ISSUED FOR 100% REVIEW	SCK	07/06/12
A	ISSUED FOR CLIENT REVIEW	QL	07/06/17
NO.	REVISION/DESCRIPTION	BY	DATE

SEALS


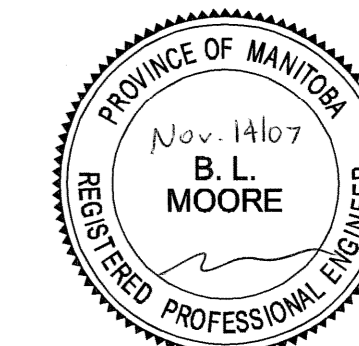


DRAWN BY SCK CHECKED BY - APPROVED -  
DATE 2007.05.08 USER APPROVAL

CITY OF WINNIPEG  
PLANNING, PROPERTY & DEVELOPMENT DEPARTMENT  
CIVIC ACCOMMODATIONS DIVISION  
300 - 65 GARRY ST. R3C 4K4

PROJECT  
CONSTRUCTION OF OFFICE/GARAGE  
RENOVATIONS & STORAGE BUILDING  
AT 1539 WAVERLEY STREET  
1539 Waverley Street, Winnipeg, MB.

SHEET TITLE  
ELECTRICAL  
GARAGE MAIN FLOOR  
LIGHTING AND POWER

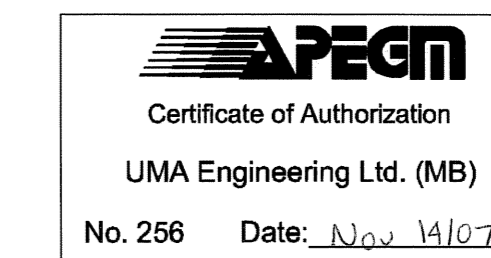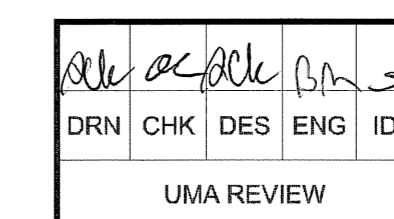

SCALE 1:500 PROJECT NO. 0265-395-02 SHEET NO. GAR-E1.1