DESCRIPTION: Basement Floor New Construction DATE: 2007.02.21 FILE NAME: F953-001-01_01-M-2001_RX.dwg

PROJECT No: F953-001-01

ADDRESS: 999 Sargent St. Winnipeg, Manitoba PLOT: 07/08/22 2:38:21 PM

UMA FILE NAME: F953-001-01_01-M-2001_RX.dwg

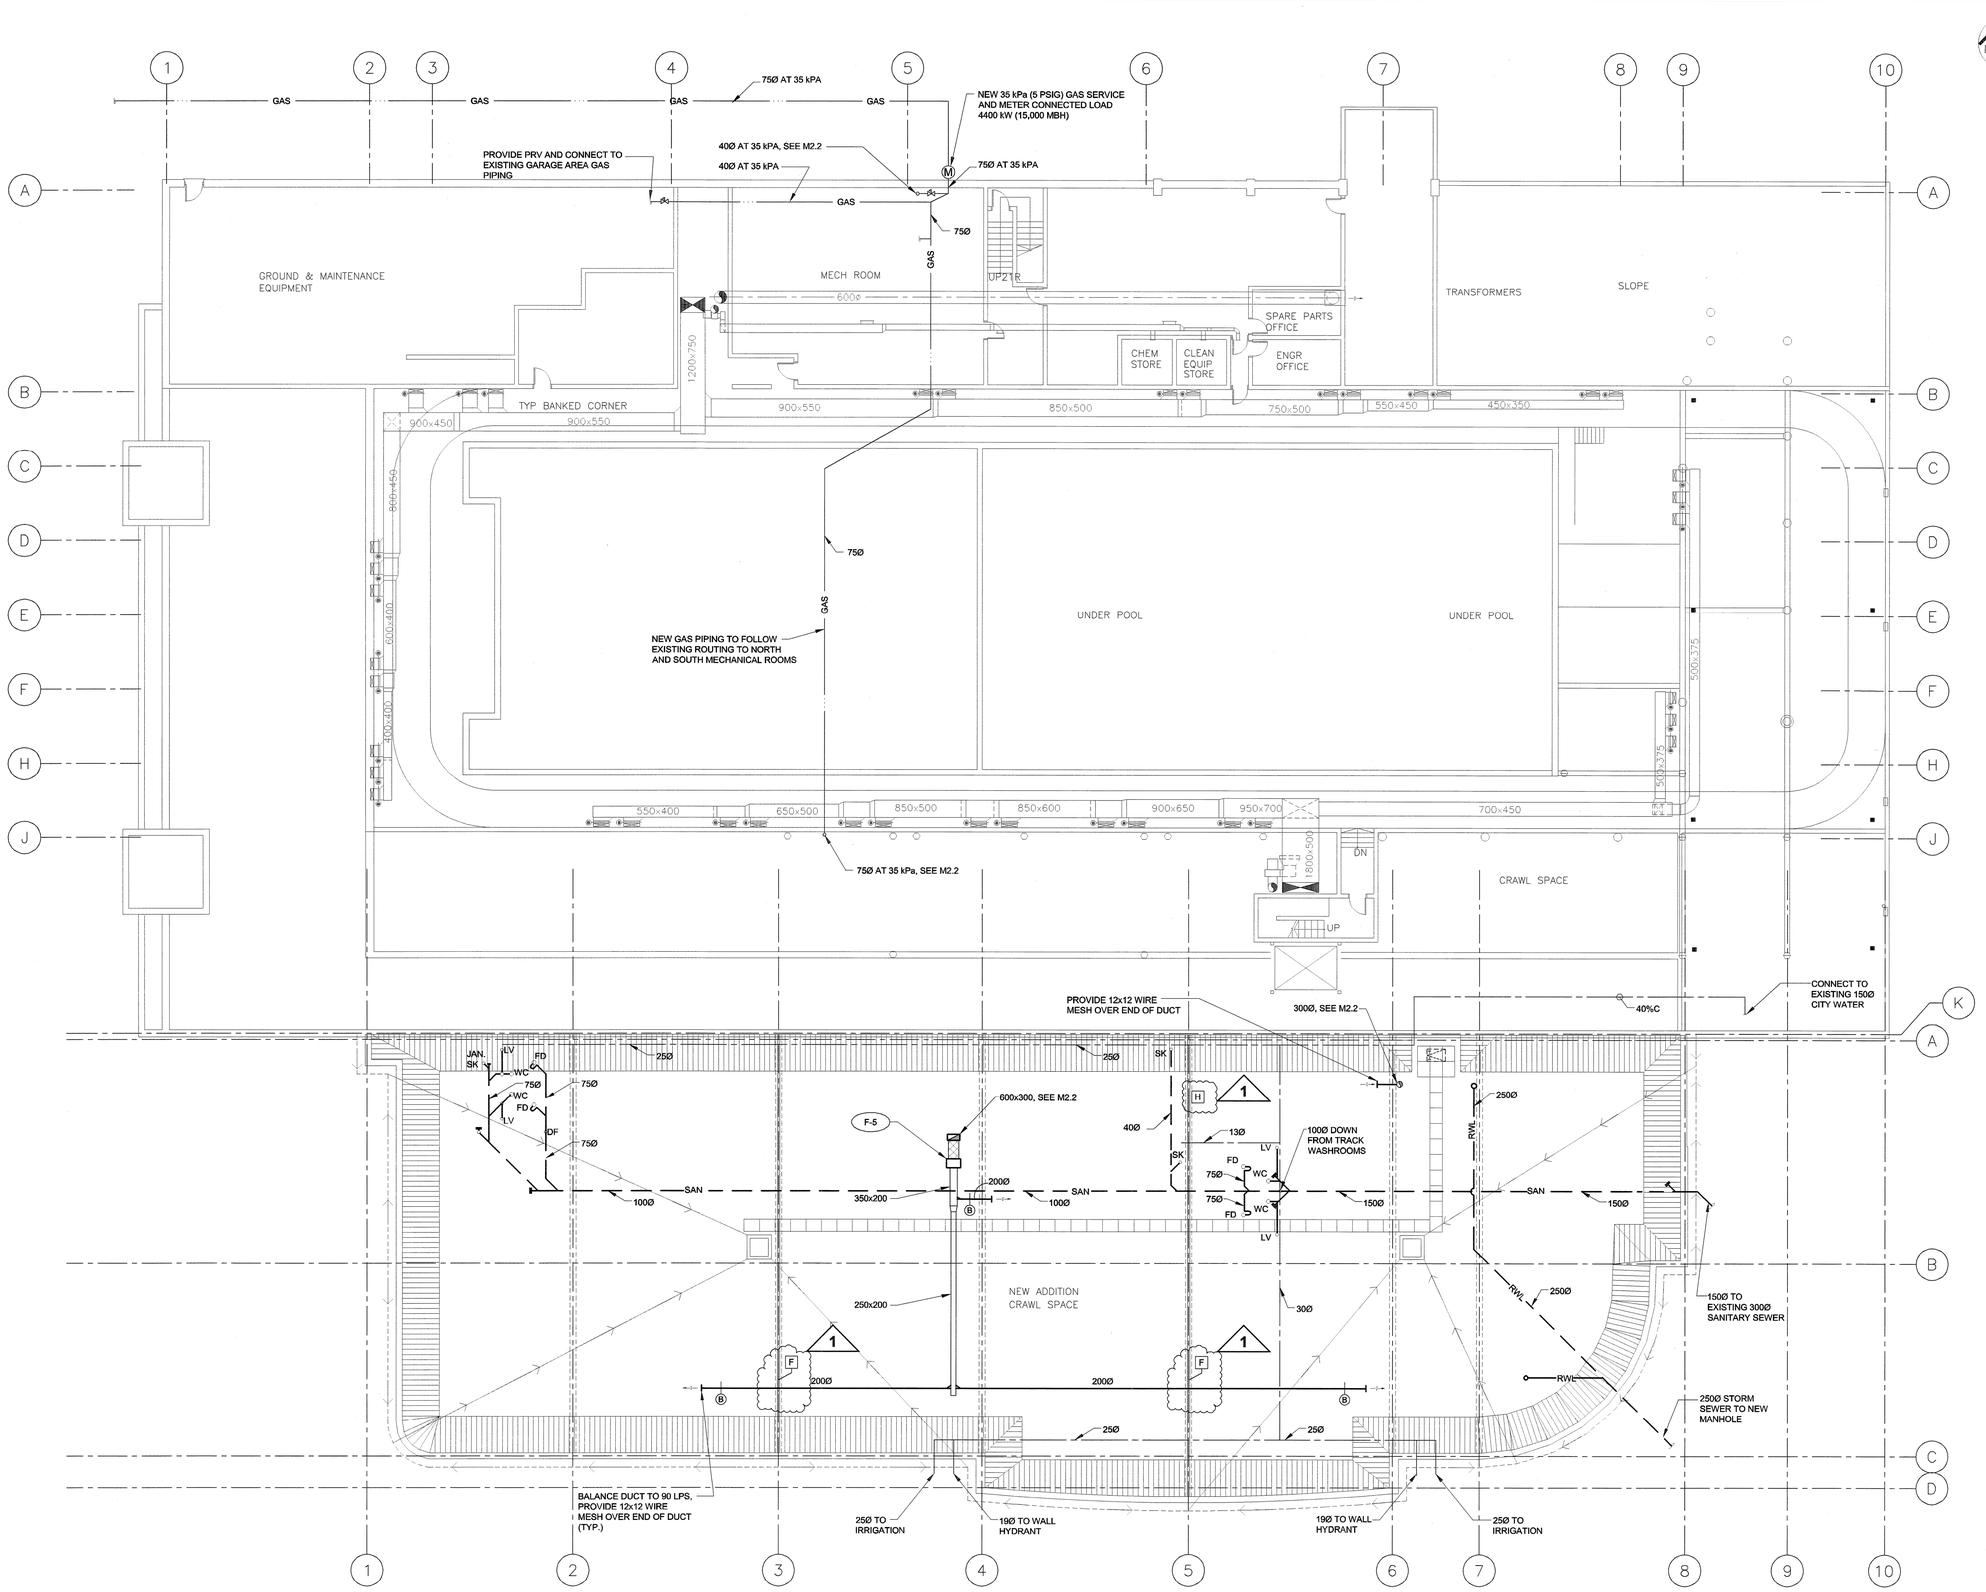


## PLAN 1

M2.1

0 1500 3000 4500 mm SCALE 1:150

BASEMENT FLOOR AND CRAWL SPACE PLAN NEW CONSTRUCTION

UMA | AECOM

© 2007 UMA ENGINEERING LTD. ALL RIGHTS RESERVED.

APEGM Certificate of Authorization
UMA Engineering Ltd. (MB)
No. 256 Date: 07/08/22

| DRN | CHK | DES | ENG | IDR |
|---|---|---|---|---|
| | AG | CC | | |

UMA | AECOM REVIEW

| NO. | REVISION/DESCRIPTION | BY | DATE |
|---|---|---|---|
| 1 | ISSUED FOR ADDENDUM #2 | RJP | 07/08/21 |
| 0 | ISSUED FOR TENDER | RJP | 07/07/23 |

SEALS

PROVINCE OF MANITOBA — AUG 22 2007 — BRIAN PETERSON — REGISTERED PROFESSIONAL ENGINEER

| DRAWN BY | RJP | CHECKED BY | APPROVED |
|---|---|---|---|
| DATE | 2007.07.17 | USER APPROVAL | |

CITY OF WINNIPEG
PLANNING, PROPERTY & DEVELOPMENT DEPARTMENT
CIVIC ACCOMMODATIONS DIVISION
300 – 65 GARRY ST. R3C 4K4

PROJECT

Construction of Cindy Klassen Recreation Complex Facility Enhancement Project

999 Sargent St. Winnipeg, Manitoba

SHEET TITLE

Mechanical
Basement Floor And Crawl Space PLan
New Construction

| SCALE | PROJECT NO. | SHEET NO. |
|---|---|---|
| 1:150 | 2005-059 | M2.1 |

DRAWING SHEET SIZE: A1 (841mm x 594mm) PLOT 1:1