


UMA FILE NAME: F983-001-01\_01-H-2005\_RX.dwg  
 DATE: 2007.02.21  
 DESCRIPTION: Main Floor New Construction  
 PROJECT No: F983-001-01  
 ADDRESS: 999 Sargent St. Winnipeg, Manitoba  
 PLOT: 07/08/22 2:36:45 PM

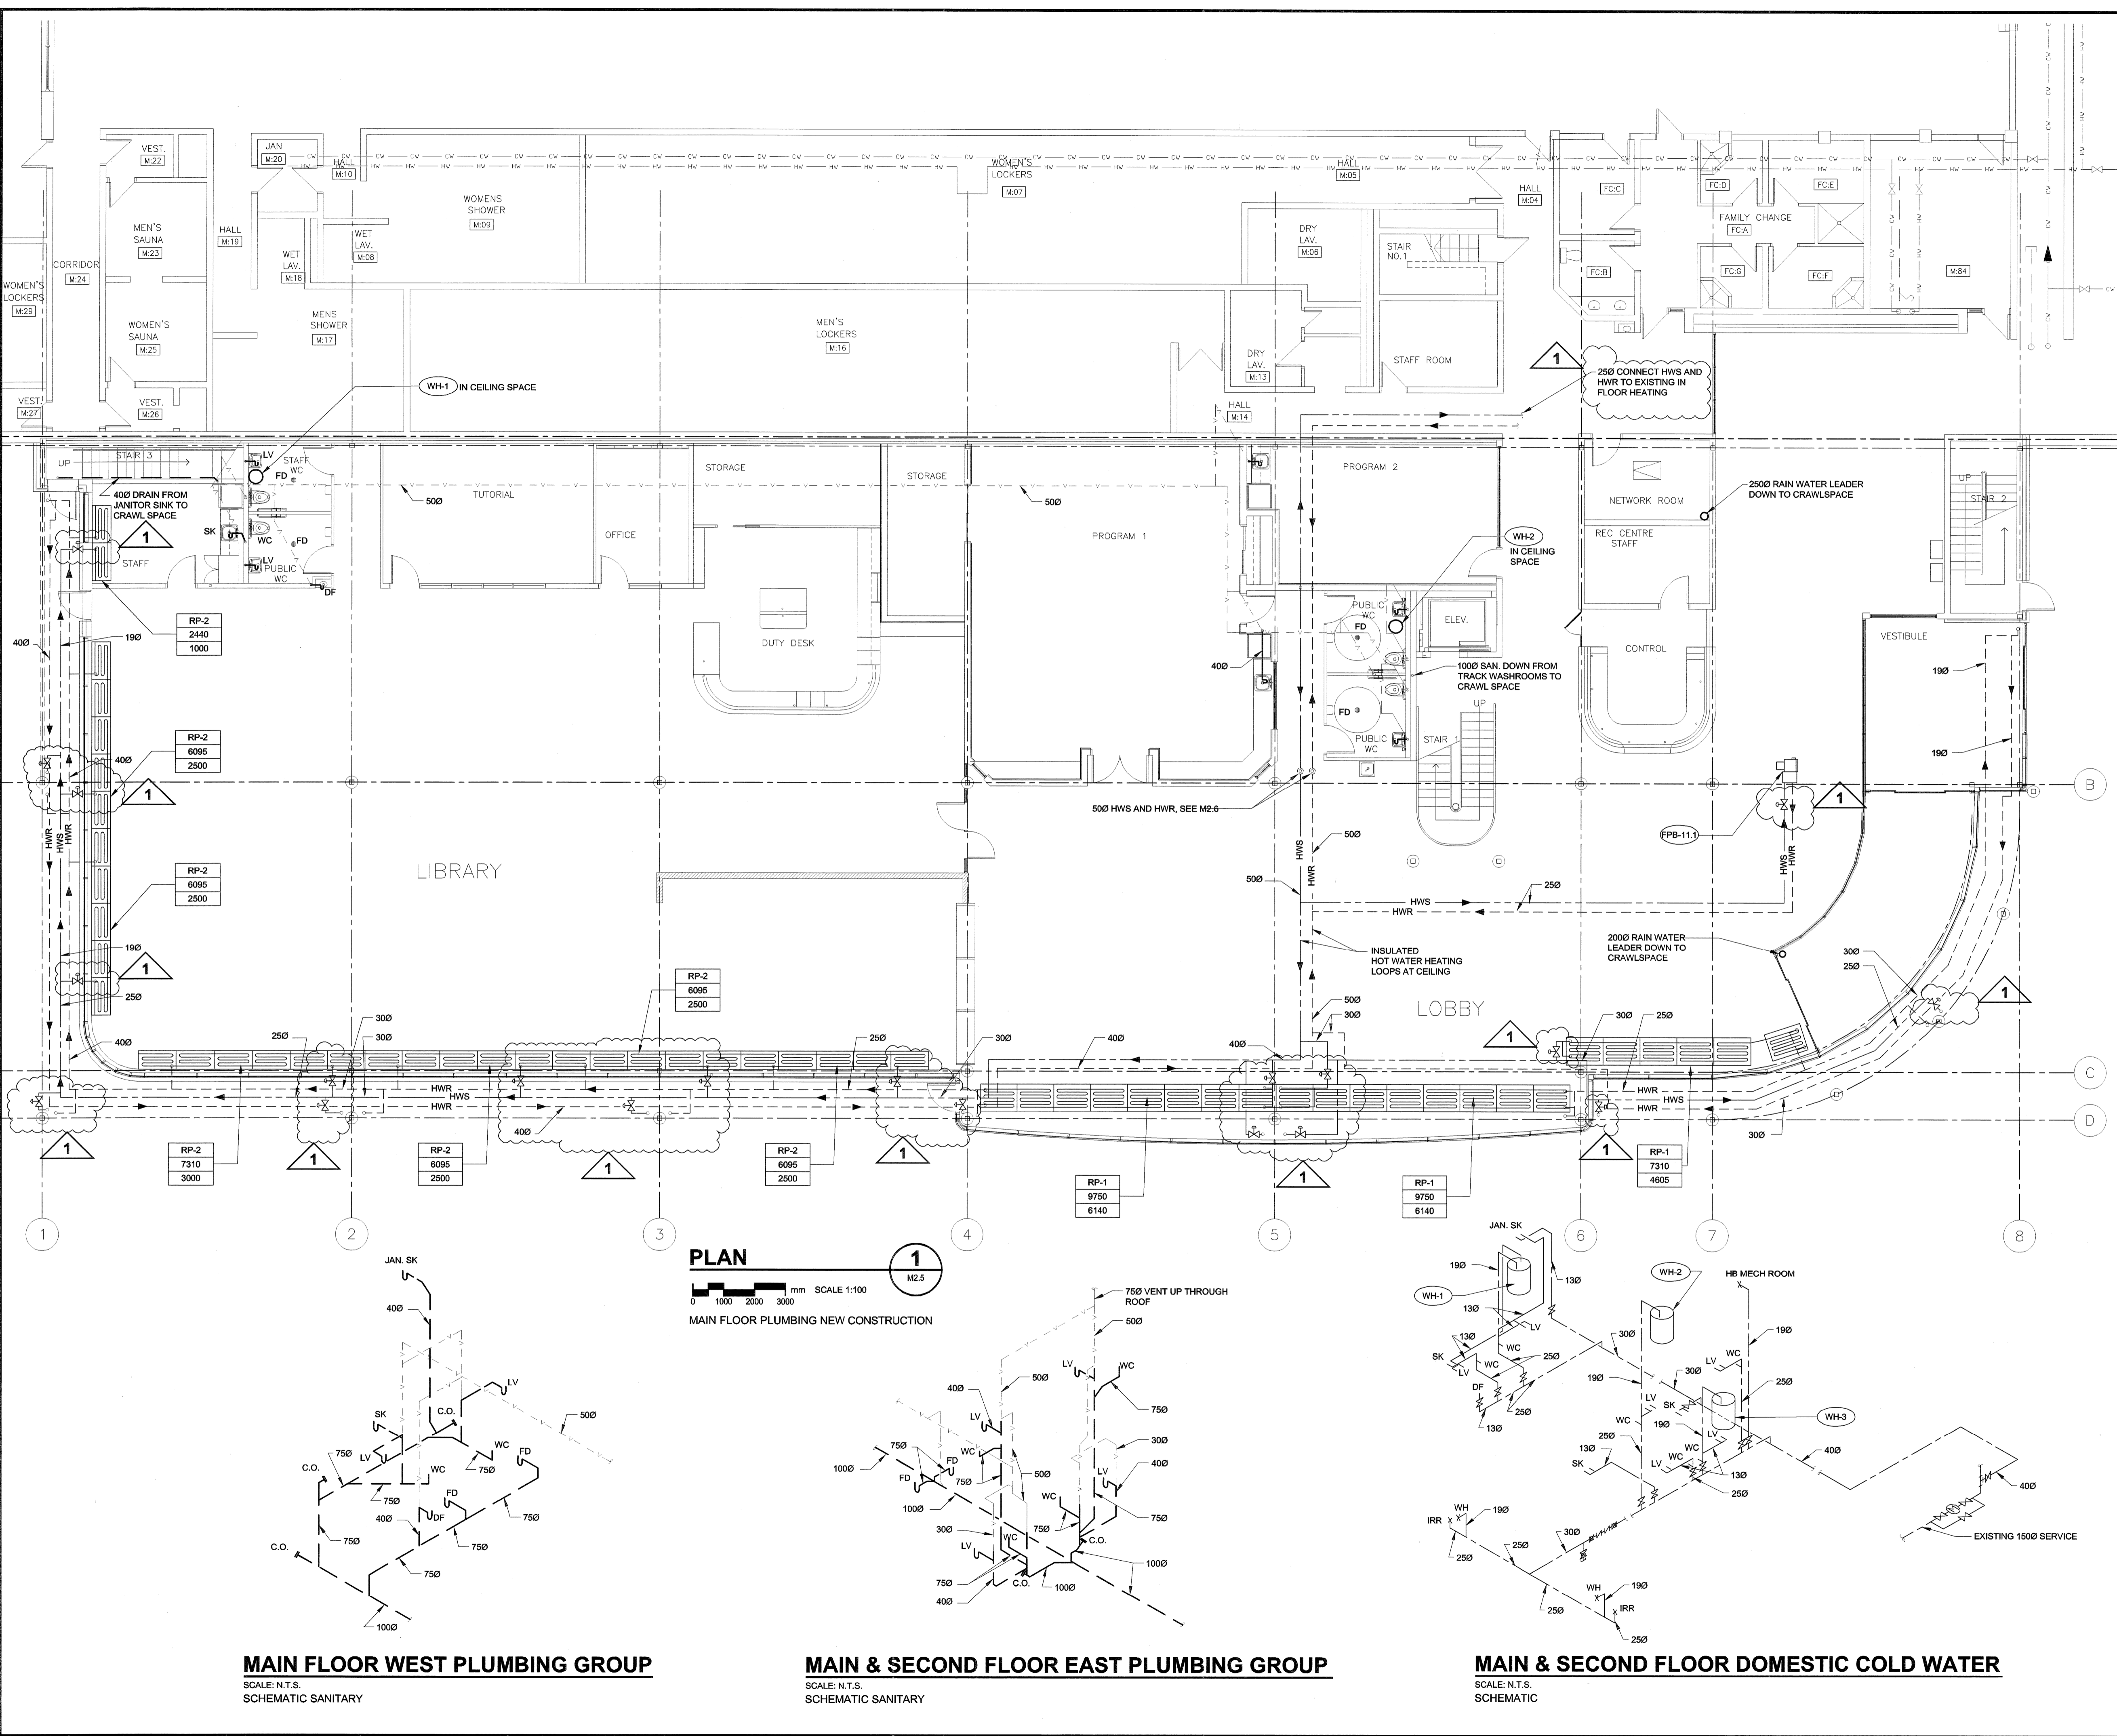

**PLAN**  
 SCALE: 1:100  
 MAIN FLOOR PLUMBING NEW CONSTRUCTION

**MAIN FLOOR WEST PLUMBING GROUP**  
 SCALE: N.T.S.  
 SCHEMATIC SANITARY

**MAIN & SECOND FLOOR EAST PLUMBING GROUP**  
 SCALE: N.T.S.  
 SCHEMATIC SANITARY

**MAIN & SECOND FLOOR DOMESTIC COLD WATER**  
 SCALE: N.T.S.  
 SCHEMATIC

UMA | AECOM  
 © 2007 UMA ENGINEERING LTD. ALL RIGHTS RESERVED.

**APEGM**  
 Certificate of Authorization  
 UMA Engineering Ltd. (MB)  
 No. 256 Date: 01/06/2007

DRN CHK DES ENG IDR  
 UMA | AECOM REVIEW

NO.	REVISION/DESCRIPTION	BY	DATE
1	ISSUED FOR ADDENDUM #2	RJP	07/08/21
0	ISSUED FOR TENDER	RJP	07/07/23

DRAWN BY: RJP CHECKED BY: USER APPROVAL DATE: 2007.07.17 APPROVED: [Signature]

CITY OF WINNIPEG  
 PLANNING, PROPERTY & DEVELOPMENT DEPARTMENT  
 CIVIC ACCOMMODATIONS DIVISION  
 300 - 65 GARRY ST. R3C 4K4

PROJECT: Construction of Cindy Klassen Recreation Complex Facility Enhancement Project  
 999 Sargent St. Winnipeg, Manitoba

SHEET TITLE: Mechanical Main Floor Plumbing & Piping New Construction

SCALE: 1:100 PROJECT NO: 2005-059 SHEET NO: M2.5  
 DRAWING SHEET SIZE: A1 (841mm x 594mm) PLOT 1:1