


UMA FILE NAME: F563-001-01-14-2006\_RX.dwg  
 DATE: 2007.02.21  
 FILE NAME: F563-001-01-14-2006\_RX.dwg  
 DESCRIPTION: Second Floor New Construction  
 PROJECT No: F563-001-01  
 ADDRESS: 999 Sargent St. Winnipeg, Manitoba  
 PLOT: 07/06/22 2:36:04 PM

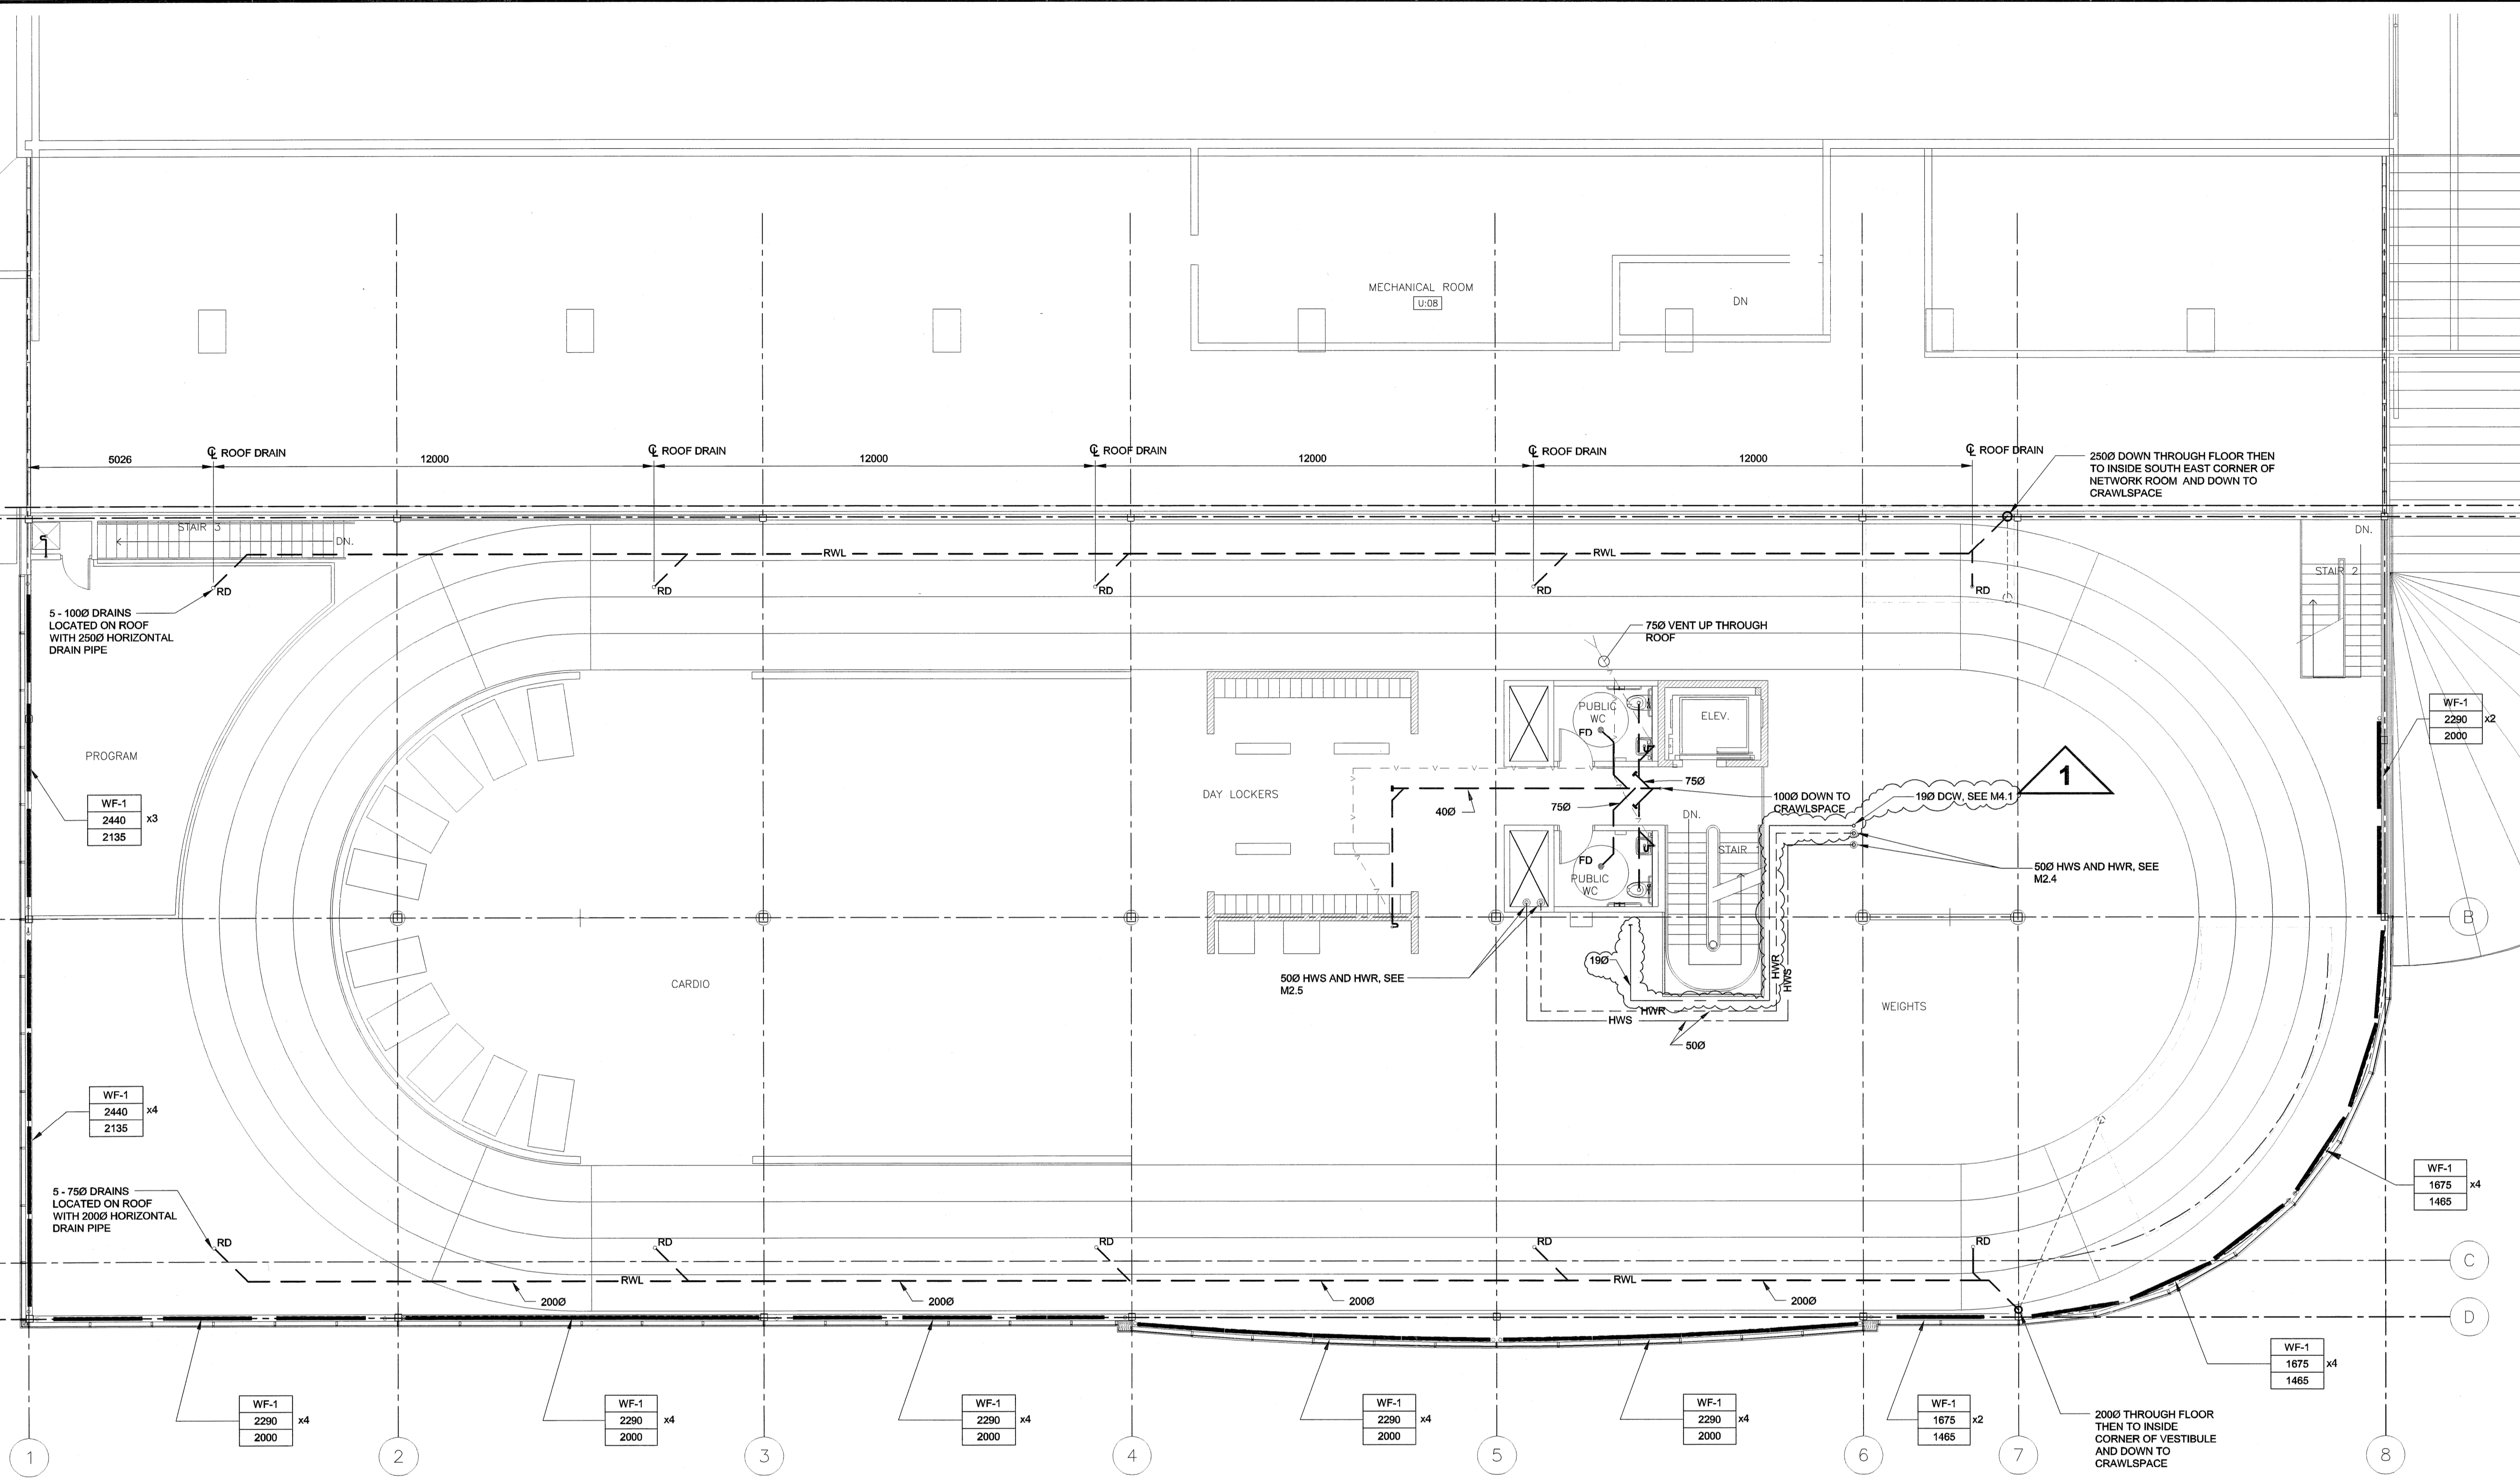

**PLAN**  
 SCALE 1:100  
 SECOND FLOOR PLUMBING NEW CONSTRUCTION  
**1**  
 M2.6

**UMA | AECOM**  
 © 2007 UMA ENGINEERING LTD. ALL RIGHTS RESERVED.

**APECM**  
 Certificate of Authorization  
 UMA Engineering Ltd. (MB)  
 No. 256 Date: *07/07/23*

*M. J. PETERSON*  
 DRN CHK DES ENG IDR  
 UMA | AECOM REVIEW

NO.	REVISION/DESCRIPTION	BY	DATE
1	ISSUED FOR ADDENDUM #2	RJP	07/08/21
0	ISSUED FOR TENDER	RJP	07/07/23

SEALS

**PROVINCE OF MANITOBA**  
*Reg 22, 2007*  
**B.M. PETERSON**  
 REGISTERED PROFESSIONAL ENGINEER

DRAWN BY: RJP CHECKED BY: USER APPROVAL APPROVED  
 DATE: 2007.07.17

**CITY OF WINNIPEG**  
 PLANNING, PROPERTY & DEVELOPMENT DEPARTMENT  
 CIVIC ACCOMMODATIONS DIVISION  
 300 - 65 GARRY ST. R3C 4K4

PROJECT  
**Construction of Cindy Klassen Recreation Complex Facility Enhancement Project**  
 999 Sargent St. Winnipeg, Manitoba

SHEET TITLE  
**Mechanical  
 Second Floor Plumbing And Piping  
 New Construction**

SCALE	PROJECT NO.	SHEET NO.
1:100	2005-059	<b>M2.6</b>

DRAWING SHEET SIZE: A1 (841mm x 594mm) PLOT 1:1