ADDRESS: 999 Sargent Ave, Winnipeg, MB PROJECT No: 06024 DATE: 2007 June 12 DESCRIPTION: ROOM FINISH AND DOOR SCHEDULES FILE NAME: 06024-A8.1(dwg)A8.1

FINISH SCHEDULE

ROOM NO	ROOM NAME	FLOOR: FLOORING MAT	FLOOR: FLOORING COLOUR	FLOOR: BASE MAT	FLOOR: BASE COLOUR	WALLS: NORTH MAT	WALLS: NORTH FINISH	WALLS: NORTH COLOUR	WALLS: EAST MAT	WALLS: EAST FINISH	WALLS: EAST COLOUR	WALLS: SOUTH MAT	WALLS: SOUTH FINISH	WALLS: SOUTH COLOUR	WALLS: WEST MAT	WALLS: WEST FINISH	WALLS: WEST COLOUR	CEILING MAT	CEILING FINISH	CEILING COLOUR	CEILING HGT AFF	COMMENTS
101	VESTIBULE	RU	TYPE 1			CL/BR	–	–	GL	–	–	GL	–	–	GL	X	X	ALUM	X	X	2700	
102	ENTRY	RU	TYPE 1			GL	–	–	GL	–	–	GL	–	–	GL	X	X	ALUM	X	X	2700	
103	LOBBY	CT	TYPE 1	CMU	CHAR	CMU	SEAL	CLEAR	CMU/GL	PT	1	GL	X	X	CMU/GL/GWB	X	1	OPEN	K-13	X	3900	OPEN TO COATED DECK. SEE PLAN FOR TILE PATTERN AND OTHER COLORS
104	LOBBY	CT	TYPE 1	CMU	CHAR	CMU/GWB	SEAL/PT	1	CMU/GL	SEAL	CL/1	GL	X	X	CMU/GL	SEAL	CL/1	OPEN	K-13	X	3900	OPEN TO COATED DECK.
105	CORRIDOR	CT	TYPE 1	CMU	CHAR	CMU	SEAL	CLEAR	GWB	PT	1				CMU/GL	SEAL	CLEAR					
106	CORRIDOR	CT	TYPE 1	CMU	CHAR	X	X	X	CMU	SEAL	CLEAR	X	X	X	CMU/GL	SEAL	CLEAR					
107	CORRIDOR	CT	TYPE 1			EXIST	EXIST	EXIST	EXIST	EXIST	EXIST	EXIST	EXIST	EXIST	EXIST	EXIST	EXIST					
108	CORRIDOR	CT	TYPE 1			EXIST	EXIST	9	EXIST	EXIST	9	EXIST	EXIST	9	EXIST	EXIST	9					
109	PROGRAM 1	CP	TYPE 2	CP	TYPE 2	GWB	PT	2	CMU	PT	2	CMU	PT	2	CMU	PT	2	ACT	X	X	3000	SEE PLAN FOR MILLWORK AND GLAZING LOCATION IN ROOM
110	STORAGE	CP	TYPE 2	CP	TYPE 2	CMU	SEAL	CLEAR	CMU	SEAL	CLEAR	CMU	SEAL	CLEAR	CMU	SEAL	CLEAR	GWB	PT	X	X	
111	PROGRAM 2	CP	TYPE 2	CP	TYPE 2	GWB	PT	3	GL			CMU	PT	3	CMU	PT	3	ACT	X	X	2200	
112	PUBLIC WC	CT	TYPE 1	CT	TYPE 5	CT	TYPE 5		CT	TYPE 5		CT	TYPE 5		CT	TYPE 5		ACT	X	X	2200	
113	PUBLIC WC	CT	TYPE 1	CT	TYPE 5	CT	TYPE 5		CT	TYPE 5		CT	TYPE 5		CT	TYPE 5		ACT	X	X	2200	
114	NETWORK	RU	TYPE 1	RCB	2	CMU	SEAL	CL	CMU	SEAL	CL	CMU	SEAL	CL	CMU	SEAL	CL	OPEN	PT	X	3900	OPEN TO DECK
115	REC CENTRE STAFF	RU	TYPE 1	RCB	2	CMU	SEAL	CLEAR	CMU	SEAL	CLEAR	CMU	SEAL	CLEAR	CMU	SEAL	CLEAR	ACT	X	X	2200	
116	CONTROL	RU	TYPE 1	STAINLESS	2	CMU	SEAL	CLEAR										ACT	X	X	3000	SEE DETAILS FOR BULKHEAD AND MILLWORK
117	LIBRARY	CPT/TILE	TYPE 1	CMU	CHAR	GWB/WD	STAIN	SAMPLE	CMU/WALL			CMU/GL			CMU/GL			ACT	X	X	VARIES	SEE FINISH PLAN FOR FLOORING AREA, WALL TYPES FOR DETAILS AND FINISHES
118	DUTY DESK	RU	TYPE 1	RCB	2	GWB	PT	4	GWB	PT	4				GWB	PT	4	GWB	PT	X	X	
119	STORAGE	RU	TYPE 1	RCB	2	GWB	PT	5	GWB	PT	5	GWB	PT	5	GWB	PT	5	GWB	PT	X	X	
120	OFFICE	CPT	TYPE 1	CPT	TYPE 1	GWB	PT	6	GWB	PT	6	GWB	PT	6	GWB	PT	6	ACT	X	X	2200	
121	TUTORIAL	CPT	TYPE 1	CPT	TYPE 1	GWB	PT	7	GWB	PT	7	GWB	PT	7	GWB	PT	7	ACT	X	X	2200	
122	CORRIDOR	CT	TYPE 2	CT	TYPE 2	GWB	PT	7	GWB	PT	7				GWB	PT	7					
123	PUBLIC WC	CT	TYPE 2	CT	TYPE 5	CT	TYPE 5		CT	TYPE 5		CT	TYPE 5		CT	TYPE 5		ACT	X	X	2200	
124	STAFF WC	CT	TYPE 2	CT	TYPE 5	CT	TYPE 5		CT	TYPE 5		CT	TYPE 5		CT	TYPE 5		ACT	X	X	2200	
125	STAFF	RU	TYPE 1	RCB	1	GWB	PT	8	GWB	PT	8	GWB	PT	8	GWB	PT	8	ACT	X	X	2200	
	STR NO.1	RU	TYPE 1			EXIST	PT	X	EXIST	PT	X	EXIST	PT	X	EXIST	PT	X	OPEN	X	X	X	
	STR NO.2					CMU	PT	X	CMU	PT	X	CMU	PT	X	CMU	PT	X	OPEN	X	X	X	
	STR NO.3					CMU	PT	X	CMU	PT	X	CMU	PT	X	CMU	PT	X	OPEN	X	X	X	
201	2ND FLR LOBBY	RU	TYPE 1	RCB	1	GWB/CMU	PT/SEAL	10/CLEAR				GWB	PT	10	X	X	X	X	X	X	X	
202	MALE WC	RU	TYPE 1	CT	TYPE 5	CT	TYPE 5		CT	TYPE 5		CT	TYPE 5		CT	TYPE 5		ACT	X	X	2400	
203	FEMALE WC	RU	TYPE 1	CT	TYPE 5	CT	TYPE 5		CT	TYPE 5		CT	TYPE 5		CT	TYPE 5		ACT	X	X	2400	
204	LOCKERS	SF	TYPE 3	VCB	X	CMU	SEAL	CLEAR	CMU	SEAL	CLEAR	X	X	X	CMU	SEAL	CLEAR	X	X	X	X	
205	CARDIO	SF	TYPE 2	VCB	X	X	X	X	X	X	X	X	X	X	X	X	X	X	X	X	X	
206	WEIGHTS	SF	TYPE 2	VCB	X	X	X	X	X	X	X	X	X	X	X	X	X	X	X	X	X	
207	TRACK	SF	TYPE 4	SF	TYPE 4	METAL	PREFIN	MET-1	METAL	PREFIN	MET-1	METAL	PREFIN	MET-1	METAL	PREFIN	MET-1	OPEN	X	X	X	OPEN TO DECK
208	PROGAM	SF	TYPE 1	VCB	X	X	X	X	X	X	X	X	X	X	X	X	X	X	X	X	X	
209	JANITOR RM	CONC	X	VCB	X	GWB	PT	11	GWB	PT	11	GWB	PT	11	GWB	PT	11	OPEN	PT	X	X	
	STR NO.1	RU	TYPE 1	RCB	1	EXIST	PT	X	EXIST	PT	X	EXIST	PT	X	EXIST	PT	X	GWB	X	X	X	
	STR NO.4					METAL	PREFIN	SILVER	GWB	PT	11	METAL	PREFIN	SILVER	METAL	PREFIN	SILVER	GWB	X	X	X	
					X	GWB	PT	12	GWB	PT	12	GWB	PT	12	GWB	PT	12	GWB	X	X	X	
301	MECHANICAL RM	CONC	X	VCB	X	GWB	PT	X	GWB	PT	X	GWB	PT	X	GWB	X	X	OPEN	PT	X	X	
302	ELEVATOR MACHINE	CONC	X	VCB	X	GWB	PT	X	GWB	PT	X	GWB	PT	X	GWB	X	X	OPEN	PT	X	X	

04

DOOR SCHEDULE

DOOR NO	TO ROOM	DOOR SIZE	DOOR SWING	DOOR TYPE	DOOR MAT	DOOR CORE	DOOR FINISH	DOOR COLOUR	FRAME PROFILE	FRAME MAT	FRAME TYPE	FRAME FINISH	FRAME COLOUR	HDW GROUP	FIRE RATING	GRILLES	COMMENTS
D101A	VESTIBULE	1400X2100	RH	5	GLS	HC	N/A	–	F4	ALUM	–	ANOD	CLEAR	SEE SPEC	N/A	N/A	
D101B	VESTIBULE	910X2100	LHR	4	GLS	HC	N/A	–	F3	ALUM	–	ANOD	CLEAR	15	N/A	N/A	BALANCE BY HDWR BY MFTR.
D102	ENTRY	1200X2100	SLIDING	4	GLS	HC	N/A	–	F3	ALUM	–	ANOD	CLEAR	SEE SPEC	N/A	N/A	
D103A	LOBBY	1200X2100	SLIDING	4	GLS	HC	N/A	–	F3	ALUM	–	ANOD	CLEAR	SEE SPEC	N/A	N/A	
D103B	LOBBY	910X2100	RH	4	GLS	HC	N/A	–	F3	ALUM	–	ANOD	CLEAR	1	N/A	N/A	
D104A	LIBRARY	1200X2100	LH	4	GLS	HC	N/A	–	F3	ALUM	–	ANOD	CLEAR	11	N/A	N/A	
D104B	LIBRARY	910X2100	LHR	1	HM	INSUL	PT	A	F1	HM	KD	PT	A	1	.75HR	N/A	
D105	STAFF RM	910X2100	RH	3	WD	HC	ST	A	F2	WD	KD	ST	A	2	N/A	N/A	
D106	STAFF WC	910X2100	LH	3	WD	HC	ST	A	F2	WD	KD	ST	A	6	N/A	N/A	
D107	PUBLIC WC	910X2100	LH	3	WD	HC	ST	A	F2	WD	KD	ST	A	6	N/A	N/A	
D108	TUTORIAL	910X2100	RH	3	WD	HC	ST	A	F2	WD	KD	ST	A	2	N/A	N/A	
D109	OFFICE	910X2100	LH	3	WD	HC	ST	A	F2	WD	KD	ST	A	3	N/A	N/A	
D111	STORAGE	910X2100	SLIDING	3	WD	HC	ST	A	F2	WD	KD	ST	A	8	N/A	N/A	POCKET DOOR
D113A	PROGRAM 1	2–950X2100	RHA	3	WD	HC	ST	A	F2	WD	KD	ST	A	5	N/A	N/A	
D113B	PROGRAM 1	2–910X2100	SLIDING	3	WD	HC	ST	A	F2	WD	KD	ST	A	13	N/A	N/A	
D113C	PROGRAM 1	2–910X2100	SLIDING	3	WD	HC	ST	A	F2	WD	KD	ST	A	13	N/A	N/A	
D113D	PROGRAM 1	2–910X2100	SLIDING	3	WD	HC	ST	A	F2	WD	KD	ST	A	9	N/A	N/A	DOUBLE POCKET DOORS
D113E	PROGRAM 1	910X2100	RHR	3	WD	HC	ST	A	F2	WD	KD	ST	A	3	N/A	N/A	
D114A	PROGRAM 2	910X2100	LH	3	WD	HC	ST	A	F2	WD	KD	ST	A	3	N/A	N/A	
D114B	PROGRAM 2	2–760X2100	SLIDING	3	WD	HC	ST	A	F2	WD	KD	ST	A	13	N/A	N/A	
D115	PUBLIC WC	910X2100	LH	3	WD	HC	ST	A	F2	WD	KD	ST	A	6	N/A	N/A	
D116	PUBLIC WC	910X2100	LH	3	WD	HC	ST	A	F2	WD	KD	ST	A	6	N/A	N/A	
D117	NETWORK	910X2100	LH	3	WD	HC	ST	A	F2	WD	KD	ST	A	4	N/A	N/A	
D118	REC CENTRE STAFF	910X2100	RH	3	WD	HC	ST	A	F2	WD	KD	ST	A	4	N/A	N/A	
D120	STR NO.2	910X2100	RHR	1	HM	INSUL	PT	A	F1	HM	KD	PT	A	1	.75HR	N/A	
D121	STR NO.3	910X2100	RHR	1	HM	INSUL	PT	A	F1	HM	KD	PT	A	1	.75HR	N/A	
D202	MALE	910X2100	RH	3	WD	HC	ST	A	F2	WD	KD	ST	A	6	N/A	N/A	
D203	FEMALE	910X2100	LH	3	WD	HC	ST	A	F2	WD	KD	ST	A	6	N/A	N/A	
D209	JANITOR	910X2100	LHR	2	HM	HC	PT	A	F2	HM	KD	PT	A	4	N/A	N/A	
D301	MECHANICAL RM	910X2100	RHR	2	HM	HC	PT	A	F2	HM	KD	PT	A	4	N/A	N/A	
D302	ELEVATOR MACHINE	910X2100	LH	2	HM	HC	PT	A	F2	HM	KD	PT	A	12	N/A	N/A	
D303	DOOR TO ROOF	910X2100	RH	2	HM	HC	PT	A	F2	HM	KD	PT	A	7	N/A	N/A	
EXISTING DOORS REQUIRING CARD READERS																	
DB01E	WEST SERVICE STAIRWELL													14			
D101E	WEST ENTRANCE (SOUTH)													18			
D102E	WEST ENTRANCE (NORTH)													15			
D103E	NORTH ENTRANCE													15			
D104E	NORTH ENTRANCE													10			
D105E	NORTH ENTRANCE													15			
D106E	EAST ENTRANCE													15			
D107E	EAST POOL ENTRANCE													10			
D108E	SOUTH POOL ENTRANCE													16			
D109E	SERVICE STAIRWELL													17			
D110E	DOOR TO POOL AREA													14			
D111E	DOOR TO DATA ROOM													10			
D112E	SOUTHEAST ENTRANCE													15			
D113E	JANITOR ROOM													10			
D114E	NORTHEAST POOL ENTRY													–			
D115E	NORTH POOL ENTRANCE													10			
D116E	JANITOR ROOM													10			
D117E	JANITOR ROOM													10			
D118E	EAST POOL ENTRANCE													14			
D119E	STAIR DOOR TO BSMNT													–			
D210E	DOOR TO SECOND FLR													10			
OH1E	NORTH O/H DOOR													–			OVERHEAD DOOR
OH2E	NORTH O/H DOOR													–			OVERHEAD DOOR
OH3E	NORTH O/H DOOR													–			OVERHEAD DOOR

04

FINISH SCHEDULE LEGEND:

CT – CERAMIC TILE

RU – RUBBER FLOORING

WD – PRE–FIN HARDWOOD
CPT – CARPET TILE
CP – CARPET ROLL GOODS
CMU – CONCRETE MASONRY UNIT
GL – ALUMINUM FRAMED GLAZING
CONC – CONCRETE
ACT – ACOUSTIC TILE SYSTEM

SS – SUSPENDED STUCCO PANELS

VCB – VINYL COVERED BASE
GWB – GYPSUM WALL BOARD

04

DOOR SCHEDULE LEGEND:

RHR – RIGHT HAND REVERSE
LHR – LEFT HAND REVERSE
RH – RIGHT HAND
LH – LEFT HAND
HM – HOLLOW METAL
WD – WOOD
GLS – GLASS
INSUL – INSULATE
HC – HOLLOW CORE
ST – STAIN
KD – KNOCK DOWN
PT – PAINT
ANOD – ANODIZED

NOTES:

1. "MET–1" TO MATCH DURANAR BRIGHT SILVER METALLIC UC55028DL BY PPG
2. "K–13" TO BE 2" SONASPRAY ACOUSTICAL TREATMENT APPLIED TO U/S CEILING DECK.

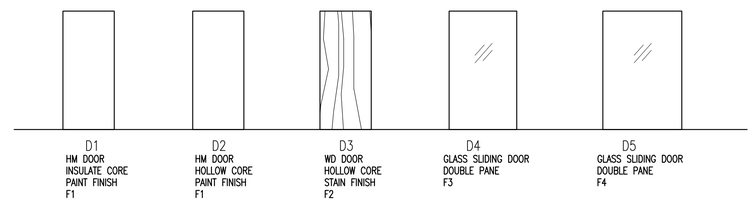

DOOR TYPES
SCALE: 1:50

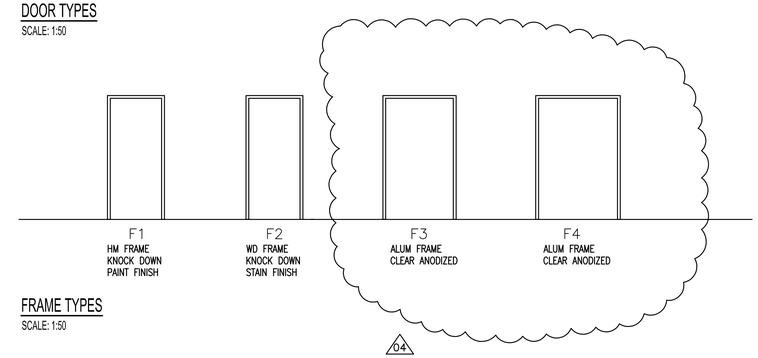

FRAME TYPES
SCALE: 1:50

04

MATERIAL LIST

ALL CERAMIC TILE TO BE CENTURA COLLECTIONS SERIES: JUPITER
ALL GROUT JOINTS TO BE TIGHT AND LEVEL WITH THE TILE

CERAMIC TILE TYPE 1
24", 24" GRIFITO
GROUT FLEXTILE NORTH SEA GREY 663

CERAMIC TILE TYPE 2
24", 24" BLACK
GROUT FLEXTILE JET BLACK 653

CERAMIC TILE TYPE 3
24", 24" MARRON POLISHED
GROUT FLEXTILE JET BLACK 653

CERAMIC TILE TYPE 4
24", 24" GRIS POLISHED
GROUT FLEXTILE SMOKE 681

CERAMIC TILE TYPE 5
BATHROOM WALLS
12", 12" GRIS
GROUT FLEXTILE SMOKE 681

CERAMIC TILE TYPE 6
24", 24" BLACK POLISHED
GROUT FLEXTILE JET BLACK 653

SPORT FLOORING TYPE 1
MONDO
SPORT IMPACT COLOR DARK GREY 018

SPORT FLOORING TYPE 2
MONDO
SPORT IMPACT COLOR 008 BLACK

SPORT FLOORING TYPE 3
MONDO
RAMFLEX G790 SOLID BLACK

SPORT FLOORING TYPE 4
MONDO, SPORTFLEX
P30 RED
10MM THICK, ROLLED RUBBER
RUNNING TRACK PAINTED GAME LINES, AS PER DRAWING OR OWNER

RUBBER FLOORING TYPE 1
MONDO
TERRANOVA, 448 PEACOCK

RUBBER COVE WALL BASE TYPE 1
JOHNSONITE
COLOR: 38 PEWTER
SIZE: 150 MM TIGHTLOCK RESILENT

STAIR NOSINGS
EVE PARENT,
COLOR: BLACK
3/8" REDUCER

AT EACH LANDING
MONDO– MONDOSTEP
TYPE VI C/W VISUAL YELLOW STRIP
COLOR BLACK 208

FOR THE STAIR 2 AND 3
FLOORING TO BE
MONDO– BOLLO TILES
COLOR BLACK 208

CARPET TILE TYPE 1
SHAW CONTRACT
WEAVE ACCENT TILE, 59442
COLOR HILL TRIBE, 42504
100% ANTON LEGACY NYLON

CARPET BROADLOOM TYPE 2
SHAW CONTRACT
MAN MADE STRIA 5A080
COLOR HILL TRIBE 41504
100% ANTON LEGACY NYLON

CARPET BASE BROADLOOM TYPE 2
SHAW CONTRACT
MAN MADE STRIA 59441
COLOR HILL TRIBE 41504
100% ANTON LEGACY NYLON
150MM HIGH ROUND TOP EDGE
BINDING COLOUR TO MATCH CARPET

PLASTIC LAMINATE TYPE 1
HIGHMARK SMOKED PROTECTION
AMBER GREEN HAUTELINK
HLG002T

MELAMINE TYPE 1
ROSEBURG, SKYBLEND
S16 ALMOND

SOLID SURFACE DIAMASTONE BY SMDS
BEIGE DUNA 3/4" THICK

PAINT COLOURS–MANUFACTURER ICI
LIFE MASTER–LATEX

(PAINT COLOURS TO FOLLOW)

04

NOTES :

THESE DRAWINGS SHALL NOT BE SCALED.

THE CONTRACTOR SHALL VISIT THE SITE AND SATISFY ONESELF ALL DIMENSIONS, DATUM, AND DETAILED INFORMATION SHOWN ARE CORRECT.

THE CONTRACTOR IS TO REVIEW AND COORDINATE ALL ARCHITECTURAL, MECHANICAL, ELECTRICAL AND STRUCTURAL DRAWINGS FOR ADDITIONAL OPENINGS THROUGH FLOORS, WALLS, AND CEILINGS FOR DUCT, PIPE & ELECTRICAL RISERS AND ALL OPENINGS NOT SHOWN ON DRAWINGS.

ALL OPENINGS THROUGH FIRE ASSEMBLIES ARE TO BE FIRE STOPPED AND SEALED WITH ULC APPROVED FIRE STOPPING TO MAINTAIN THE INTEGRITY OF THE FIRE SEPARATION, AND PROVIDE A SMOKE-TIGHT BARRIER.

ALL PRODUCTS AND MATERIALS TO BE USED AND INSTALLED SHALL CONFORM WITH MANUFACTURER'S SPECIFICATIONS & APPLICABLE CODES.

THE CONTRACTOR SHALL BE RESPONSIBLE TO PATCH AND MAKE GOOD ALL EXISTING CONSTRUCTION AFFECTED BY THE REMOVAL OF ALL ITEMS FORMING THE PART OF THE RENOVATION WORK.

WHERE NEW FLOORING AND BASE IS TO BE INSTALLED IN EXISTING AREAS (REFER TO FLOOR PLAN AND ROOM SCHEDULE) THE EXISTING FLOORING SURFACE AND BASE MUST BE REMOVED, UNLESS OTHERWISE NOTED. ALL FLOOR SURFACES SHALL BE PREPARED IN ACCORDANCE TO MANUFACTURER'S RECOMMENDATIONS FOR INSTALLATION OF NEW FLOOR.

WHERE PAINTING OF EXISTING WALLS IS INDICATED ON THE ROOM SCHEDULE, THESE WALLS MUST BE CLEANED OF ANY EXISTING WALL COVERING, PATCHED & PREPARED TO ACCEPT NEW MATERIAL, UNLESS OTHERWISE NOTED.

NO.	REVISION/DESCRIPTION	BY	DATE
04	ADDENDUM NO. 3	DG	AUG.24/07
03	ADDENDUM NO. 2	AL	AUG.22/07
02	ADDENDUM NO. 1	DG	AUG.10/07
01	ISSUED FOR PERMIT	DG	AUG.09/07
00	ISSUED FOR TENDER	DG	JUL.24/07

SEALS

PROVINCE OF MANITOBA – NEIL COOPER – REGISTERED ARCHITECT

PROVINCE OF MANITOBA – NEIL COOPER ARCHITECT INC. No.090 – APPROVED ARCHITECTURAL CORPORATION

DRAWN BY CAD | CHECKED BY | APPROVED
DATE 2007 June 12 | USER APPROVAL

Winnipeg
CITY OF WINNIPEG
PLANNING, PROPERTY & DEVELOPMENT DEPARTMENT
CIVIC ACCOMMODATIONS DIVISION
300 – 65 GARRY ST. R3C 4K4

PROJECT
CONSTRUCTION OF
CINDY KLASSEN RECREATION COMPLEX
FACILITY ENHANCEMENT PROJECT
999 Sargent Ave, Winnipeg, MB

SHEET TITLE
ROOM FINISH AND
DOOR SCHEDULES

SCALE	PROJECT NO.	SHEET NO.
AS SHOWN	2005-059	A8.1

Neil Cooper Architect Inc.
10-395 Berry Street, Winnipeg, Manitoba R3J 1N6