



1 SOUTH ELEVATION
A3.0A6.0 3/16"=1'-0"

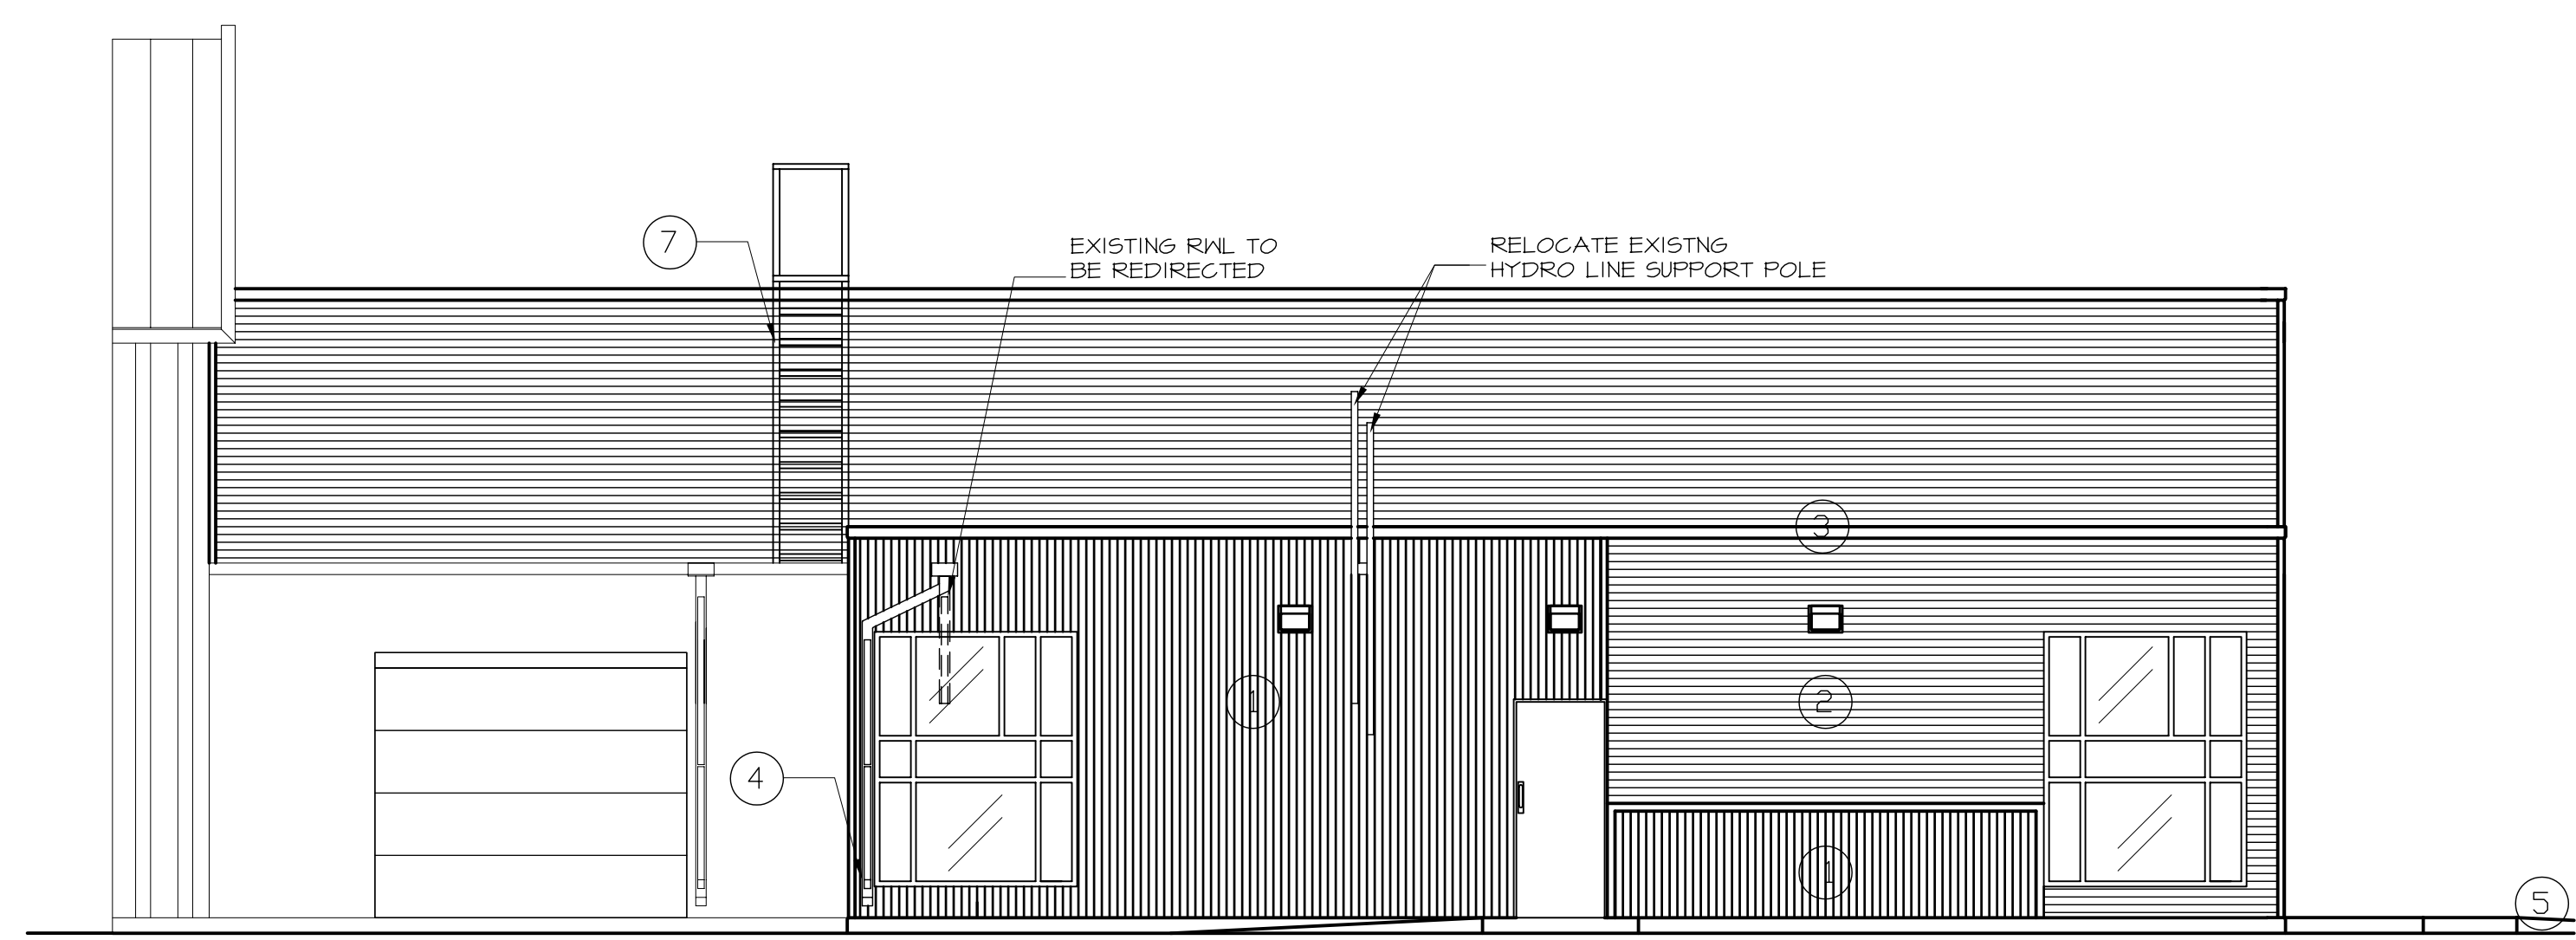


2 WEST ELEVATION
A3.0A6.0 3/16"=1'-0"

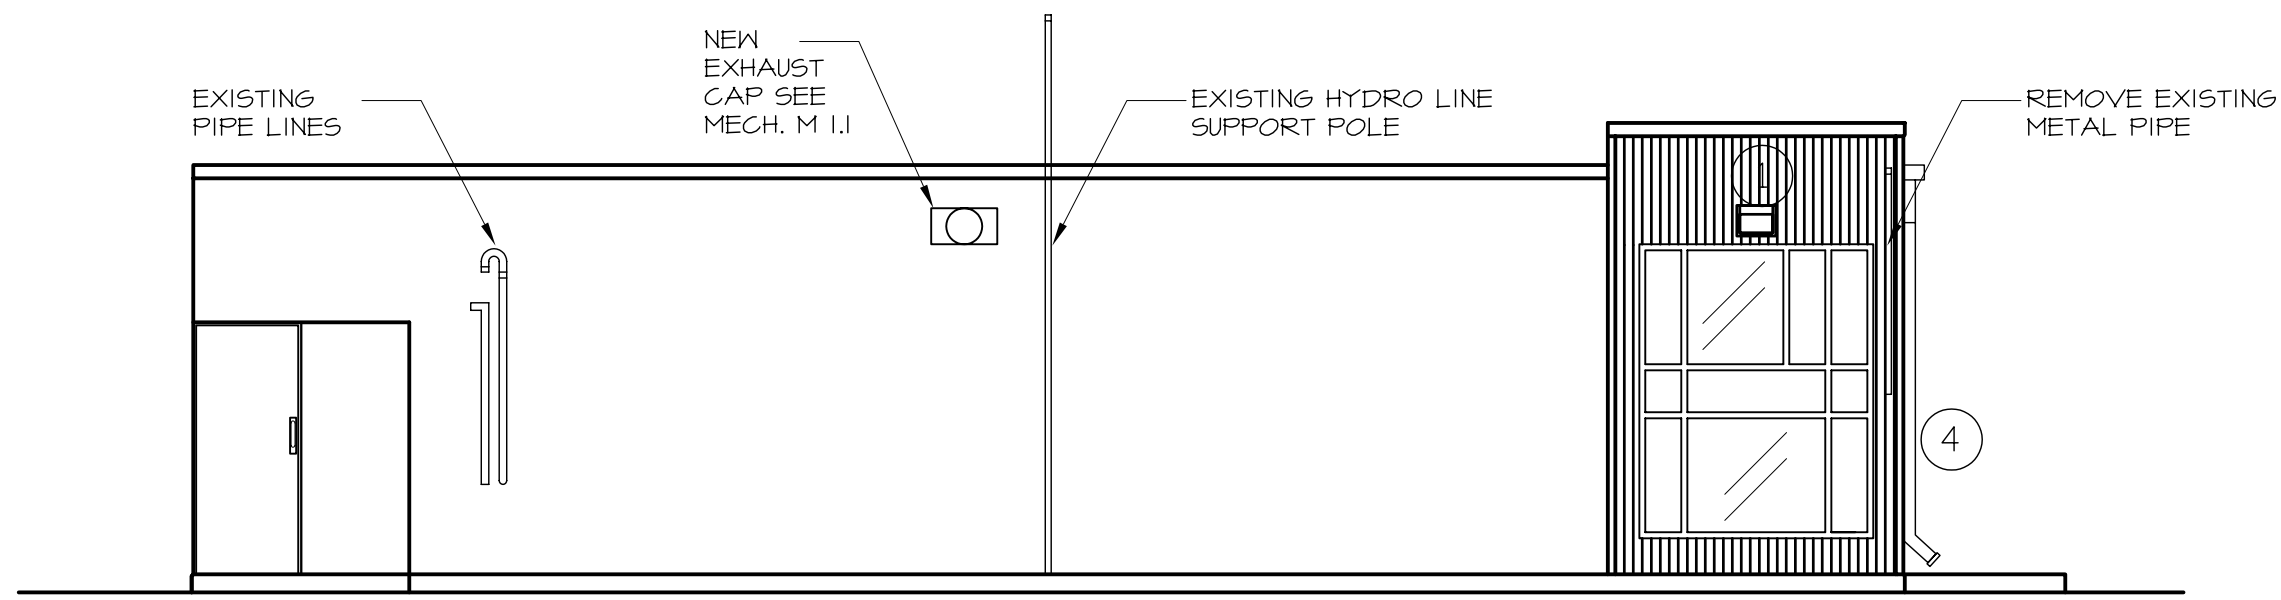

3 NORTH ELEVATION
A3.0A6.0 3/16"=1'-0"

- Revision: 5
WALL LEGEND
- 1 VICREST® CL622R VERTICAL METAL PANELS
ON REVISION: 2" VARIOUS FURRING CHANNELS QC5710
TERRA COTTA
 - 2 VICREST® CL622R HORIZONTAL METAL PANELS ON 6"/5"
FURRING CHANNELS REVISION: QC3654 SAND BEIGE
 - 3 PREFINISHED METAL CAP FLASHING VICREST®
COLOUR V16010 TILE RED REVISION: QC3654
SAND BEIGE
 - 4 RAIN WATER LEADER VICREST® COLOUR V16010 GOLD
SAND BEIGE REVISION: QC3654
 - 5 GRADED WALKWAY
 - 6 LADDER SEE
DETAIL A1.1/1 & 2
 - 7 LADDER SIM. TO
DETAIL A1.1/1 & 2
WITHOUT HOOP CAGE
AND LOCKABLE
DOOR

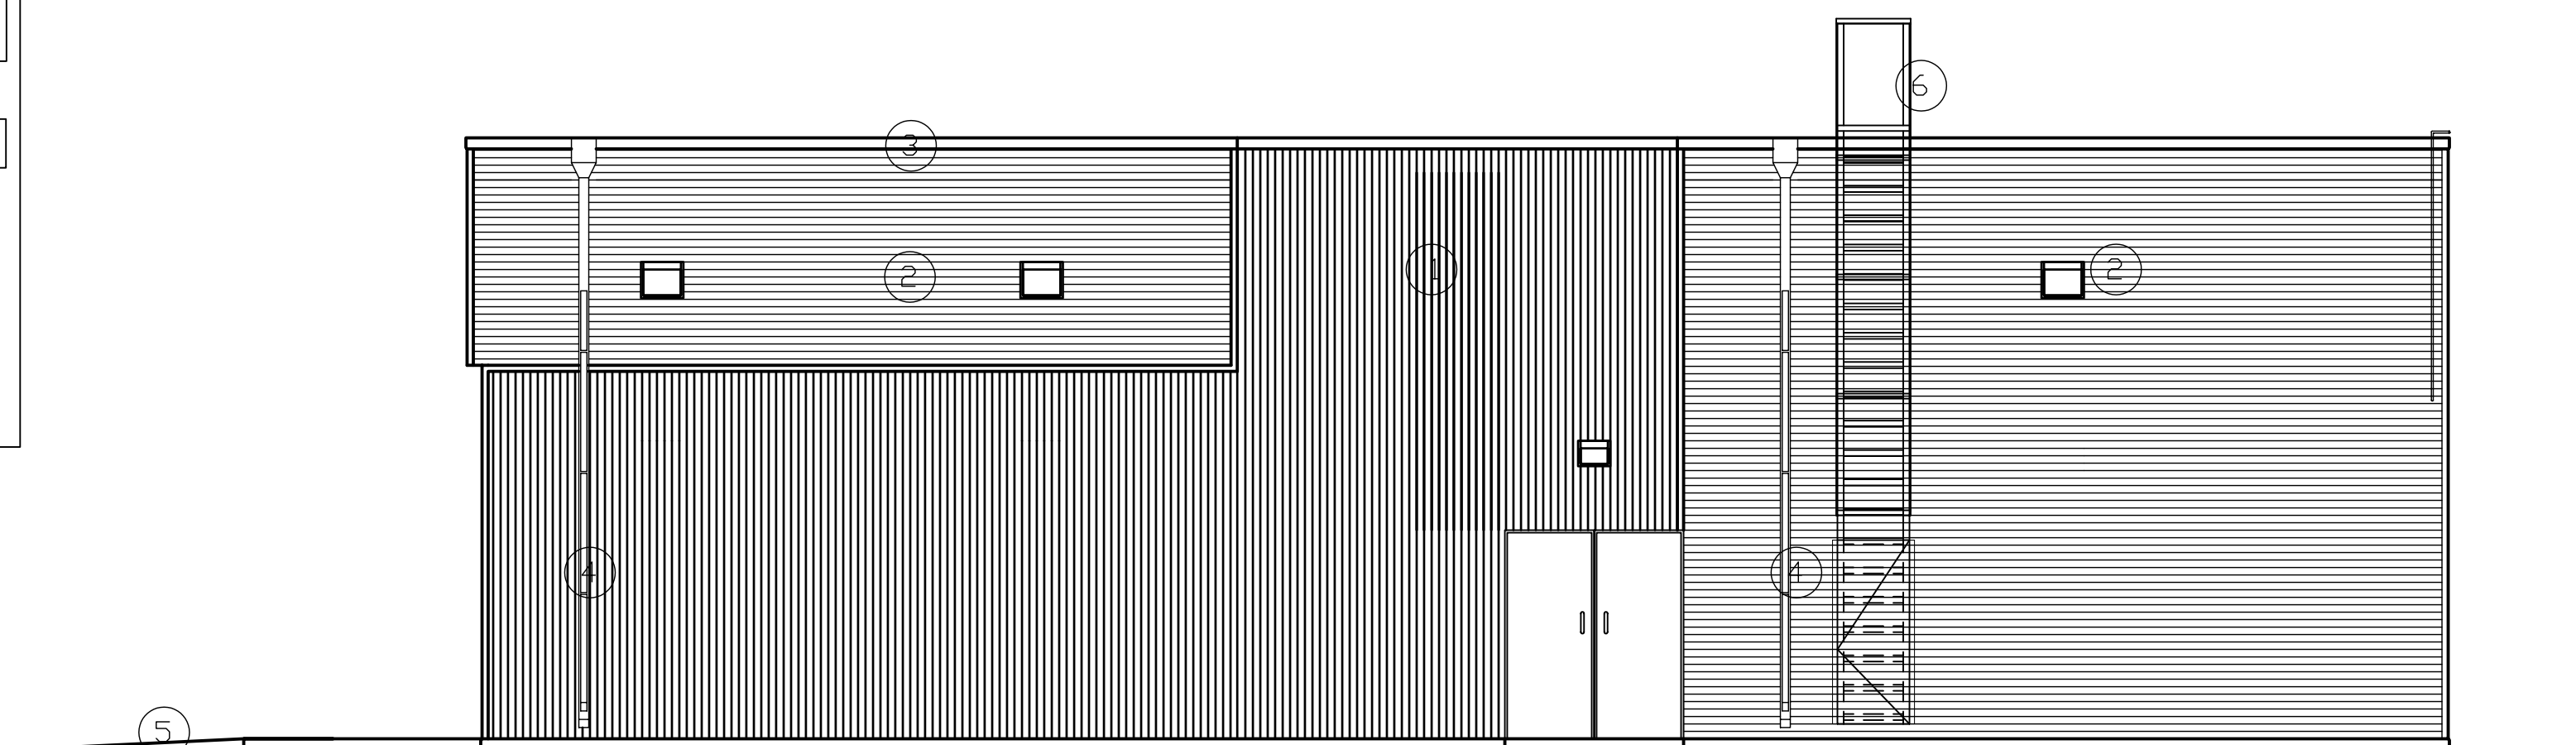


4 EAST ELEVATION
A3.0A6.0 3/16"=1'-0"

NO.	REVISION	DATE	BY
5	ADDENDUM NO.3	Jan. 18, 2008	
4	ADDENDUM NO.2	Jan 9, 2008	
3	ISSUED FOR TENDER	Nov 2007	
2	ISSUED FOR FINAL REVIEW	6 July 2007	
1	ISSUED FOR REVIEW	7 May 2007	

THIS DRAWING IS THE EXCLUSIVE PROPERTY OF THE ARCHITECT AND CAN BE REPRODUCED ONLY WITH THE PERMISSION OF THE ARCHITECT IN WHICH CASE THE REPRODUCTION MUST BEAR THE NAME OF THE ARCHITECT.
THIS DRAWING SHALL NOT BE SCALED. FOLLOW GIVEN DIMENSIONS ONLY.
THE CONTRACTOR SHALL SATISFY HIMSELF THAT ALL DIMENSIONS AND INFORMATION SHOWN ARE CORRECT.
PRIOR TO COMMENCEMENT OF WORK REPORT ANY DISCREPANCIES TO THE ARCHITECT.
VARIATIONS AND MODIFICATIONS TO WORK SHOWN WILL NOT BE ALLOWED WITHOUT WRITTEN PERMISSION OF THE ARCHITECT.

CONSULTANT

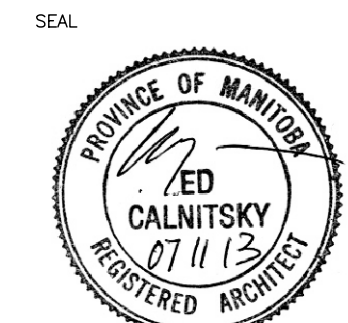

CALNITSKY ASSOCIATES ARCHITECTS

ARCHITECTURE | INTERIOR DESIGN
124 Nassau Street North | Winnipeg, Manitoba R3L 2H1
Tel: (204) 453-6441 | Fax: (204) 453-3392
E-mail: caa@escape.ca

PROJECT TITLE
NOTRE DAME COMMUNITY CENTRE RENOVATION
271 AVE. DE LA CATHEDRALE
WINNIPEG, MANITOBA

SHEET TITLE
**ELEVATIONS
PHASE 1**

DRAWN BY	SCALE	SHEET NUMBER
MJ	3/16" = 1'-0"	A-6.0
CHECKED BY	DATE	
EC	15 Oct. 2007	
PROJECT NUMBER	REVISION	
06-012		