


EXISTING SQUARE D MAIN BREAKER PANEL 120/208V / 3P


200 A 3P
4/C #3/0 TECK CABLE

 

Panel B100
120/208V / 3P
225A
42 cct.

MCC-B 120/208V / 3P

200 A 3P
4/C #3/0 TECK CABLE

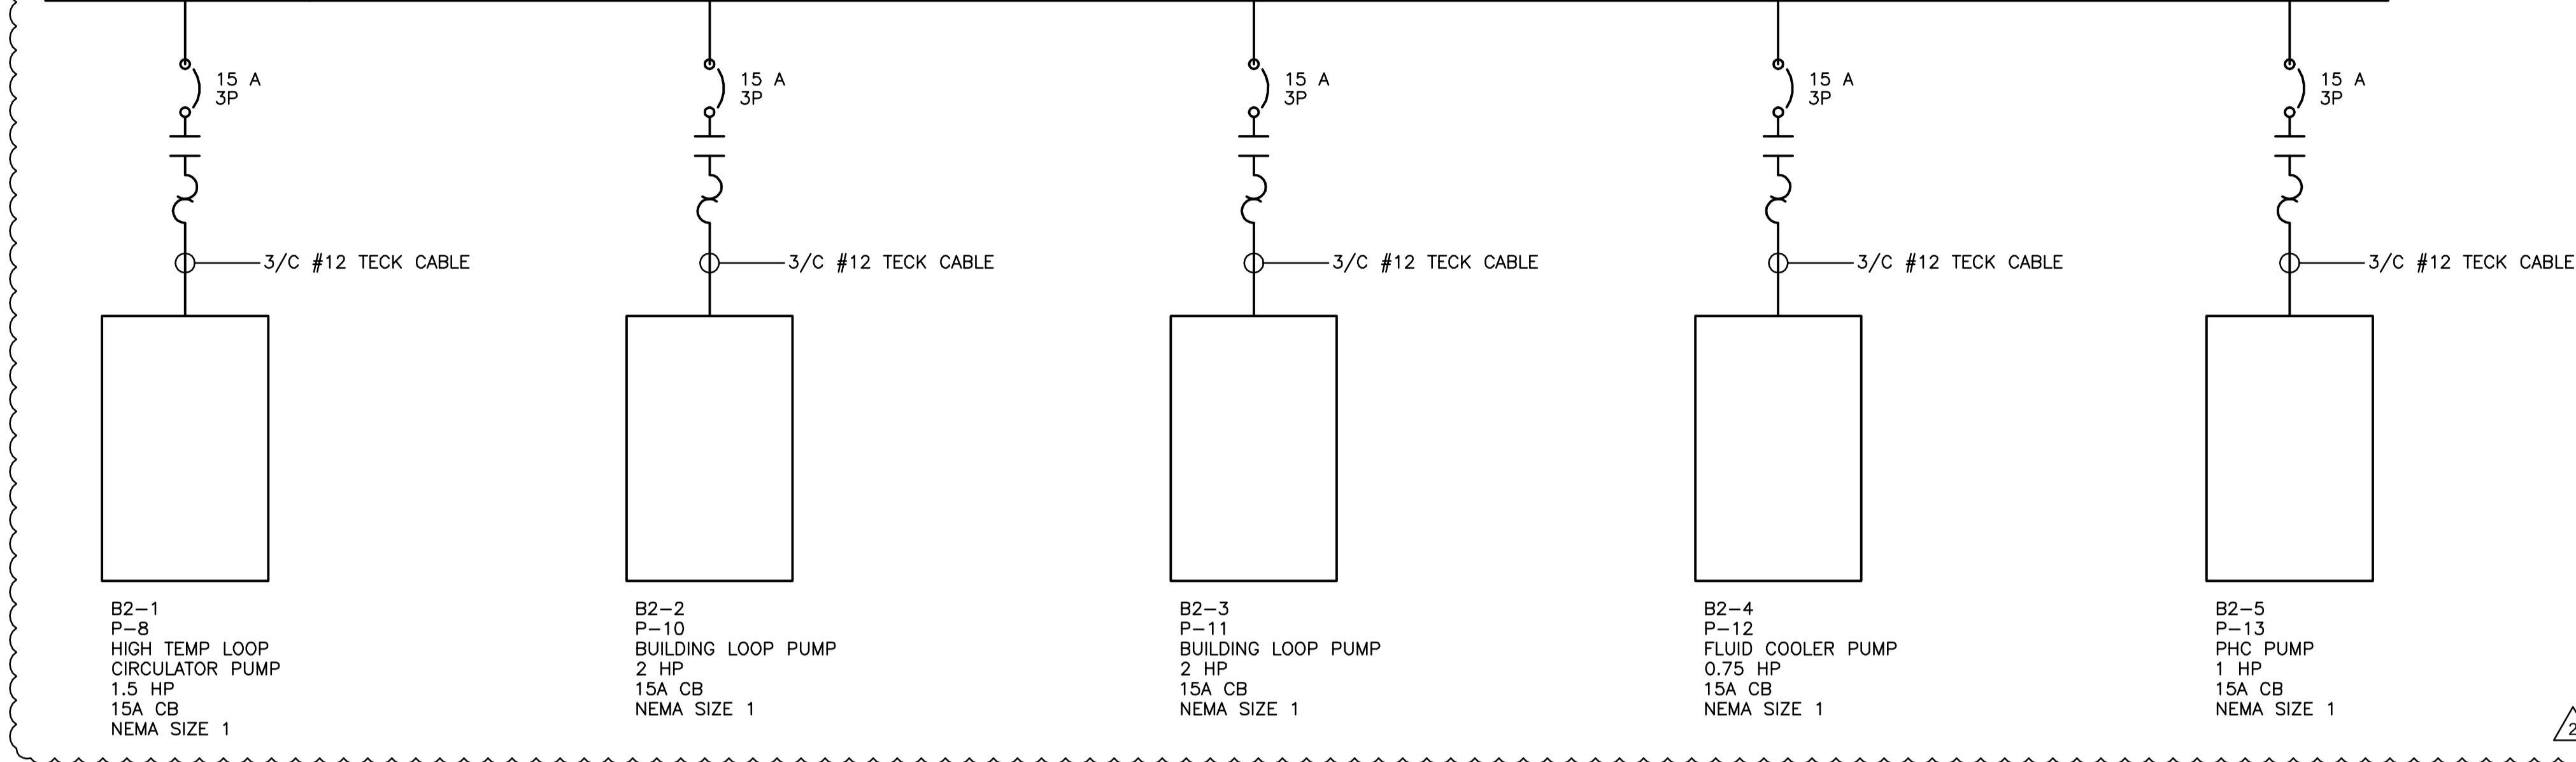

B2-1
P-8
HIGH TEMP LOOP
CIRCULATOR PUMP
15A CB
NEMA SIZE 1

B2-2
P-10
BUILDING LOOP PUMP
2 HP
15A CB
NEMA SIZE 1

B2-3
P-11
BUILDING LOOP PUMP
2 HP
15A CB
NEMA SIZE 1

B2-4
P-12
FLUID COOLER PUMP
0.75 HP
15A CB
NEMA SIZE 1

B2-5
P-13
PHC PUMP
1 HP
15A CB
NEMA SIZE 1

1 ADDITION TO MAIN DISTRIBUTION
N.T.S.

EXISTING DISTRIBUTION "B"

CCT-1,3,5
20 A
3P



MUA-1
MAKE UP AIR
UNIT MOTOR
3 HP

EXISTING

EXISTING DISTRIBUTION "B"

NOTE 1
CCT-1,3,5
30 A
3P

3/C #12
TECK CABLE

NOTE 2
VFD-1
MAKE UP AIR
UNIT VFD
7.5 HP

NOTE 3
3/C #12
TECK CABLE

NOTE 4
NOTE 5
MUA-1
MAKE UP AIR
UNIT MOTOR
7.5 HP

NEW

2 CHANGE TO DISTRIBUTION "B"
N.T.S.

PANEL B100

CCT-13
15 A

2/C #12
TECK CABLE

NOTE 6
EXHAUST FAN
SPEED CONTROLLER
IN NEW ELECTRICAL ROOM

2/C #12
TECK CABLE

CHANGE ROOM EXHAUST
FAN MOTOR (EXISTING)

3 CHANGE TO EXISTING CHANGE ROOM FAN
N.T.S.

- NOTES :
- 1 Replace existing breaker with new 30A breaker.
 - 2 VFD-1 supplied and installed by Div 23. Electrical power connections by Div 26, Control connections by Div 23.
 - 3 Replace existing cable.
 - 4 Replace existing disconnect switch with new 30A NEMA 4X disconnect switch. In the switch, an "early-break" auxiliary set of contacts shall be interlocked with the VFD's Stop input. "early-break" auxiliary set of contacts shall be wired by Division 26.
 - 5 MUA-1 motor supplied and installed by Div 23.
 - 6 Fan speed controller supplied and installed by Div 23. Cable and termination by Div 26.

2	ISSUED FOR ADDENDUM 4	ES	2009.01.06
1	ISSUED FOR ADDENDUM 2	ES	2008.12.12
0	ISSUED FOR ADDENDUM 1	ES	2008.12.05
NO.	REVISION/DESCRIPTION	BY	DATE



DRAWN BY	ES	CHECKED BY	APPROVED
DATE	2009.01.06	USER APPROVAL	

CITY OF WINNIPEG
PLANNING, PROPERTY AND
DEVELOPMENT DEPARTMENT
CIVIC ACCOMMODATIONS DIVISION
300 - 65 GARRY ST. R3C 4K4

PROJECT
CONFEDERATION BUILDING
SUPPLEMENTARY HEATING UPGRADES
PHASE 1 - CITY BID OPP. NO. 757-2008
457 MAIN STREET, WINNIPEG, MANITOBA

SHEET TITLE
BASEMENT LEVEL
ELECTRICAL SINGLE LINE



Certificate of Authorization
Earth Tech Canada Inc.
No. 730 Expiry: April 30, 2009

© 2008 EARTH TECH (CANADA) INC. ALL RIGHTS RESERVED.
THIS DOCUMENT IS PROTECTED BY COPYRIGHT LAW AND MAY NOT BE USED, REPRODUCED OR MODIFIED IN ANY MANNER OR FOR ANY PURPOSE EXCEPT WITH THE WRITTEN PERMISSION OF EARTH TECH (CANADA) INC. DOING BUSINESS AS AECOM (AECOM) OR A PARTY TO WHICH ITS COPYRIGHT HAS BEEN ASSIGNED. AECOM ACCEPTS NO RESPONSIBILITY, AND DENIES ANY LIABILITY WHATSOEVER, TO ANY PARTY THAT USES, REPRODUCES, MODIFIES, OR RELIES ON THIS DOCUMENT WITHOUT AECOM'S EXPRESS WRITTEN CONSENT.

SCALE	PROJECT NO.	SHEET NO.
AS SHOWN	105111	E02