



FILE NAME: 757-2008-M07-R2
 DATE: 2008.08.31
 DESCRIPTION: HYDRONIC SCHEMATICS
 PROJECT No.: 105111
 ADDRESS: 457 MAIN STREET

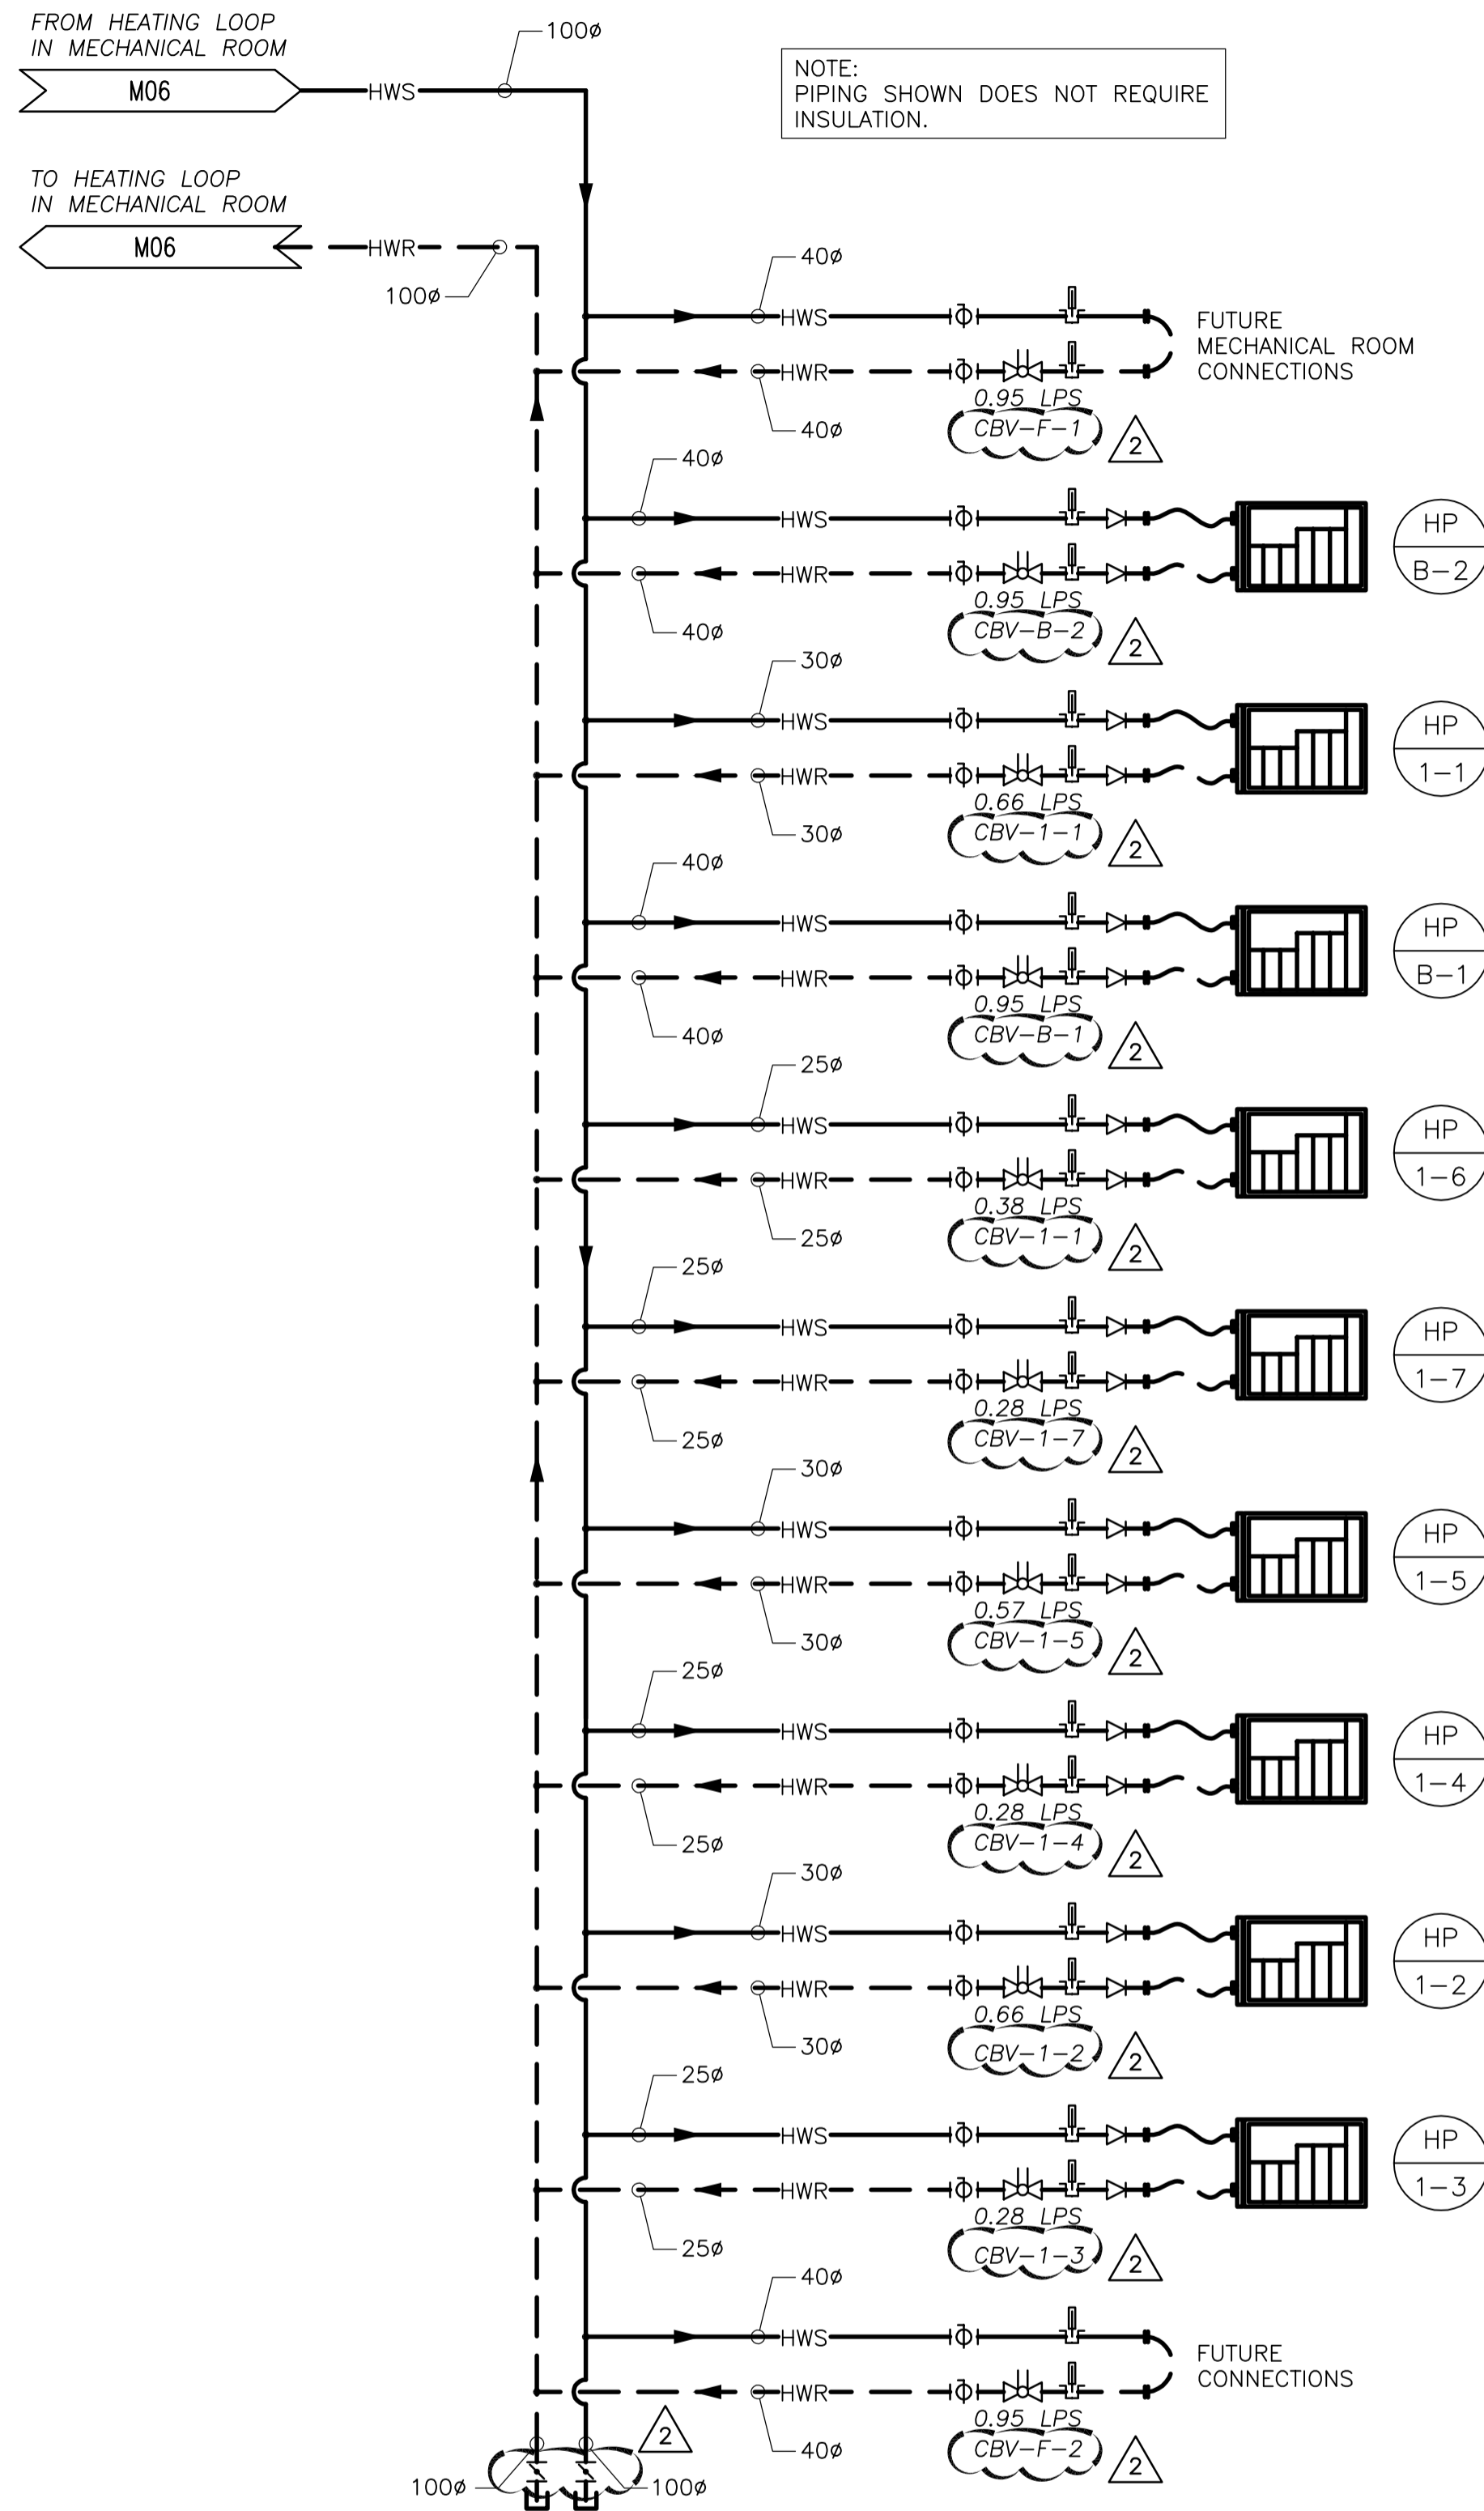

BASEMENT & MAIN FLOOR HEATING LOOP
 SCALE: NTS

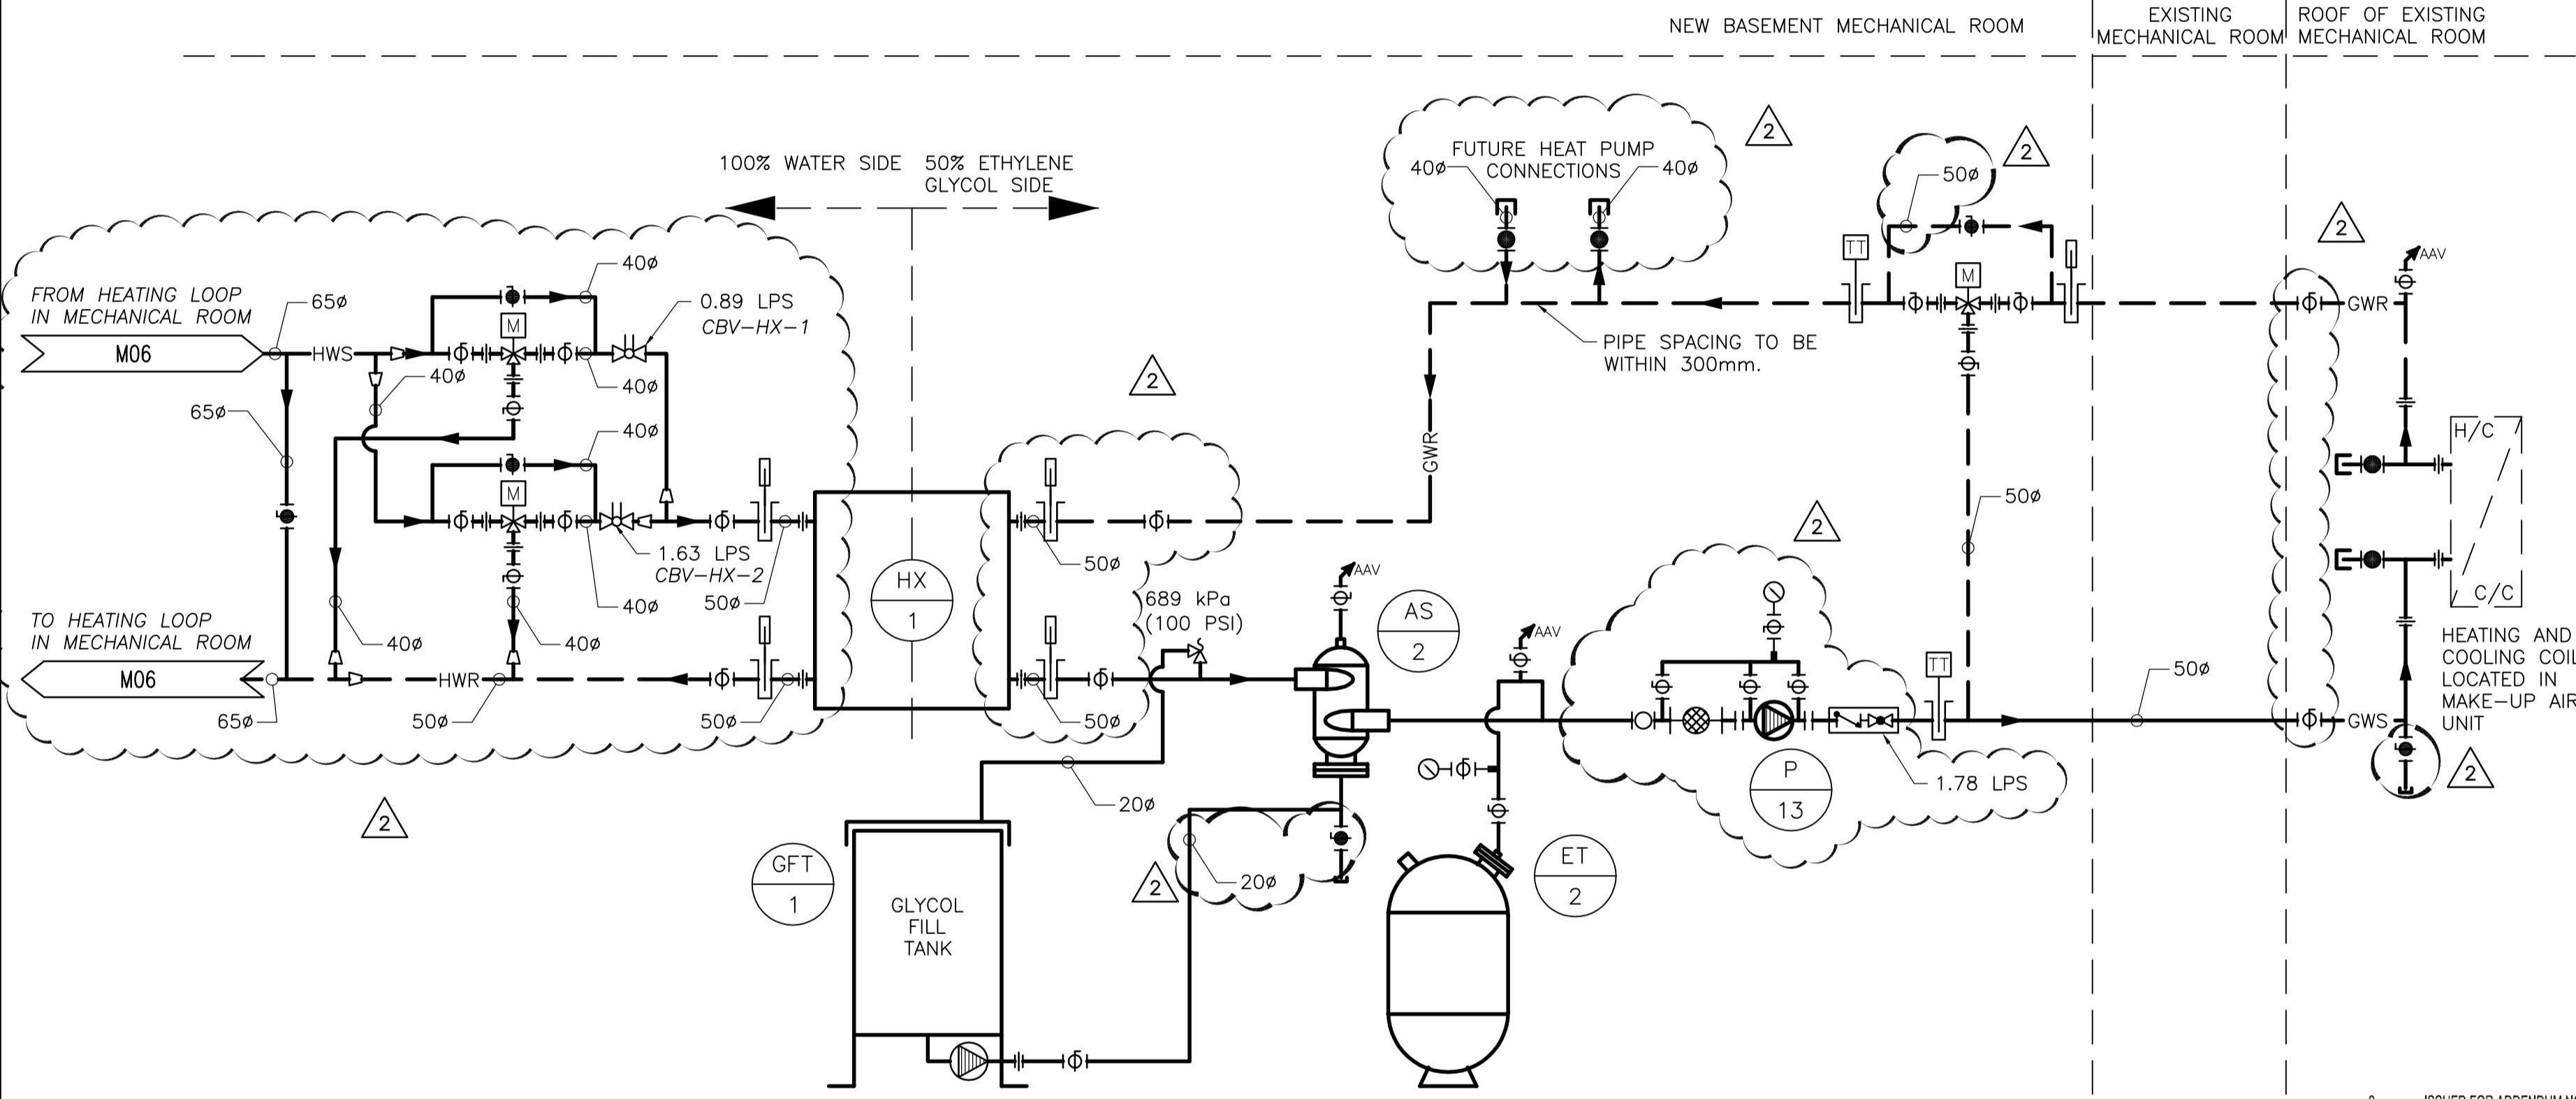

MAKE-UP AIR PRE-HEAT/COOLING LOOP
 SCALE: NTS

NOTES :

GENERAL NOTES

- DCW IS CONTINUOUSLY BEING FED TO FLUID COOLER WATER TANK; CONTROLLED BY FLOAT VALVE IN WATER TANK.
- THIS AS-BUILDING WAS DONE DURING "SUMMER" SEASON.

NO.	REVISION/DESCRIPTION	BY	DATE
2	ISSUED FOR ADDENDUM NO. 4	DL	2008.01.08
1	ISSUED FOR ADDENDUM NO. 2	DL	2008.12.12
0	ISSUED FOR TENDER	DL	2008.11.28

EARTH TECH | AECOM

DRAWN BY	DL	CHECKED BY	PVL	APPROVED	PVL
DATE	2008.08.31	USER APPROVAL			

Winnipeg CITY OF WINNIPEG
 PLANNING, PROPERTY AND
 DEVELOPMENT DEPARTMENT
 CIVIC ACCOMMODATIONS DIVISION
 300 - 65 GARRY ST. R3C 4K4

PROJECT
 CONFEDERATION BUILDING
 SUPPLEMENTARY HEATING UPGRADES
 PHASE 1 - CITY BID OPP. NO. 757-2008
 457 MAIN STREET, WINNIPEG, MANITOBA

SHEET TITLE
HYDRONIC SCHEMATICS
BASEMENT & MAIN FLOOR HEATING LOOP
MAKE-UP AIR PRE-HEAT/COOLING LOOP



APEGM
 Certificate of Authorization
 Earth Tech Canada Inc.
 No. 730 Expiry: April 30, 2009

AECOM
 © 2008 EARTH TECH (CANADA) INC. ALL RIGHTS RESERVED.
 THIS DOCUMENT IS PROTECTED BY COPYRIGHT LAW AND MAY NOT BE USED, REPRODUCED OR MODIFIED IN ANY MANNER OR FOR ANY PURPOSE EXCEPT WITH THE WRITTEN PERMISSION OF EARTH TECH (CANADA) INC. DOING BUSINESS AS AECOM ("AECOM") OR A PARTY TO WHICH ITS COPYRIGHT HAS BEEN ASSIGNED. AECOM ACCEPTS NO RESPONSIBILITY, AND DENIES ANY LIABILITY WHATSOEVER, TO ANY PARTY THAT USES, REPRODUCES, MODIFIES, OR RELIES ON THIS DOCUMENT WITHOUT AECOM'S EXPRESS WRITTEN CONSENT.

SCALE	PROJECT NO.	SHEET NO.
AS SHOWN	105111	M07

DRAWING SHEET SIZE: A1 (841mm x 594mm) PLOT 1:1