




STAGE 2 BRACED SHORING
SCALE 1:250

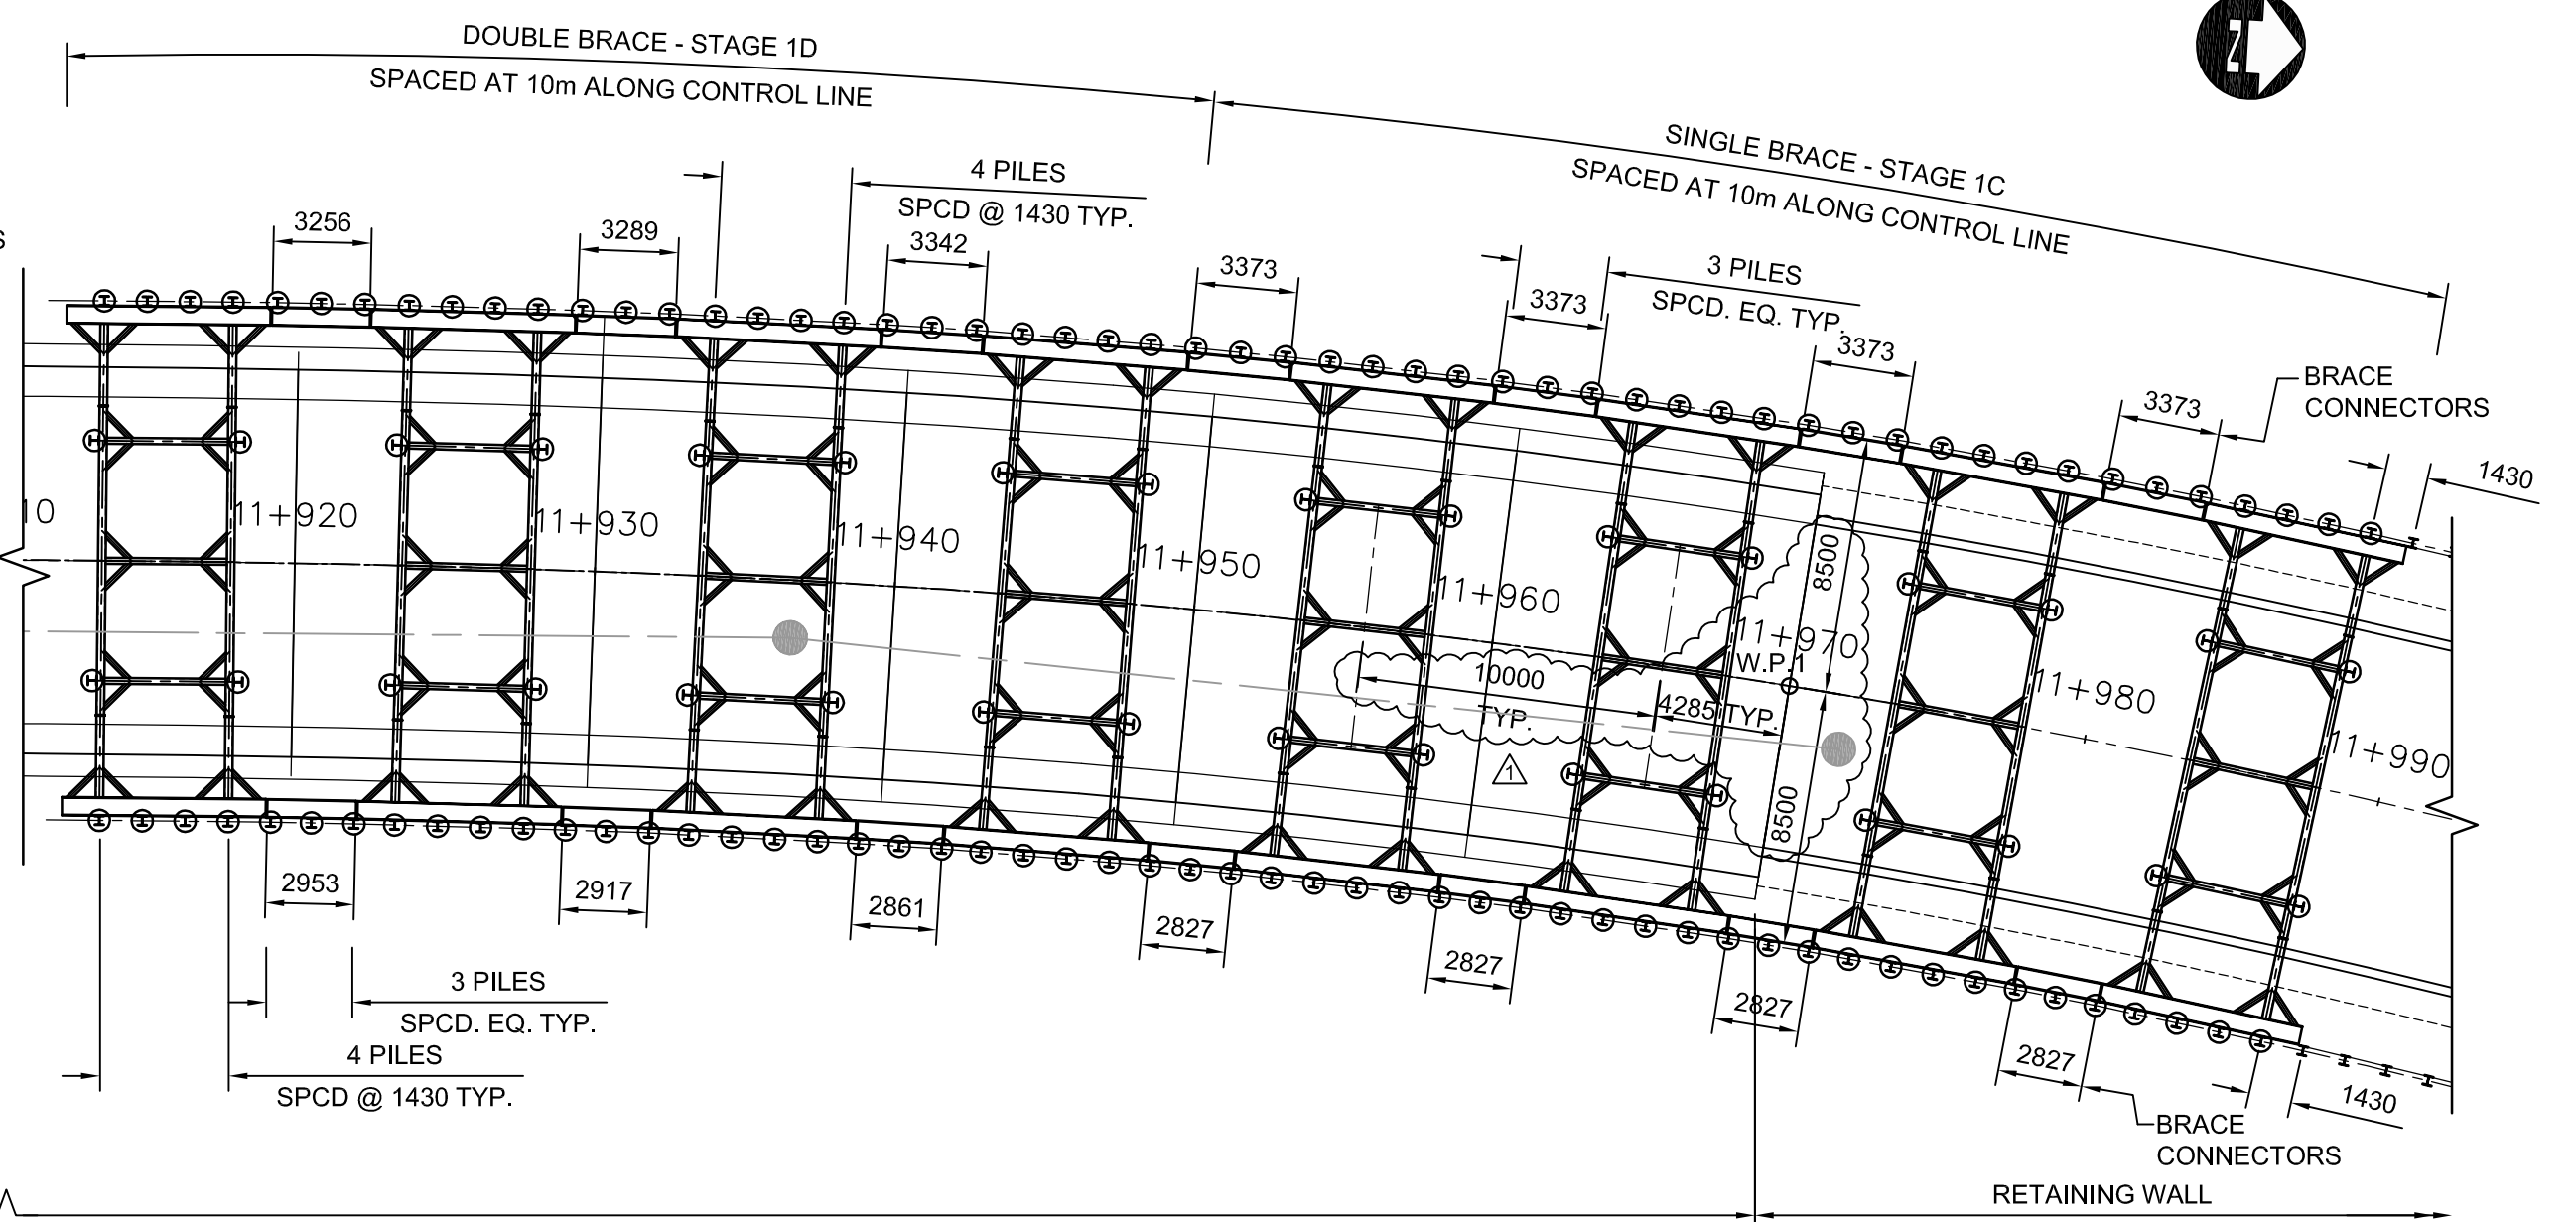


STAGE 1 BRACED SHORING
SCALE 1:250

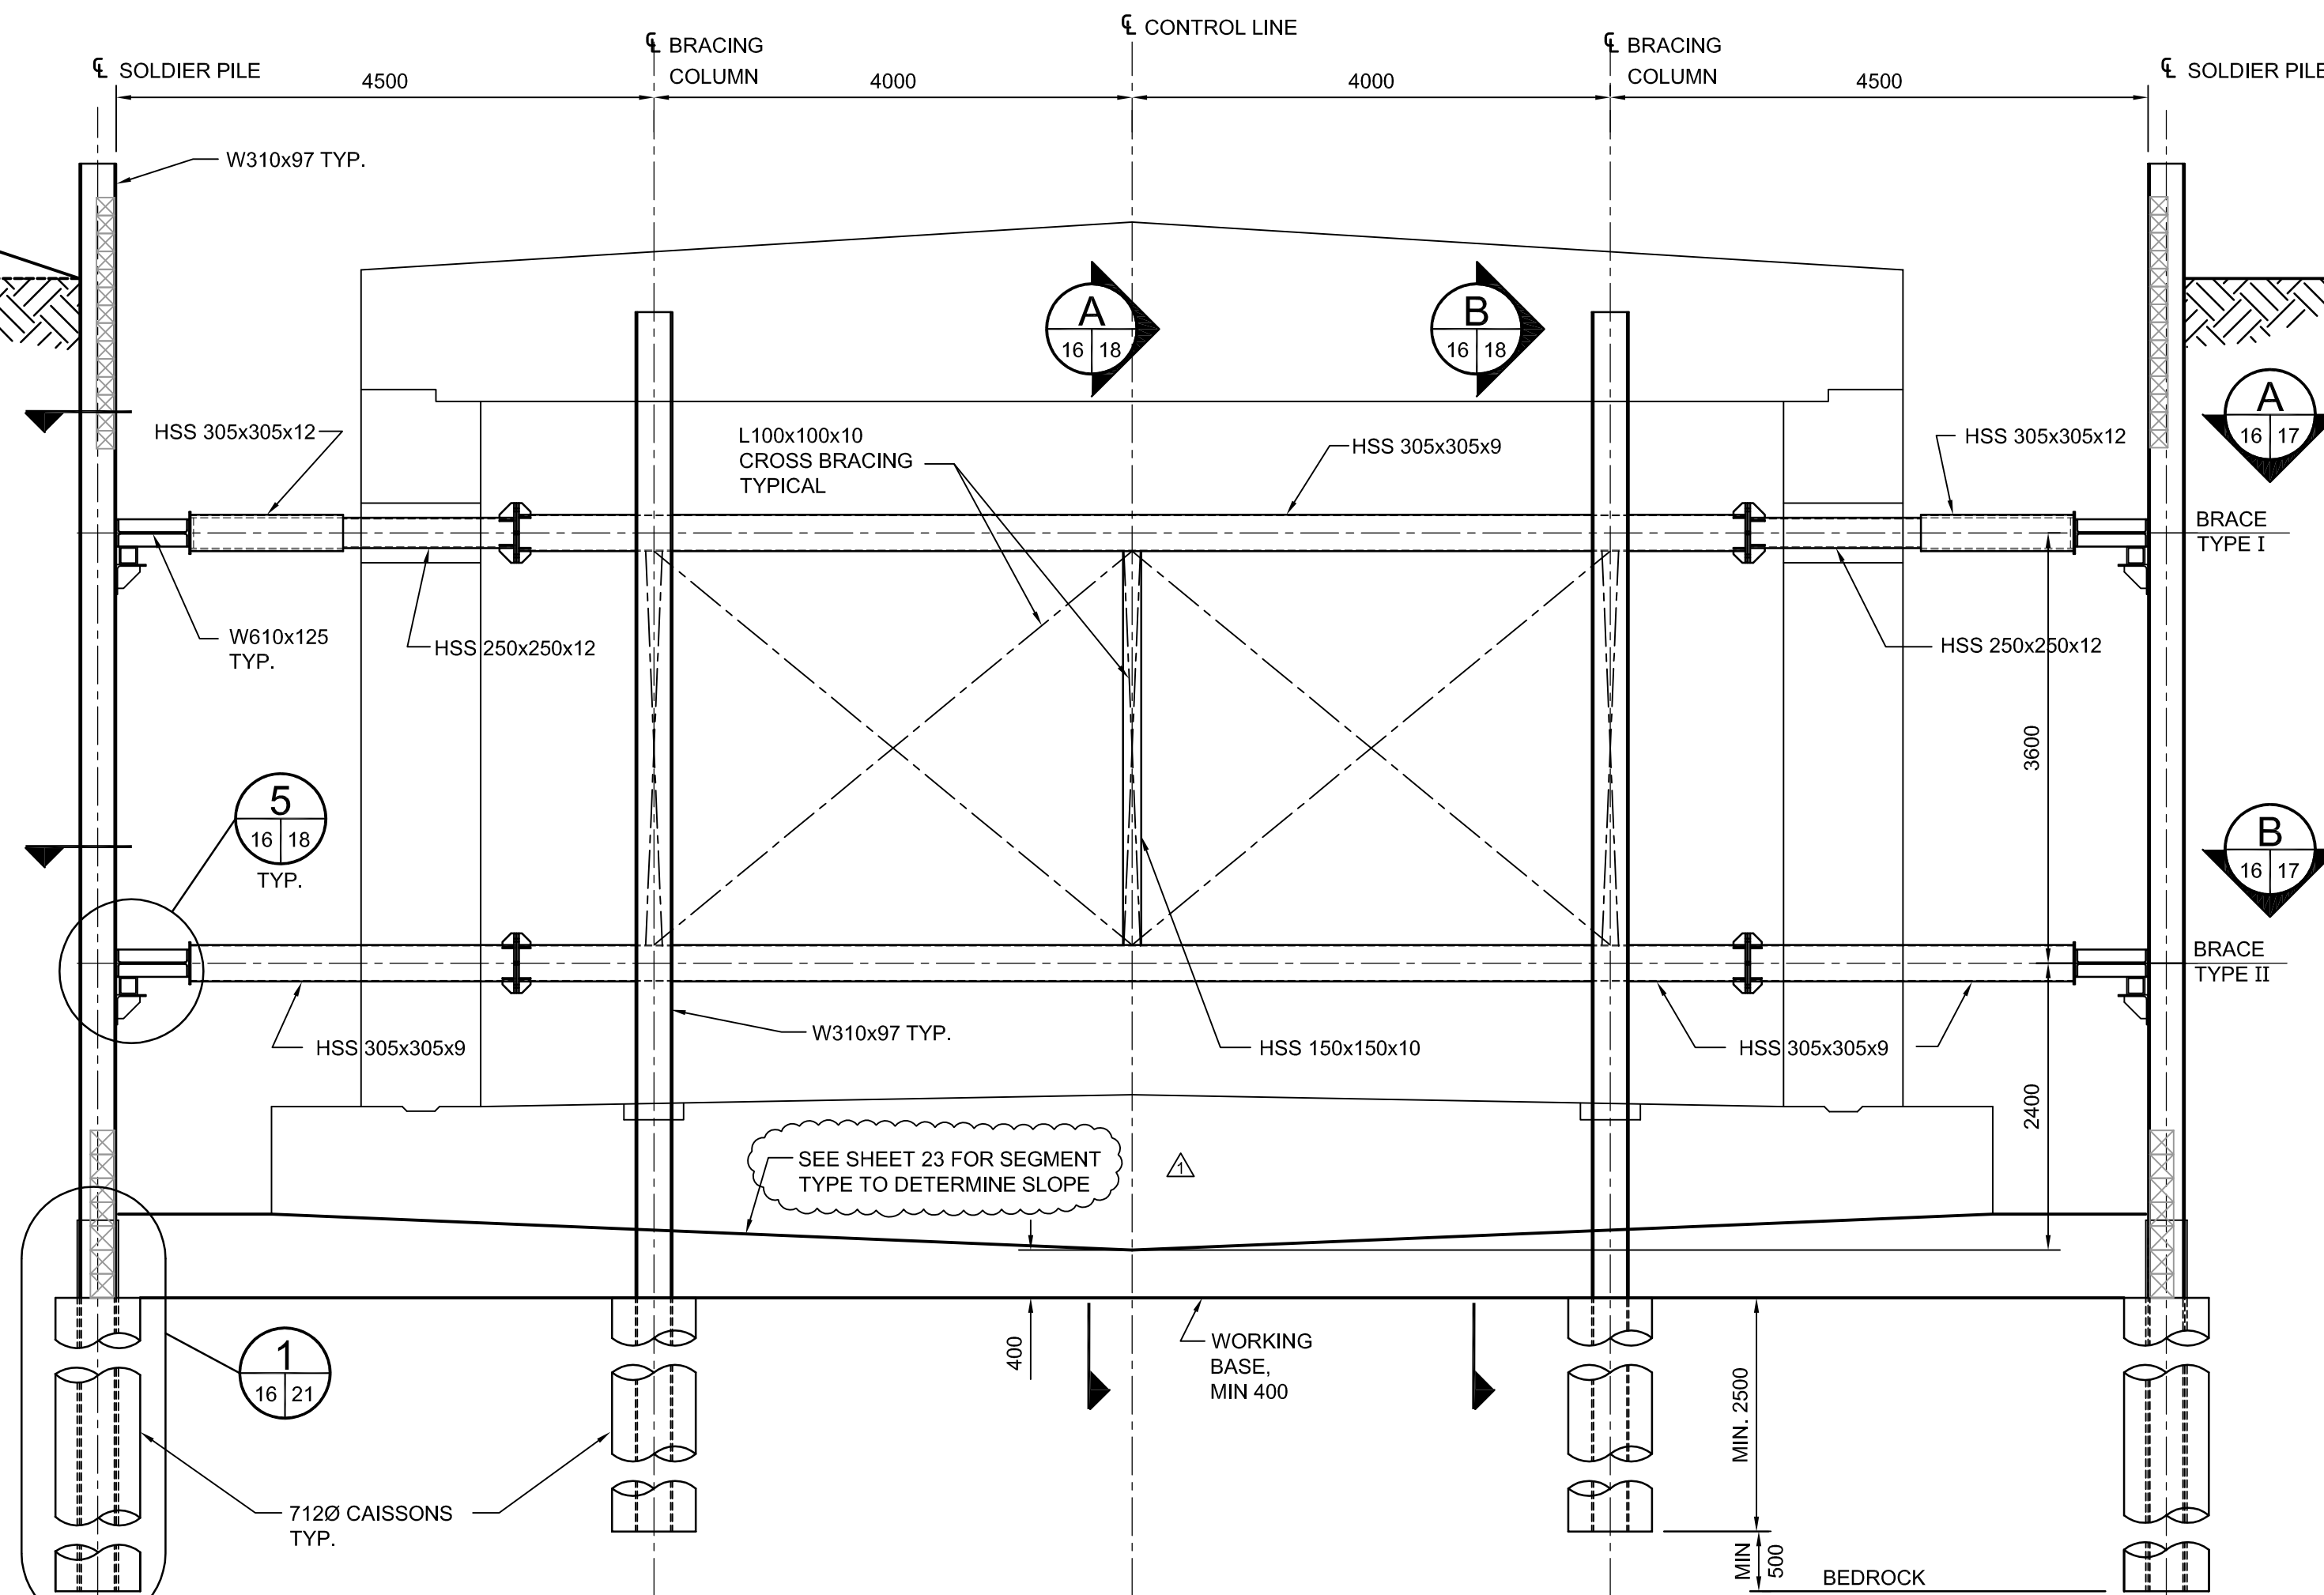

SECTION - DOUBLE BRACE
SCALE 1:100

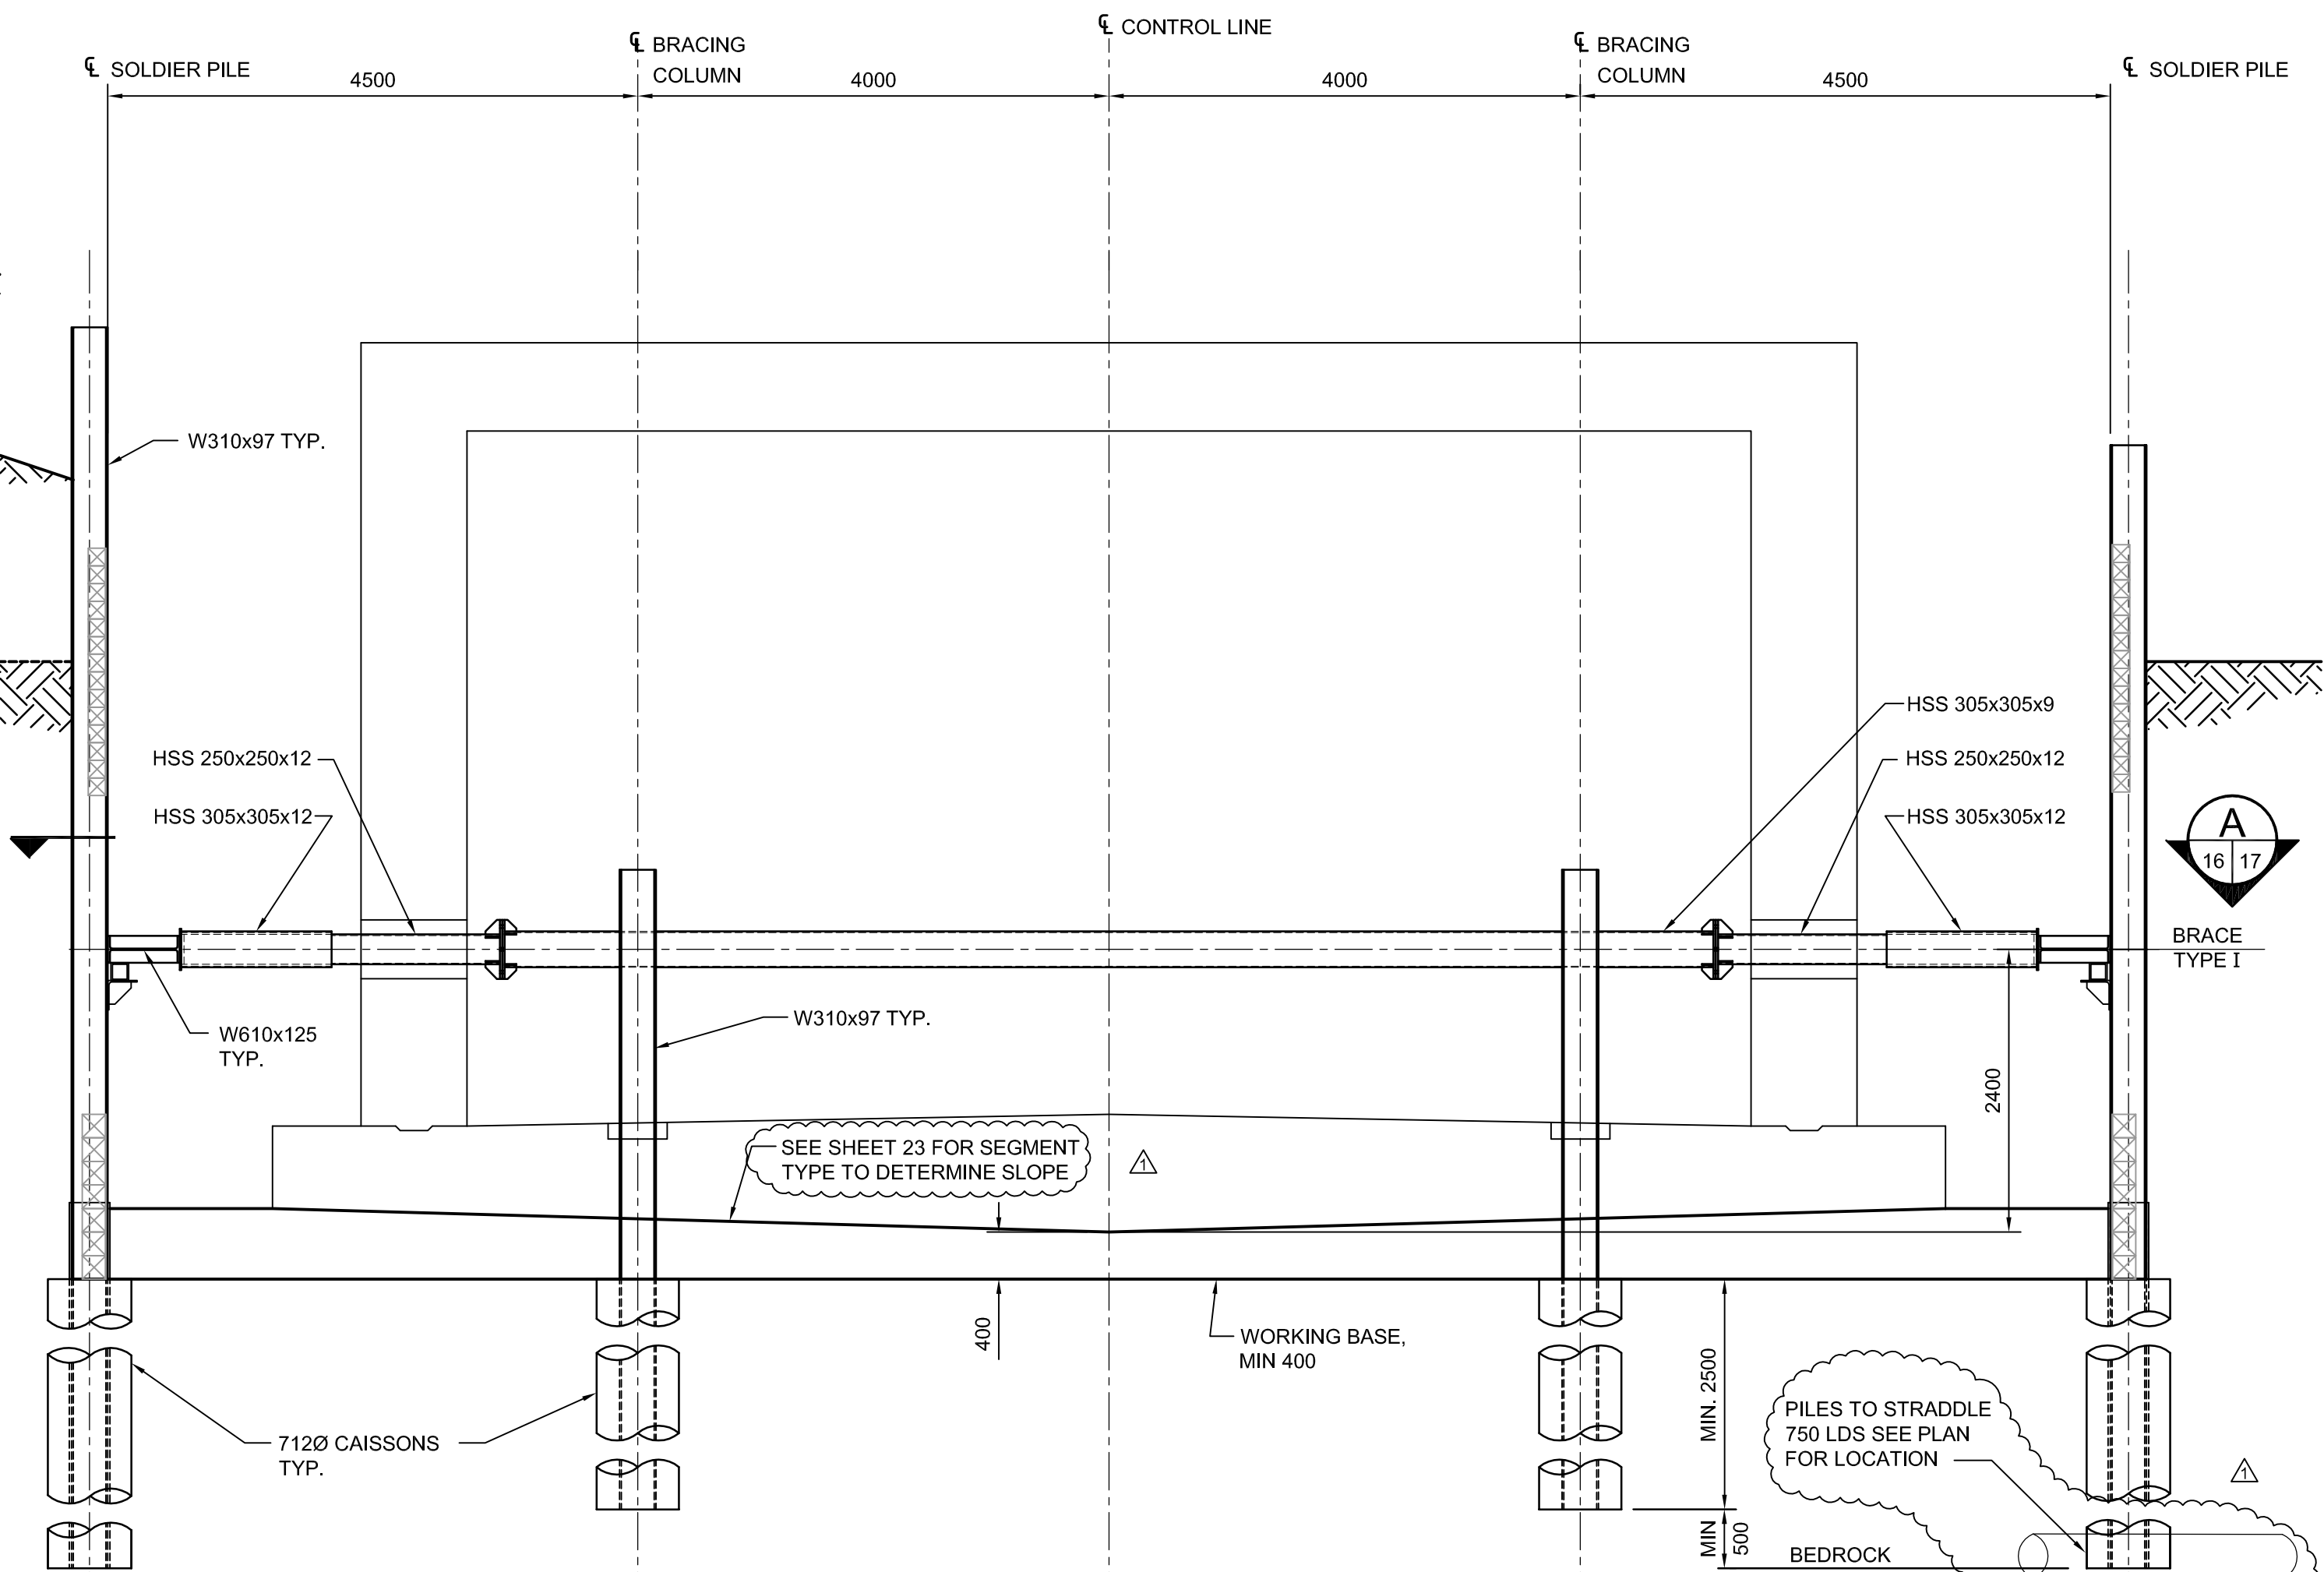

SECTION - SINGLE BRACE
SCALE 1:100

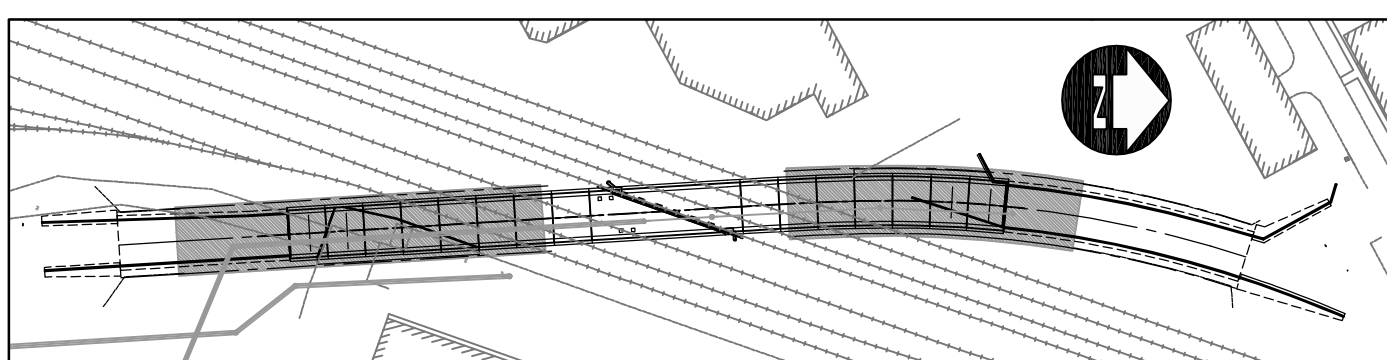

BRACED SHORING KEY PLAN
SCALE 1:2000




DO NOT SCALE THIS DOCUMENT. ALL MEASUREMENTS MUST BE OBTAINED FROM STATED DIMENSIONS. This drawing has been prepared for the use of AECOM's client and may not be used, reproduced or relied upon by third parties, except as agreed by AECOM and its client, as required by law or for use by governmental reviewing agencies. AECOM accepts no responsibility, and denies any liability whatsoever, to any party that modifies this drawing without AECOM's express written consent.

LOCATION UNDERGROUND	APPROVED STRUCTURES	B.M. ELEV.	DESIGNED BY	FK
SUPV. U/G STRUCTURES COMMITTEE	DATE		DRAWN BY	CAA
			CHECKED BY	RE/KC
			APPROVED BY	EBL
			HOR. SCALE	AS NOTED
			VERTICAL	
1	ISSUED FOR ADDENDUM 4	11.04.2009	DATE	2009.10.13
0	ISSUED FOR TENDER	10.13.2009	DATE	2009.10.13
NO.	REVISIONS	DATE	BY	DATE

RELEASER FOR CONSTRUCTION	DATE	2009.10.13
---------------------------	------	------------

ENGINEER'S SEAL	CONSULTANT PROJECT NO.	088813
-----------------	------------------------	--------

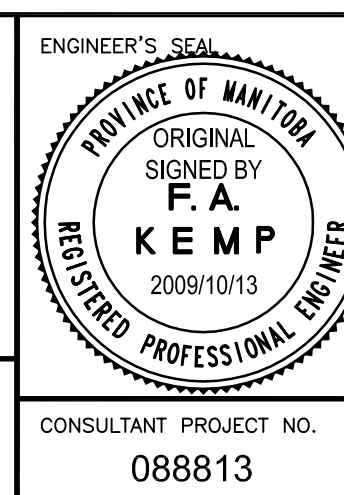

THE CITY OF WINNIPEG
TRANSIT DEPARTMENT

Winnipeg

SOUTHWEST RAPID TRANSIT CORRIDOR - STAGE 1
TRANSITWAY TUNNEL AT CN RIVER SUBDIVISION
MILEAGE 1.38 & ASSOCIATED WORKS

CITY DRAWING NUMBER: U237-09-16
SHEET 16 OF 73
CONSULTANT DRAWING NUMBER: C4-S1004-T

BRACED SHORING