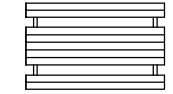
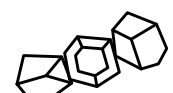
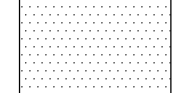
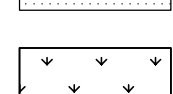
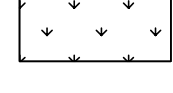

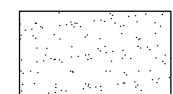
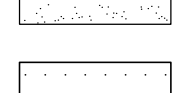
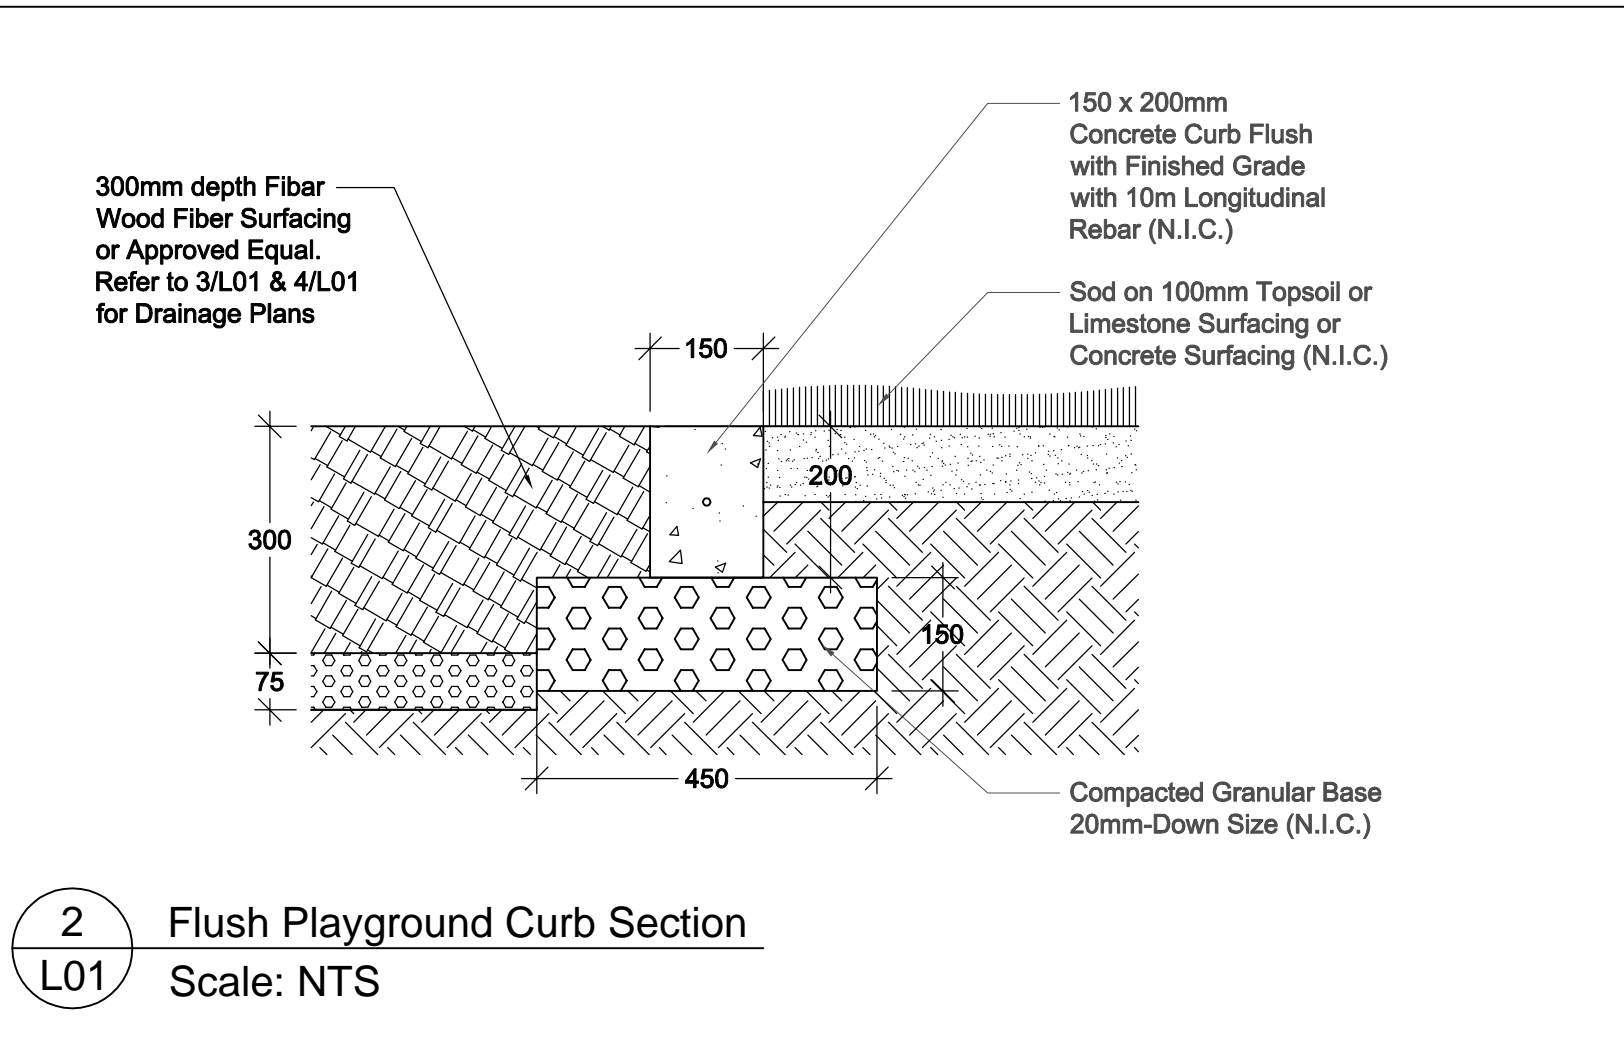
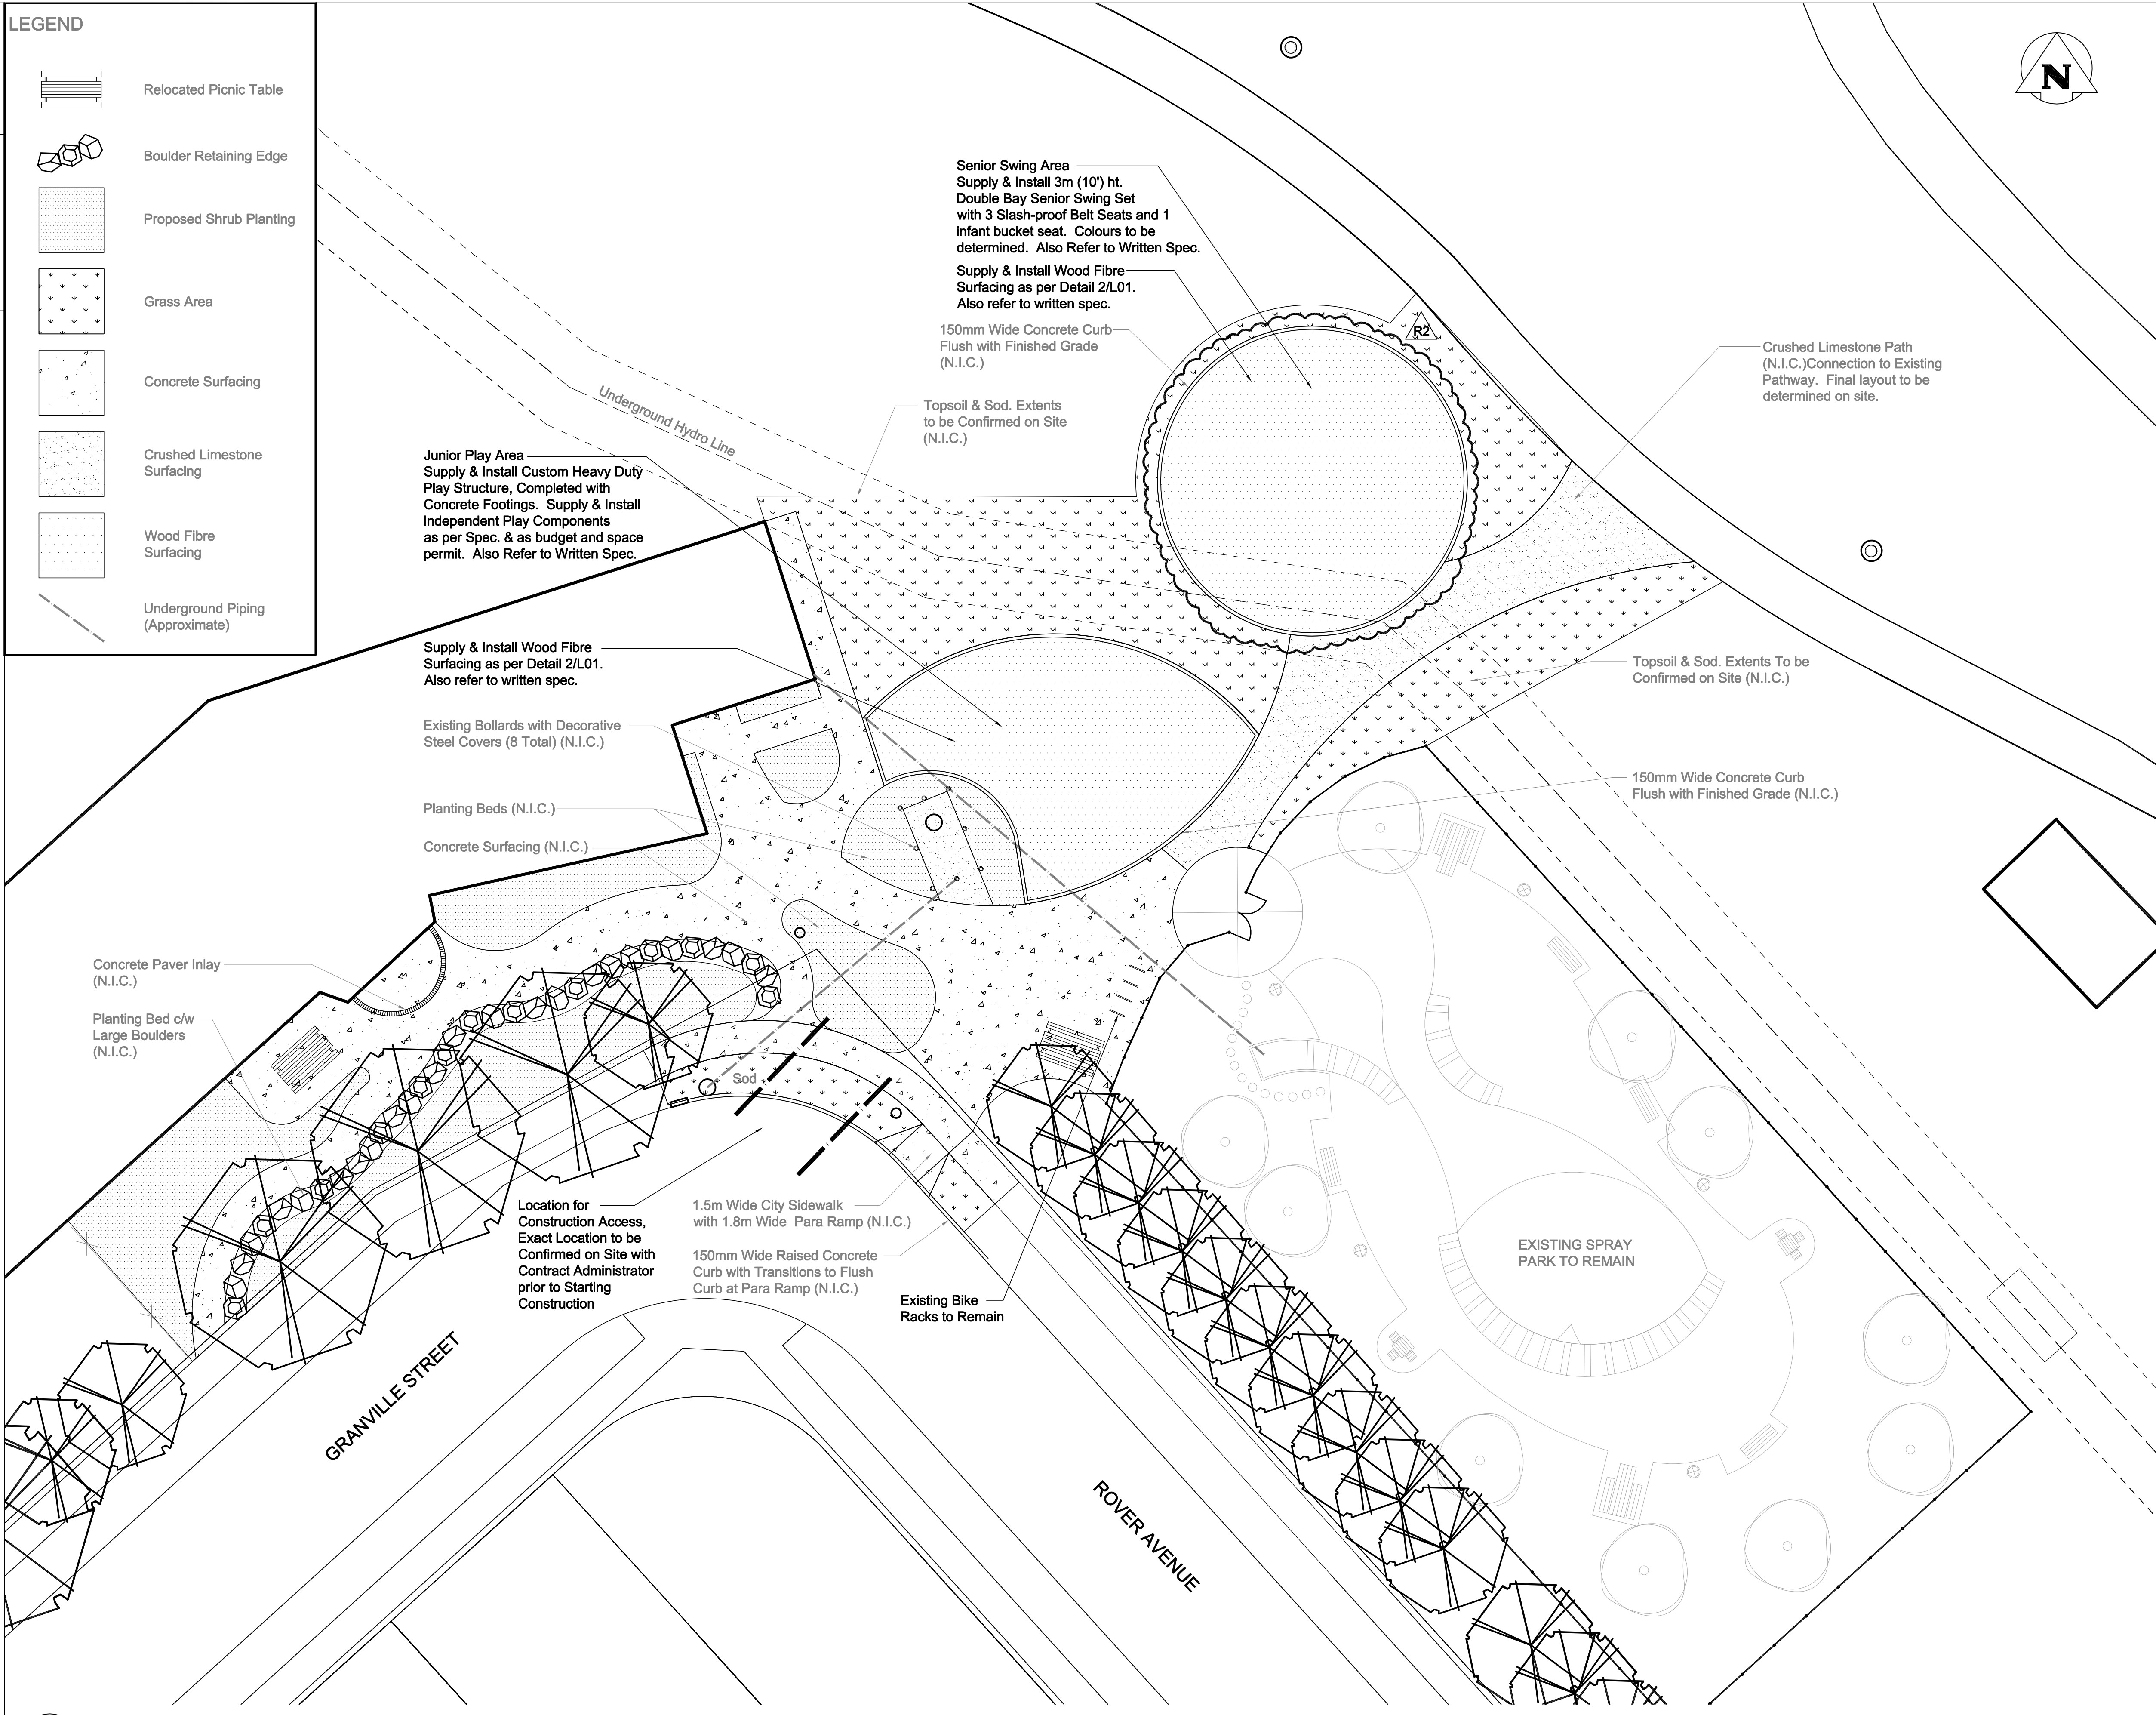


sheet size - Super A1 24" x 36" plot scale - 1:1 (metric)

LEGEND

-  Relocated Picnic Table
-  Boulder Retaining Edge
-  Proposed Shrub Planting
-  Grass Area
-  Concrete Surfacing
-  Crushed Limestone Surfacing
-  Wood Fibre Surfacing
-  Underground Piping (Approximate)




1 Site Plan
L01 Scale 1:150

**PRELIMINARY
FOR TENDER PURPOSES ONLY**

GENERAL NOTES

1. NO INSTALLATION OF ANY SUBSURFACE FEATURES (INCLUDING FURNITURE, PLAY EQUIPMENT, TREES) WITHIN 4M OF EXISTING UNDERGROUND HYDRO LINE. CONTRACTOR TO CONFIRM ALL EXISTING CONDITIONS, DIMENSIONS AND MATERIALS ON SITE AND REPORT ANY DISCREPANCIES TO THE CONTRACT ADMINISTRATOR PRIOR TO CONSTRUCTION.
2. LOCATION OF UNDERGROUND STRUCTURES AS SHOWN ARE BASED ON THE BEST INFORMATION AVAILABLE BUT NO GUARANTEE IS GIVEN THAT ALL EXISTING UTILITIES ARE SHOWN OR THAT THE GIVEN LOCATIONS ARE EXACT. CONFIRMATION OF EXISTENCE AND EXACT LOCATION OF ALL SERVICES MUST BE OBTAINED FROM THE INDIVIDUAL UTILITIES BEFORE PROCEEDING WITH CONSTRUCTION.
3. CONSTRUCTION ACCESS TO BE LIMITED TO THE ROUTES SPECIFIED ON SITE BY CONTRACT ADMINISTRATOR
4. ALL NOTES IN GREY INDICATE WORK TO BE COMPLETED BY OTHERS UNDER SEPARATE CONTRACT
5. LAYOUT AND GRADING TO BE APPROVED BY CONTRACT ADMINISTRATOR PRIOR TO ANY CONSTRUCTION OR REMOVAL
6. PLAY AREAS TO BE EXCAVATED BY SITE WORKS CONTRACTOR UNDER THE SUPERVISION OF MANITOBA HYDRO, ENSURE SUBGRADE GRADE TO DRAIN (MIN. 1%) PRIOR TO INSTALLATION OF PLAY SURFACE
7. CONCRETE CURB EDGING TO BE SUPPLIED AND INSTALLED BY SITE WORKS CONTRACTOR AS PER LAYOUT.

NO.	D / M / Y	REVISIONS	BY
R2	06/10/2009	REVISED SWING AREA	JW
R1	21/09/2009	REVISED SITE PLAN	JW
R0	21/09/2009	RELEASED FOR TENDER	JW

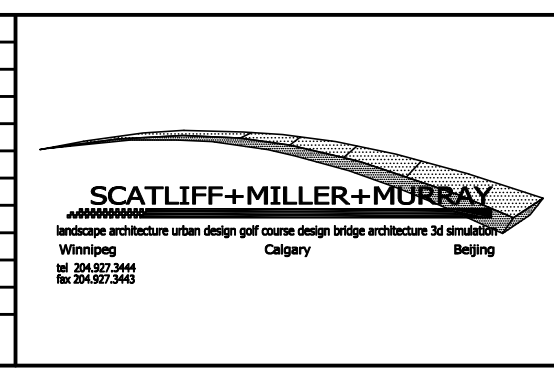

A. SECTION LETTER OR DETAIL NUMBER.
B. DRAWING WHERE SECTION OR DETAIL IS DRAWN.
OR
DRAWING WHERE SECTION OR DETAIL IS INDICATED.
--- SECTION OR DETAIL SHOWN ON SAME DRAWING.

SEAL

CLIENT	DESIGN BY	DRAWN BY	SCALE
City of Winnipeg	BGS/RCW	RCW/JW	AS SHOWN
PROJECT TITLE	CHECKED BY	APPROVED BY	DATE
Norquay CC Playground Development - Play Equipment	BGS	BGS	September 21, 2009
DRAWING TITLE	FILE NO.	SHEET NO.	
Site Plan & Details	7052	PE-L01	

CAD file name - XX