D SIZE 22" x 34" (559mm x 864mm)

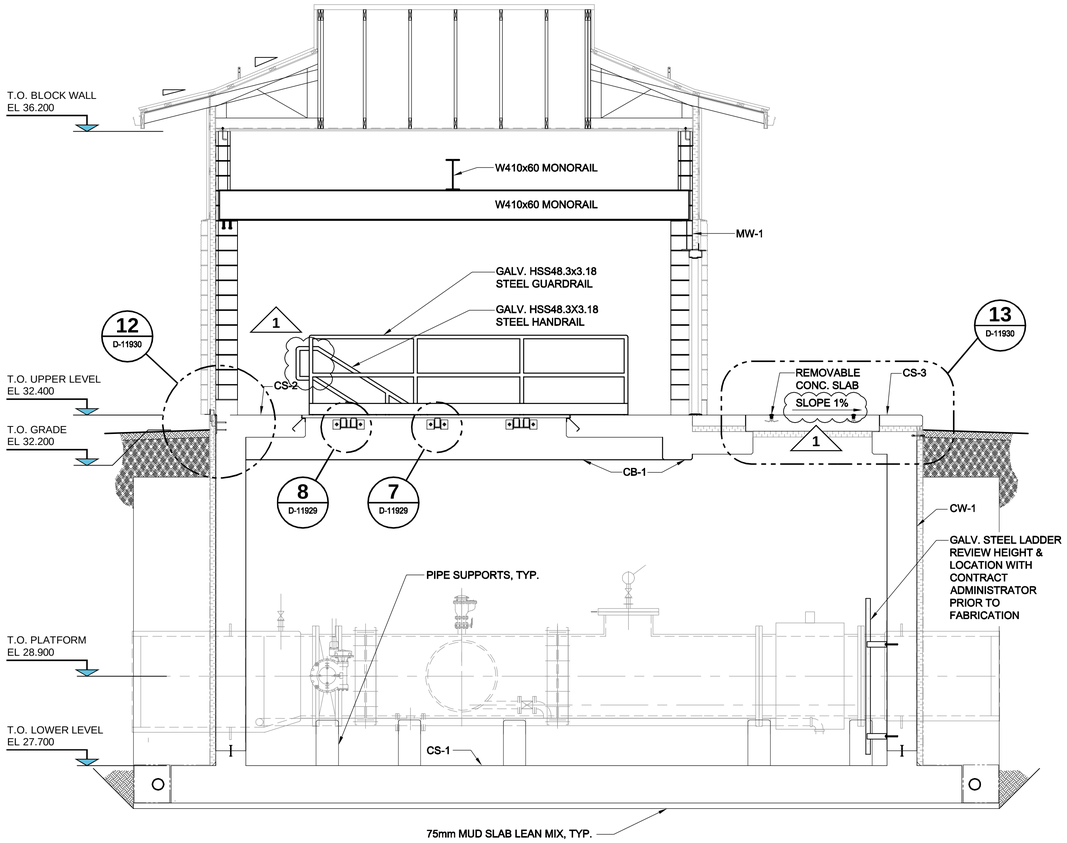

SECTION A
D-11923

0 400 800 1200 mm SCALE 1:40

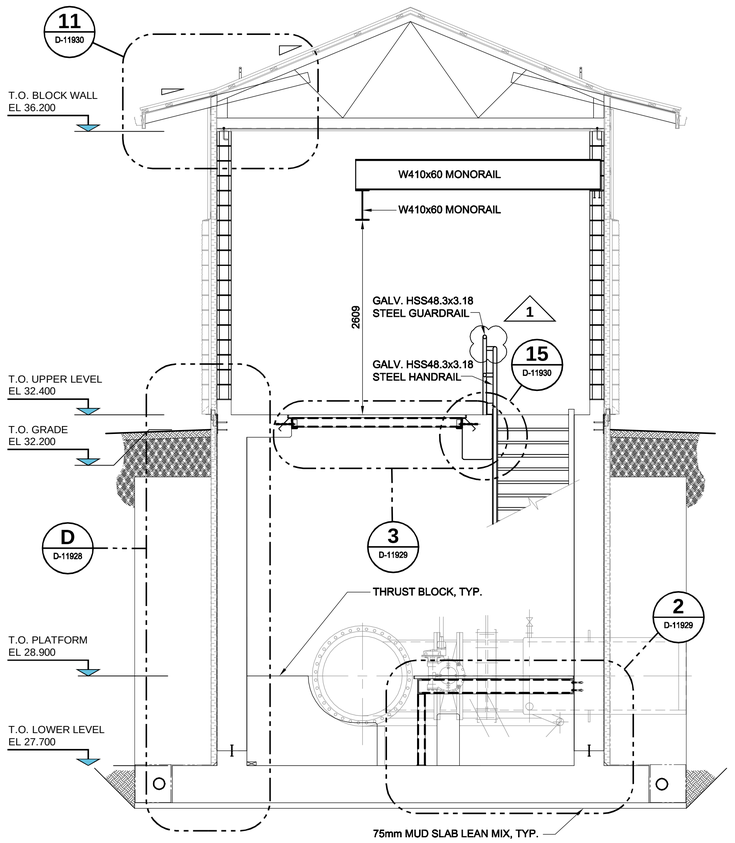

SECTION B
D-11923

0 400 800 1200 mm SCALE 1:40

BID OPPORTUNITY NO. 16-2010

LOCATION APPROVED
UNDERGROUND STRUCTURES

SUPR. U/G STRUCTURES COMMITTEE — DATE

NOTE:
LOCATION OF UNDERGROUND STRUCTURES AS SHOWN ARE BASED ON THE BEST INFORMATION AVAILABLE. BUT NO GUARANTEE IS GIVEN THAT ALL EXISTING UTILITIES ARE SHOWN OR THAT THE GIVEN LOCATIONS ARE EXACT. CONFIRMATION OF EXISTENCE AND EXACT LOCATION OF ALL SERVICES MUST BE OBTAINED FROM THE INDIVIDUAL UTILITIES BEFORE PROCEEDING WITH CONSTRUCTION.

NO.	REVISIONS	YY/MM/DD	BY
1	ISSUED FOR ADDENDUM 1	10/02/26	KK
0	ISSUED FOR CONSTRUCTION	10/02/08	KK

AECOM

This drawing has been prepared for the use of AECOM's client and may not be used, reproduced or relied upon by third parties, except as agreed by AECOM and its client, as required by law or for use by governmental reviewing agencies. AECOM accepts no responsibility, and denies any liability whatsoever, to any party that modifies this drawing without AECOM's express written consent.
Do not scale this document. All measurements must be obtained from stated dimensions.

DESIGNED BY	KK/GGP	CHECKED BY	GGP
DRAWN BY	KK	APPROVED BY	Bryan Weber
HOR. SCALE	1:40	RELEASED FOR CONSTRUCTION	KZ
VERT. SCALE	-		
DATE	10/02/09	DATE	FEB. 9/10

PROFESSIONAL'S SEAL

ORIGINAL SIGNED BY
B.F. ABDUL WAHID
2010/02/08

CONSULTANT DRAWING NO.
D265-250-00_01-S-3001_RX.dwg

Winnipeg

THE CITY OF WINNIPEG
WATER AND WASTE DEPARTMENT

BRANCH I AQUEDUCT VALVE CHAMBER AT McPHILLIPS STREET PUMPING STATION

STRUCTURAL
BUILING SECTIONS
-

SHEET 17 OF 28

CITY DRAWING NUMBER
D-11927 REV 1

PLOT: 10/02/26 11:08:57 AM
AECOM FILE NAME: D265-250-00_01-S-3001_RX.dwg Saved By: dippenstriek
AECOM REVIEW | DRFT CHK | KK