


9 - QUANTITY : 12

NOTE: WINDOWS ON SOUTH FACADE ARE ACID ETCHED

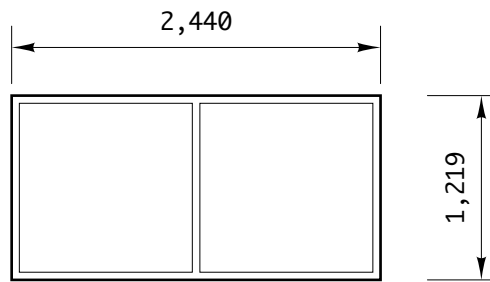

10 - QUANTITY : 4

1
AD04

WINDOW PROFILE CHANGES

SCALE 1:50

WINDOW PROFILE CHANGES:

- QUANTITY OF WINDOW TYPE 9 REVISED.
- NEW PROFILE TYPE 10 ADDED.
- NEW WINDOW PLACEMENT SHALL BE AS PER AD02.

AD-04

SINCLAIR PARK COMMUNITY CENTRE

harold funk architect inc.

NOTE: THIS DRAWING IS PROVIDED FOR CLARIFICATION AND REVISION PURPOSES AND SHALL BE READ IN CONJUNCTION WITH OTHER CONSTRUCTION DOCUMENTATION. EXTRANEOUS INFORMATION HAS BEEN REMOVED FOR CLARITY. NOTIFY THE CONTRACT ADMINISTRATOR IN THE EVENT OF QUESTIONS.

Project # 08-011
 Drawn: G.S.
 Reviewed: H.F.
 Date: 30th March 2010

Harold Funk Architect Inc.
 Architecture and Urban Design
 401-55 Donald Street, Winnipeg, Manitoba R3C 1L8
 T (204) 943-5087 info@funkarchitect.com
 F (204) 949-9231 funkarchitect.com