


DISTRIBUTION PANEL

MD-1

1000AMP
120/208V/3 ϕ /4W
XXKA S.C.I.A.

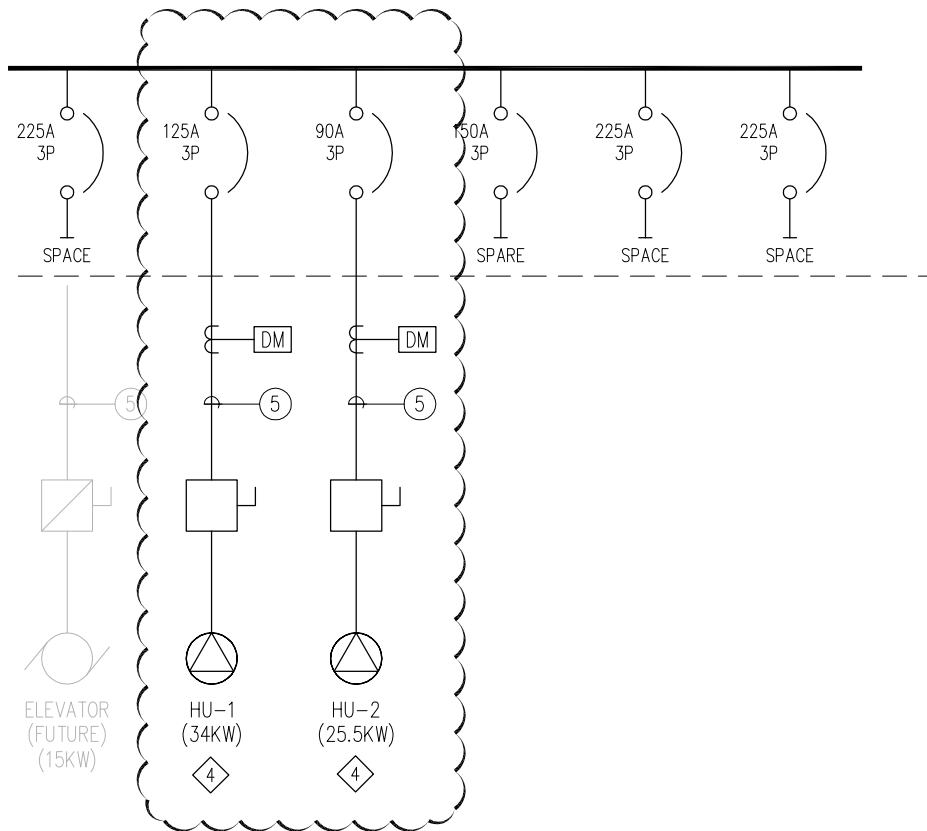


NOTES:

1. PROVIDE LEED APPROVED DIGITAL MONITOR/METERING DEVICE.

TOTAL OF FOUR(4) JUNCTION BOXES C/W FOUR(4) METERS SHALL BE PROVIDED.

4. HU-1 AND HU-2 SHALL BE INCLUDED IN SEPARATE PRICE #11.

<p>5878</p>  <p>MCW / AGE Consulting Professional Engineers 210-1821 Wellington Avenue Winnipeg, Manitoba, R3H 0G4 Phone - (204) 779-7900 Fax - (204) 779-1119 E-Mail: mcw_winn@mcw.com</p>	<p>PROJECT:</p> <p>SINCLAIR COMMUNITY CENTRE ADDITION & RENOVATIONS</p>		<p>REF. DWG. NO.</p> <p>E4.1</p>
	<p>DESCRIPTION:</p> <p>SINGLE LINE DISTRIBUTION</p>		<p>DWG. NO.</p> <p>RE-8</p>
	<p>DATE:</p> <p>2010-03-31</p>	<p>DRAWN BY:</p> <p>PCS</p>	<p>SCALE:</p> <p>1:100</p>