



PLOTTED ON 2010-04-05 BY RUFINO SANTOS  
 DOCUMENT SAVED IN H:\5800\5878\ELEC\RE-14,15\_ALT\_5878-EL2.1.1\_M\_R1.DWG

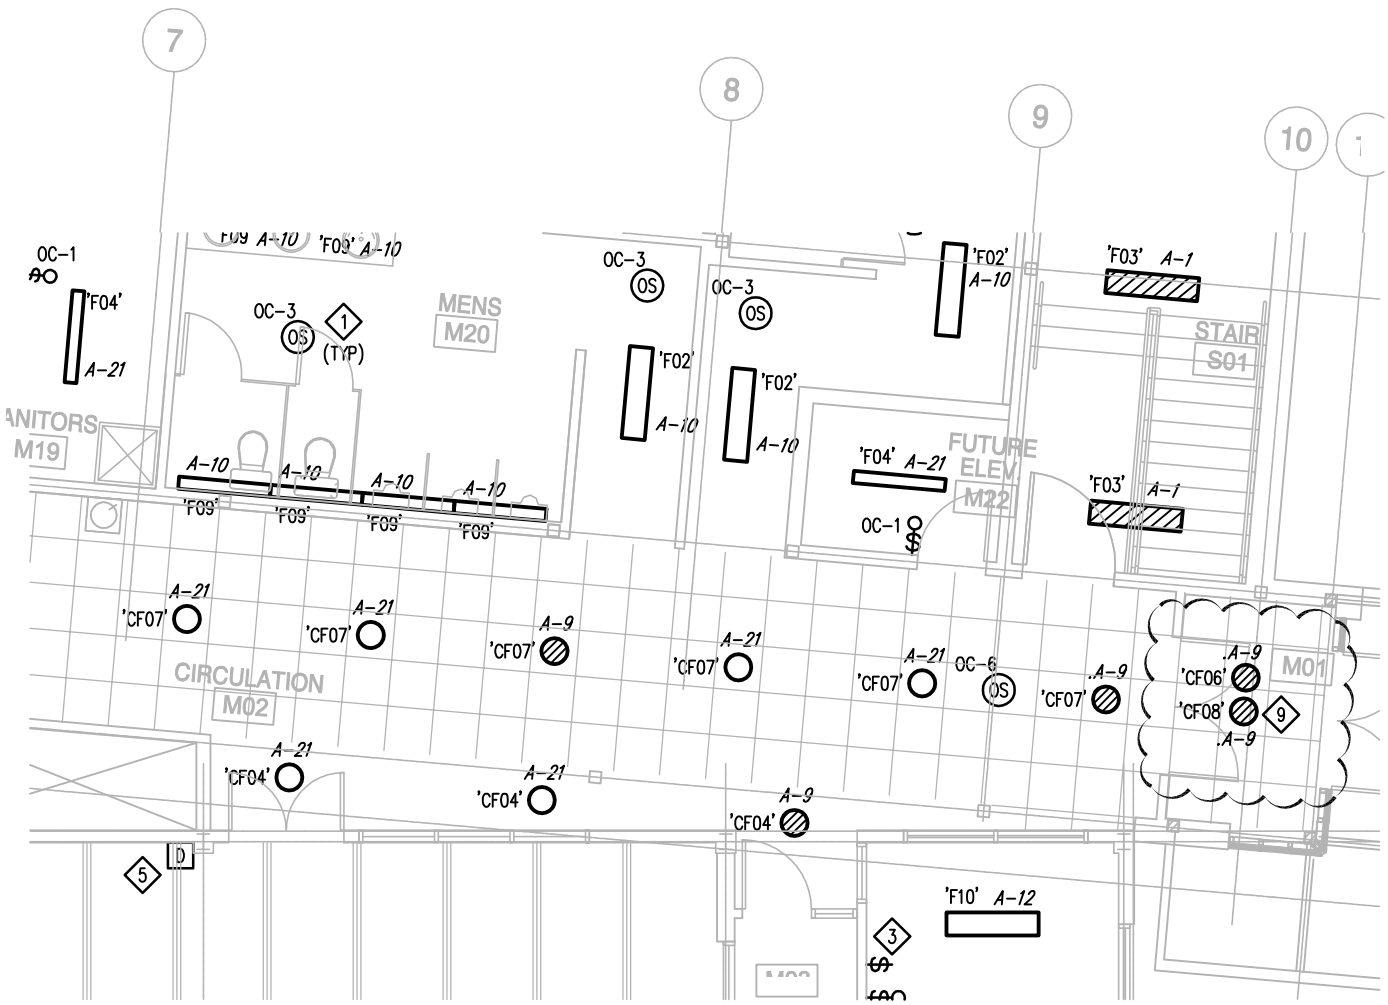

**NOTES:**

- 7. TYPE 'F08' AND 'F09' LUMINAIRES SHALL BE INSTALLED C/W MINIMUM #10 WIREGUARD.
- 8. PROVIDE SEPARATE PRICE FOR ALTERNATE LIGHTING LAYOUT. THIS ITEM SHALL BE INCLUDED IN SEPARATE PRICE #3.
- 9. MOUNTED IN VESTIBULE CEILING.

<p>5878</p>  <p><b>MCW / AGE</b>          Consulting Professional Engineers          210-1821 Wellington Avenue          Winnipeg, Manitoba, R3H 0G4          Phone - (204) 779-7900 Fax - (204) 779-1119          E-Mail: mcw_wpg@mcw.com</p>	PROJECT:		REF. DWG. NO.
	<p>SINCLAIR COMMUNITY CENTRE          ADDITION &amp; RENOVATIONS</p>		EL2.1
	DESCRIPTION:		DWG. NO.
	<p>LIGHTING LAYOUT</p>		RE-15
DATE:	DRAWN BY:	SCALE:	ISSUED WITH:
2010-04-05	PCS	1:100	ADD#02ME