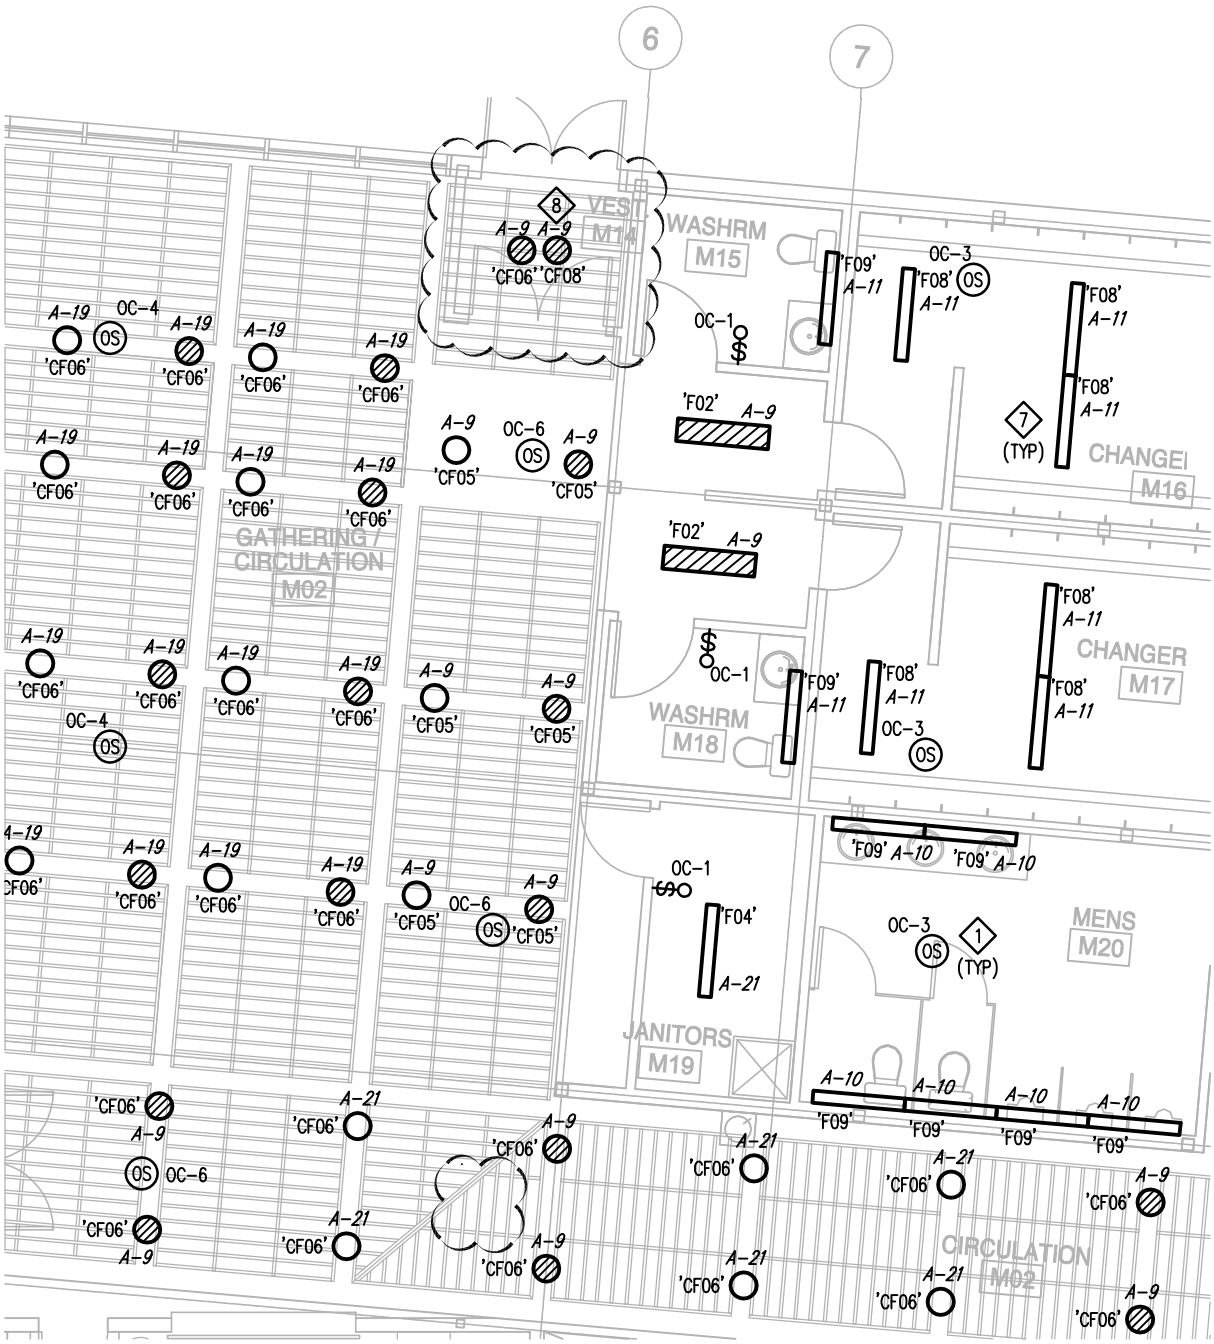


**NOTES:**

7. TYPE 'F08' AND 'F09' LUMINAIRES SHALL BE INSTALLED C/W MINIMUM #10 WIREGUARD.
8. MOUNTED IN VESTIBULE CEILING.


5878

MCW

**MCW / AGE**

*Consulting Professional Engineers*

*210-1821 Wellington Avenue*

*Winnipeg, Manitoba, R3H 0G4*

*Phone - (204) 779-7900 Fax - (204) 779-1119*

*E-Mail: mcw_wpg@mcw.com*


| PROJECT: | REF. DWG. NO. |
|---|---|
| SINCLAIR COMMUNITY CENTRE ADDITION & RENOVATIONS | EL2.1 |
| DESCRIPTION: LIGHTING LAYOUT | DWG. NO. RE–16 |
| DATE: 2010–04–05 / DRAWN BY: PCS / SCALE: 1:100 | ISSUED WITH: ADD#02ME |