NOTES:

1. COORDINATE LUMINAIRE LOCATIONS WITH PIPING AND MECH. DUCTING, WHERE REQUIRED SUSPEND UNITS BELOW SUCH EQUIPMENT.
2. UTILIZE PVC JACKETTED TECK CABLE FOR ALL POWER WIRING. WIRING FOR LIGHTING, RECEPTACLES AND COMMUNICATIONS TO BE IN RIGID ALUMINUM CONDUIT.
3. ALL CONDUIT TO BE MINIMUM 19mmø CONDUIT UNLESS OTHERWISE NOTED.

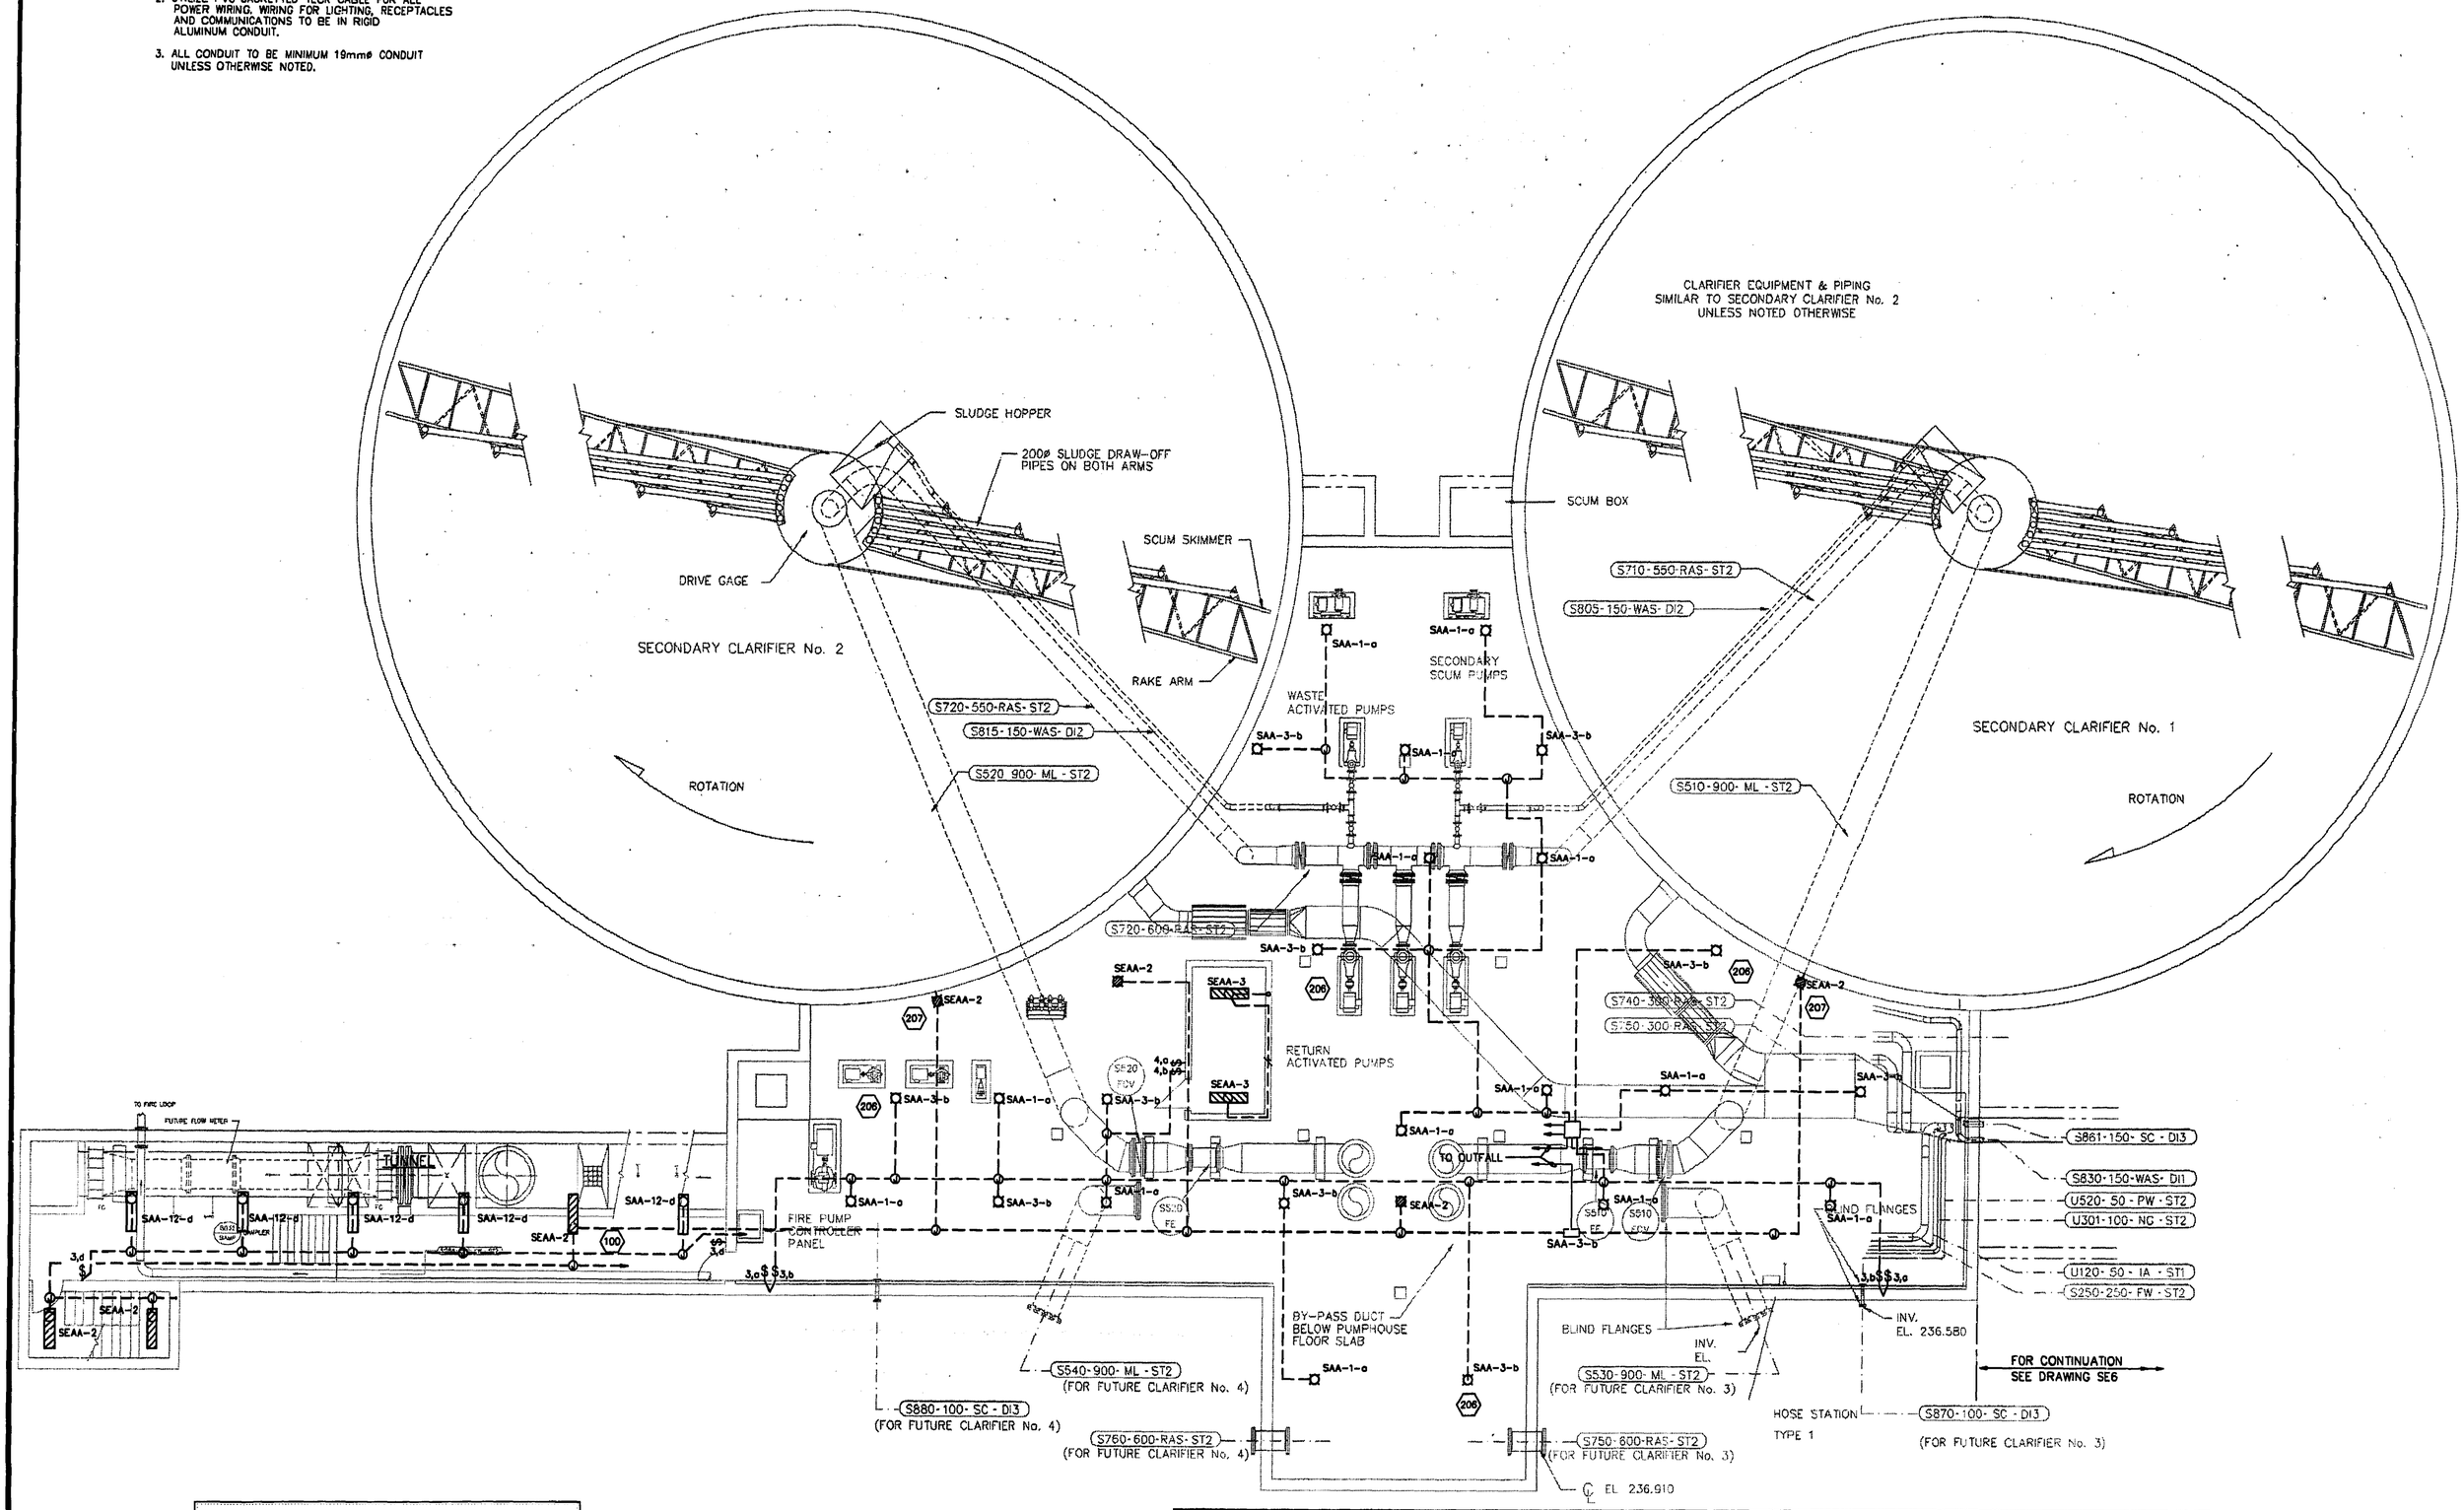

THE ENGINEER THAT SEALED THIS DRAWING IS RESPONSIBLE FOR ONLY THE AS-CONSTRUCTED CHANGES ON THIS DRAWING.

THE ORIGINAL DESIGN WAS THE RESPONSIBILITY OF THE DESIGN ENGINEER WHO SEALED THE ISSUED FOR TENDER DRAWINGS IN 1991.

REID, CROWTHER & PARTNERS LIMITED
WINNIPEG

AS CONSTRUCTED

SIG. ..... DATE MAY 23/94

detail symbol

A detail number
B drawing where detail shown
C cross reference to drawing where detail taken

NO.	REVISIONS	DATE	BY
1	AS BUILT	93/11	DE
0	ISSUED FOR TENDER		

B.M. 69-006
ELEV. 237.636 m

Reid Crowther

DESIGNED BY	LT	CHECKED BY	DJS
DRAWN BY	EJS	APPROVED BY	
HOR. SCALE: VERTICAL:	1:100	RELEASED FOR CONSTRUCTION:	
DATE	91-06-06	DATE	

ENGINEER'S SEAL
PROVINCE OF MANITOBA
F. STRYK
REGISTERED PROFESSIONAL ENGINEER
Dec. 9. 95

CONSULTANT DRAWING NO. 60910 - SE2

THE CITY OF WINNIPEG
WORKS AND OPERATIONS DIVISION
WATERWORKS WASTE AND DISPOSAL DEPT.

WEST END WATER POLLUTION CONTROL CENTRE
AREA S - SECONDARY CLARIFIERS

SECONDARY PUMPHOUSE LOWER LEVEL ELECTRICAL LIGHTING LAYOUT

CITY DRAWING NUMBER
SHEET OF
WEP-237

WEWPC-1
PEL-SE1 A1 1:100
91-06-06

File # WS 10292