



D SIZE 22" x 34" (559mm x 864mm)

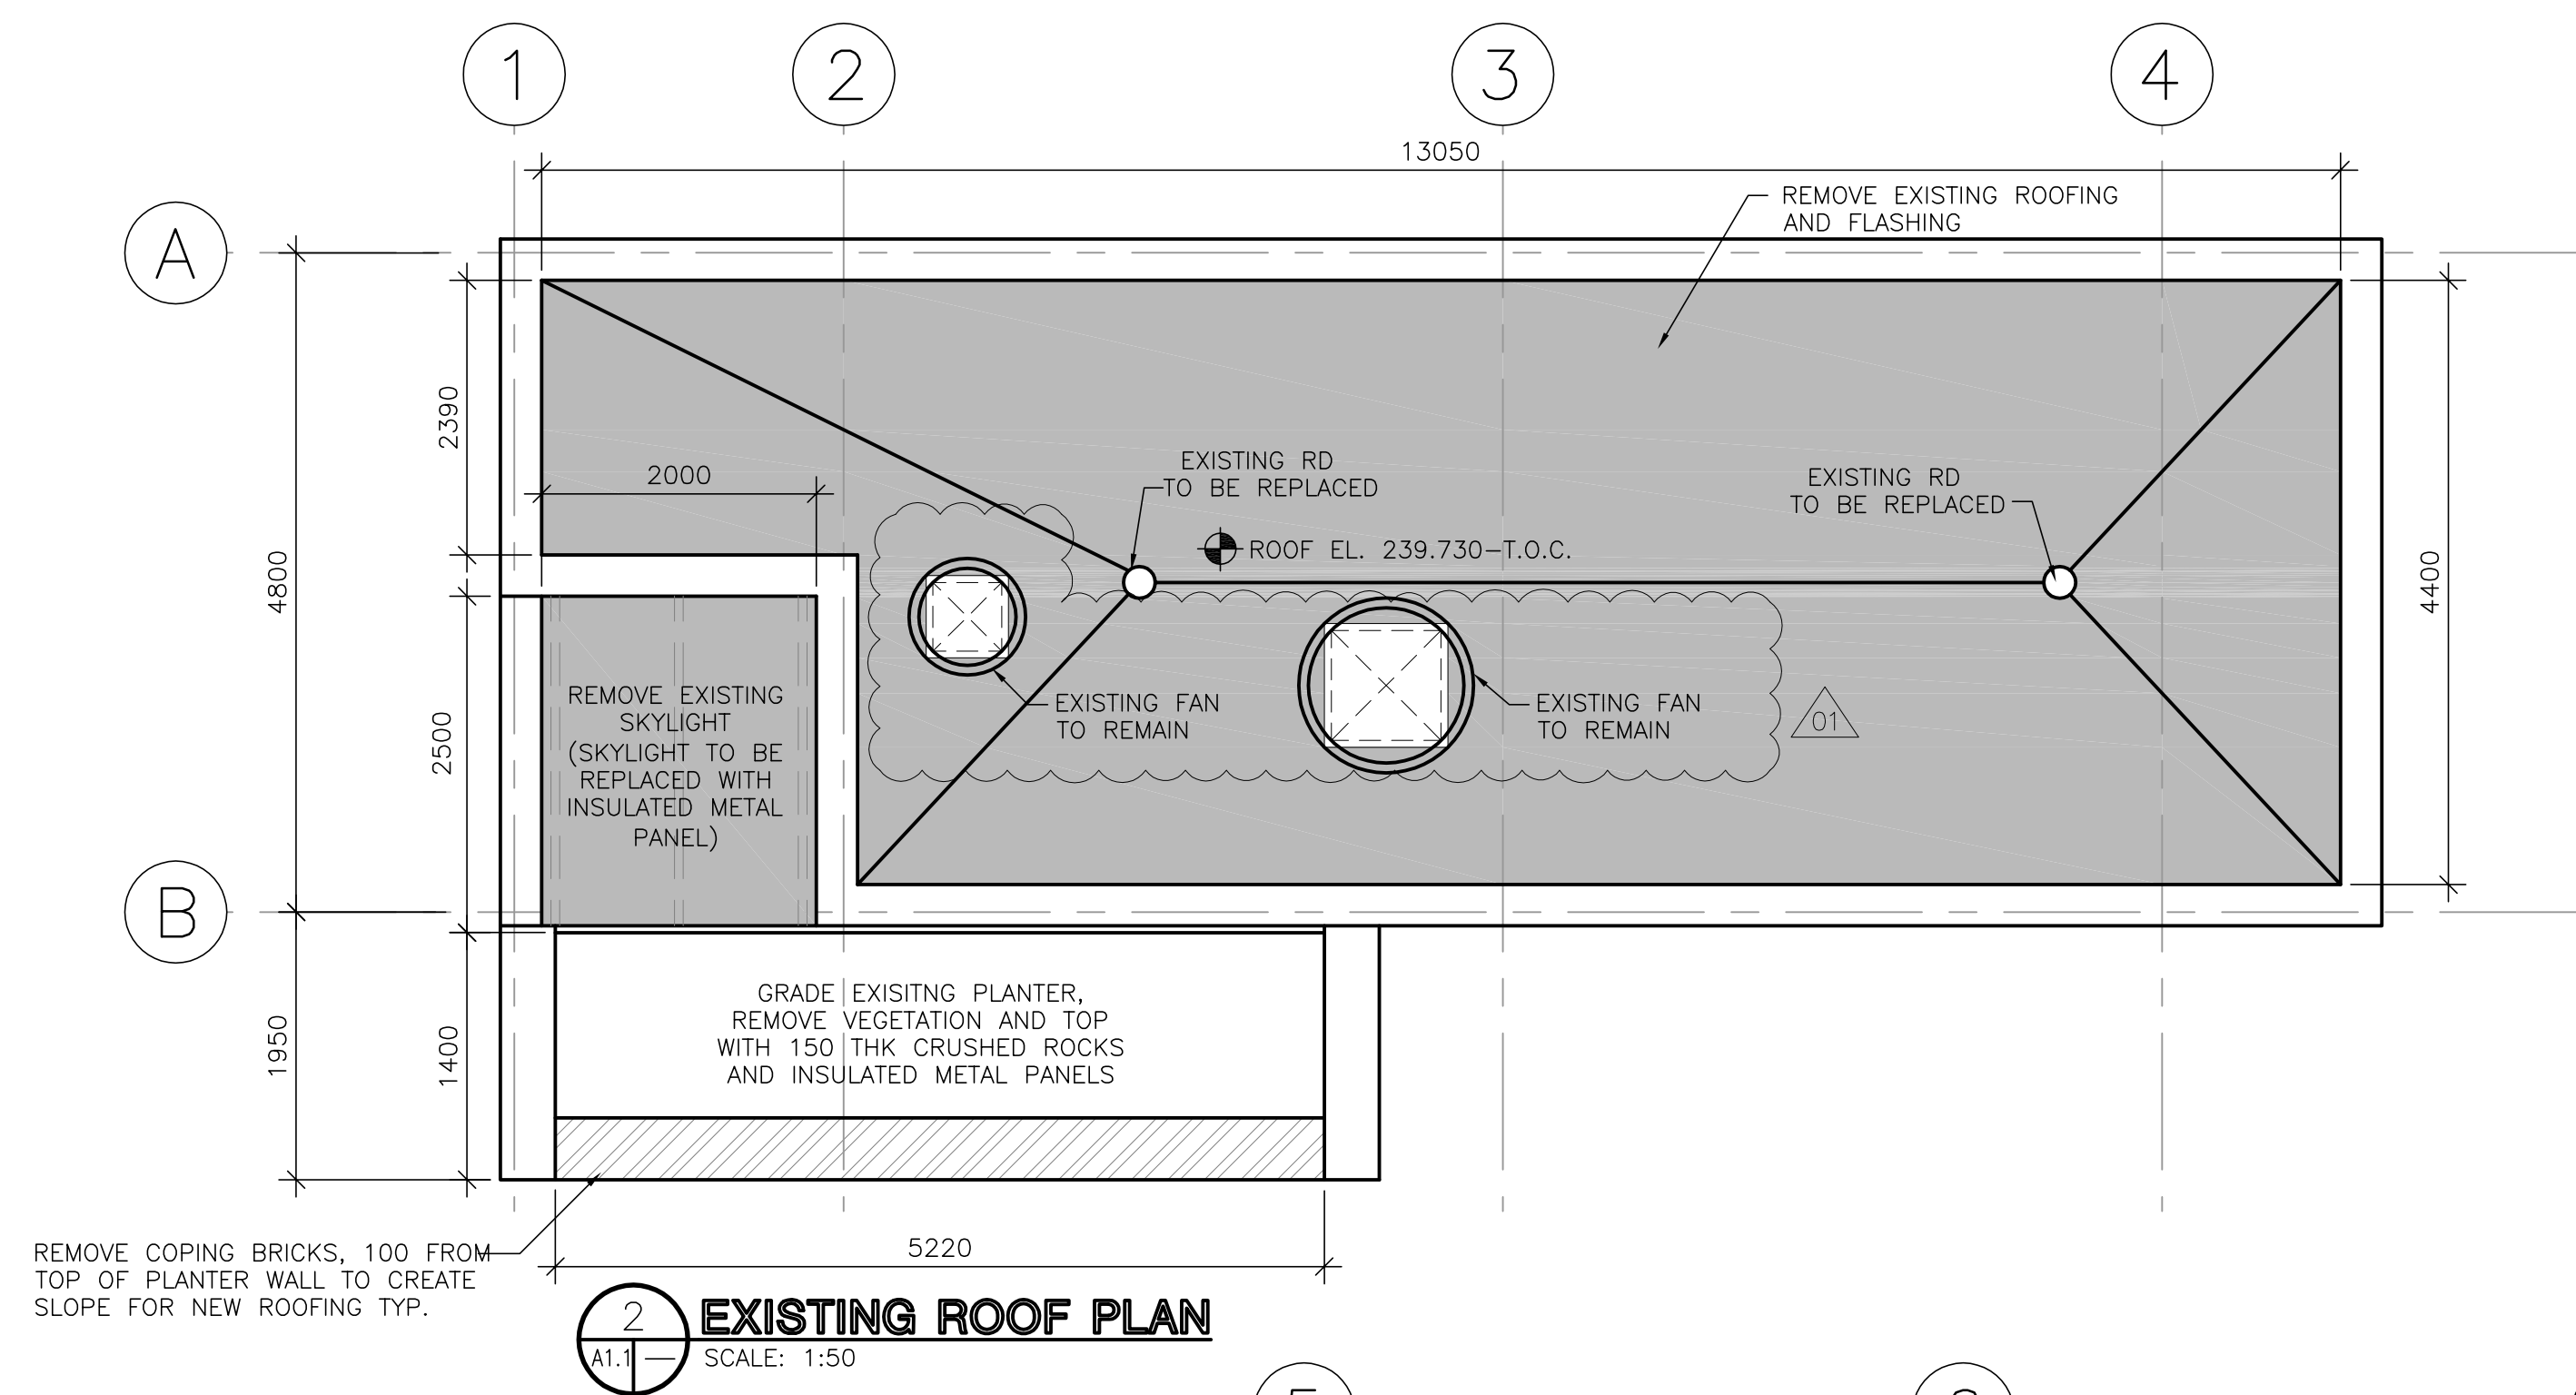


REMOVE COPING BRICKS, 100 FROM TOP OF PLANTER WALL TO CREATE SLOPE FOR NEW ROOFING TYP.

**2 EXISTING ROOF PLAN**  
A1.1 SCALE: 1:50

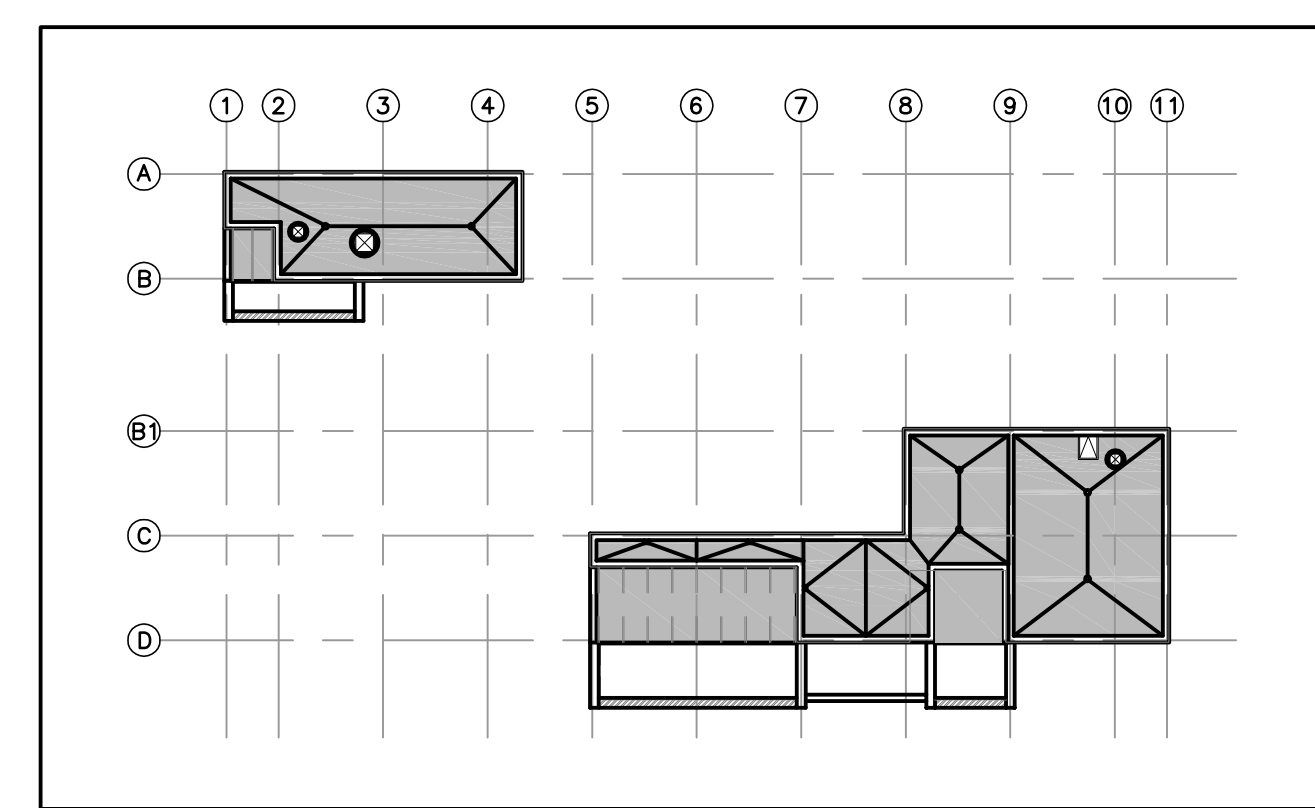

**KEY PLAN NTS**

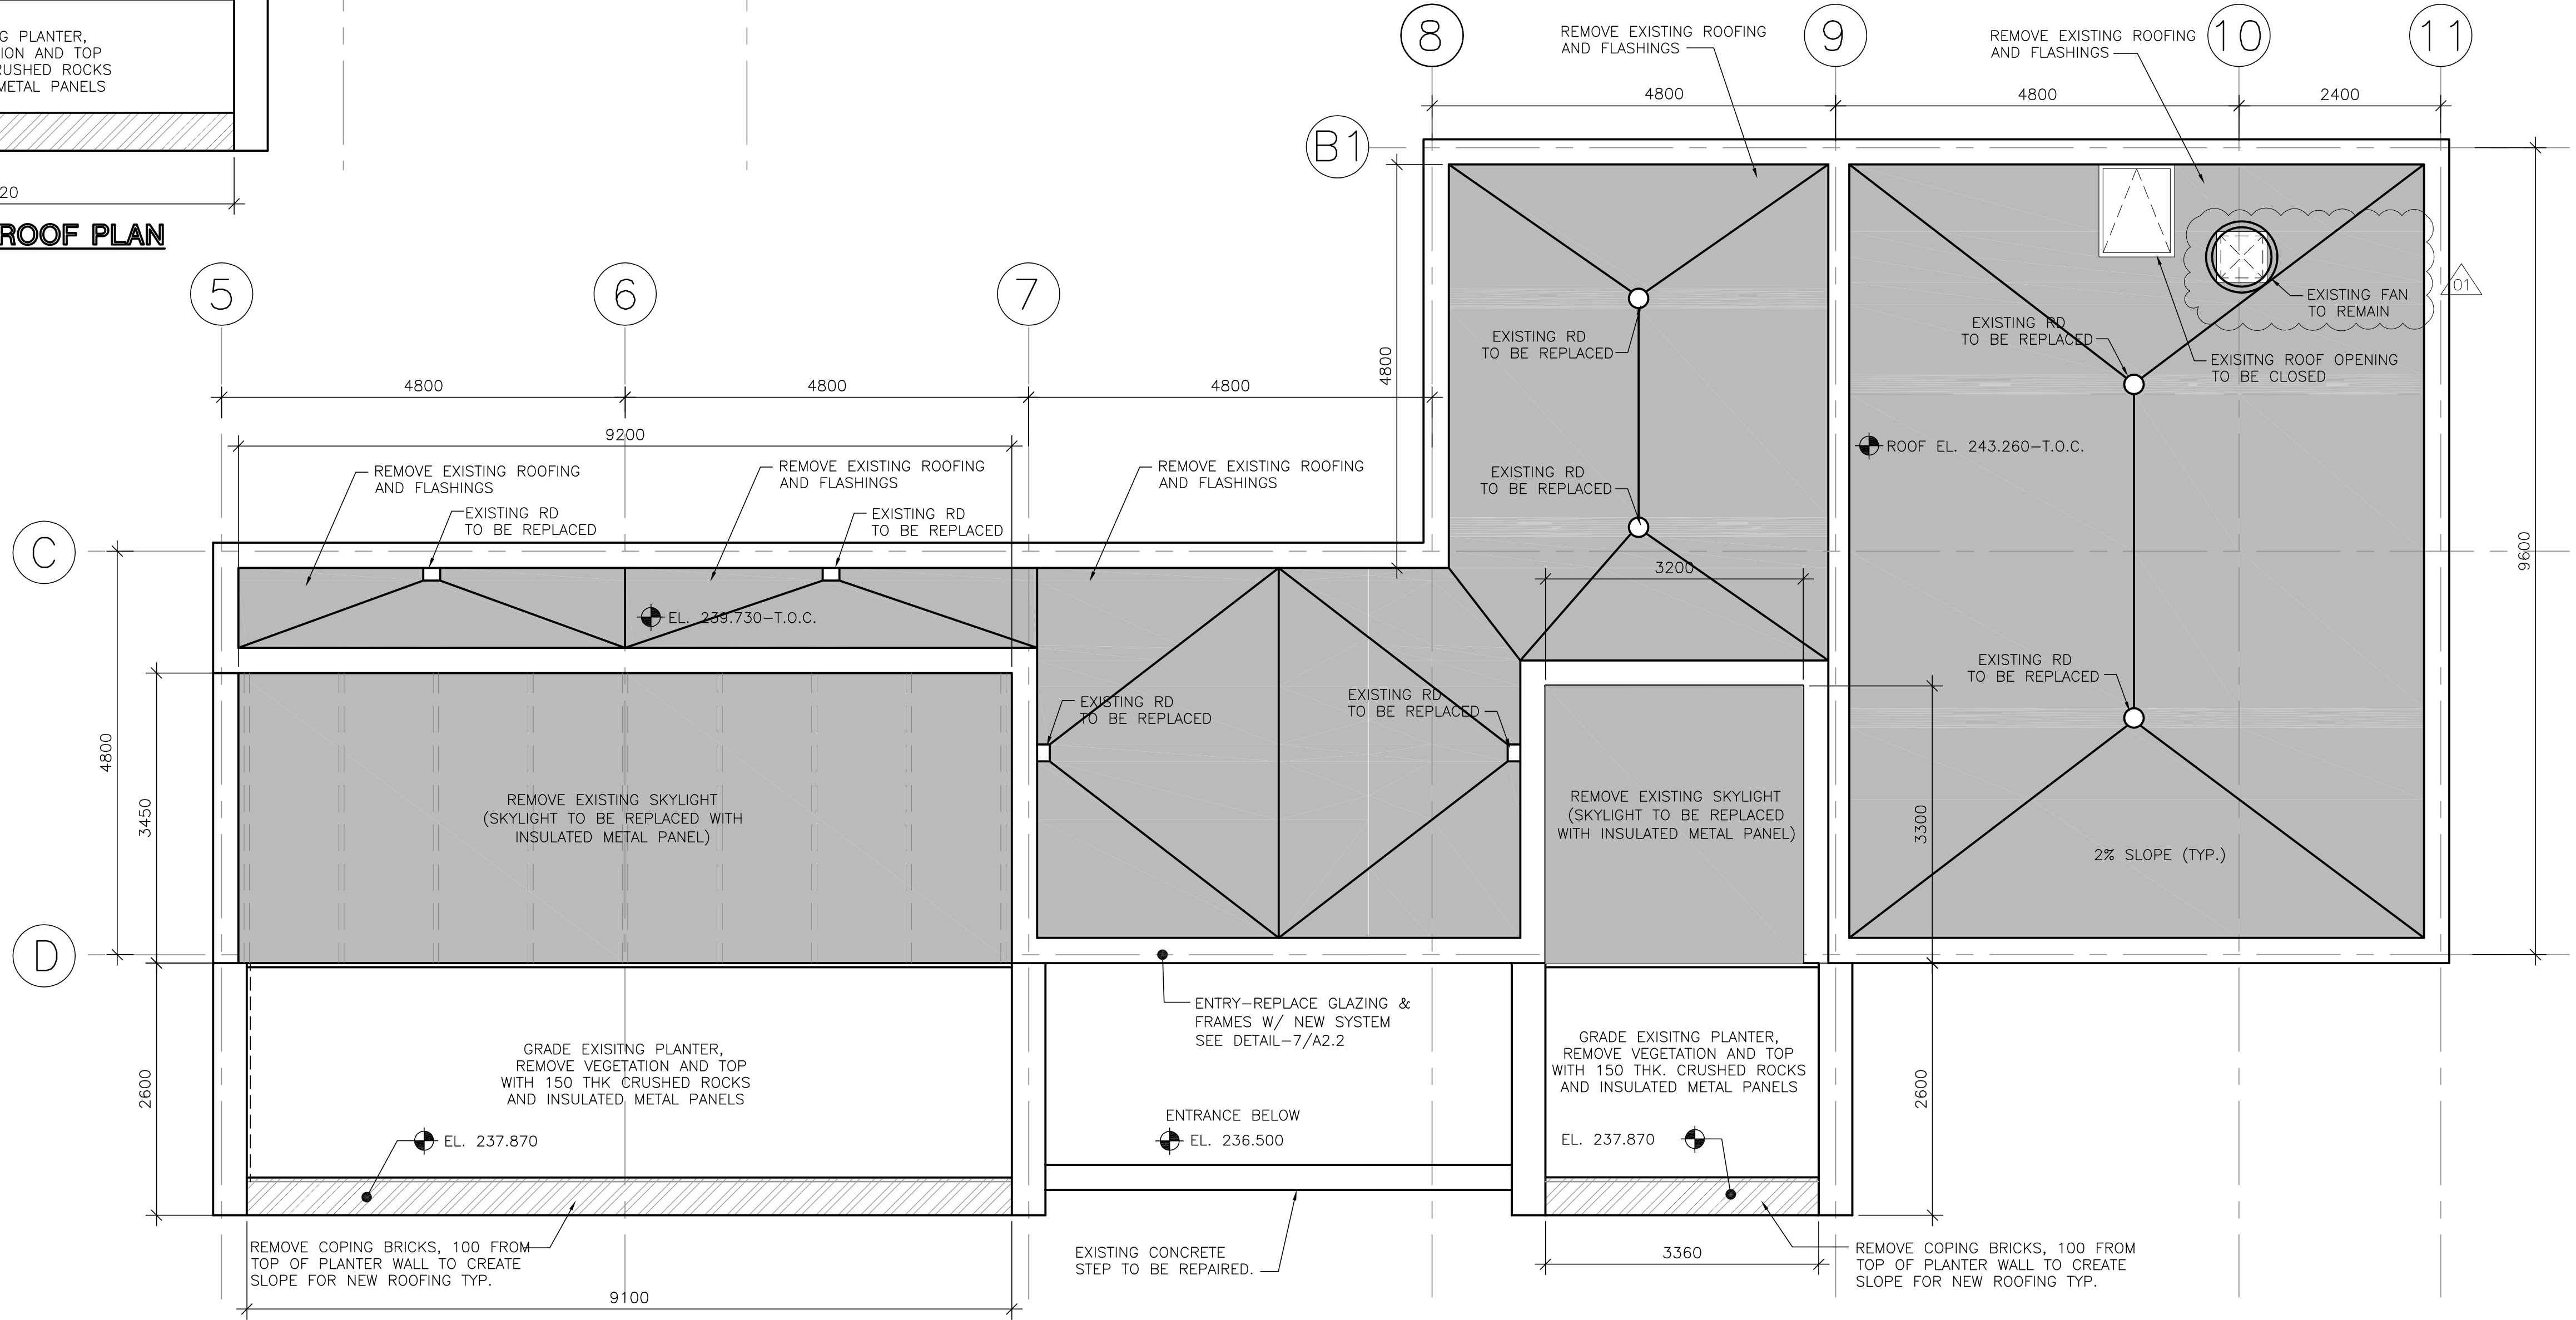

**LEGEND:**  
 EXISTING ROOFING, FLASHING AND ROOF DRAIN TO BE REMOVED  
 EXISTING PLANTER COPING BRICK TO BE REMOVED

**1 EXISTING ROOF PLAN**  
A1.1 SCALE: 1:50



**LOCATION APPROVED UNDERGROUND STRUCTURES**  
 SUPR. UG STRUCTURES COMMITTEE DATE  
 NOTE: LOCATION OF UNDERGROUND STRUCTURES AS SHOWN ARE BASED ON THE BEST INFORMATION AVAILABLE. BUT NO GUARANTEE IS GIVEN THAT ALL EXISTING UTILITIES ARE SHOWN OR THAT THE GIVEN LOCATIONS ARE EXACT. CONFIRMATION OF EXISTENCE AND EXACT LOCATION OF ALL SERVICES MUST BE OBTAINED FROM THE INDIVIDUAL UTILITIES BEFORE PROCEEDING WITH CONSTRUCTION.

01	ISSUED FOR ADDENDUM-1	11/05/12	AL
00	ISSUED FOR TENDER	11/05/03	AL
NO.	REVISIONS	Y/M/MDD	BY

**Neil Cooper Architect Inc.**  
 10-395 Berry Street, Winnipeg, Manitoba R3J 1N6  
 Phone (204) 885-3855 Fax (204) 831-7148

DESIGNED BY	NC	CHECKED BY	NC
DRAWN BY	AG/AL	APPROVED BY	NC
HOR. SCALE	1:50	RELEASED FOR CONSTRUCTION BY:	JESSICA McCOMBE
VERT. SCALE	1:50	ORIG. SIGNED:	JESSICA McCOMBE
DATE		DATE	03 MAY 2011



BID OPPORTUNITY NO. 377-2011

**THE CITY OF WINNIPEG**  
**WATER AND WASTE DEPARTMENT**

**DEACON BOOSTER PUMPING STATION BLDG UPGRADES & MAINTENANCE**

DEMOLITION PLAN

SHEET 1 OF 3	CITY DRAWING NUMBER
1-0620D-B0001-001	REV 01