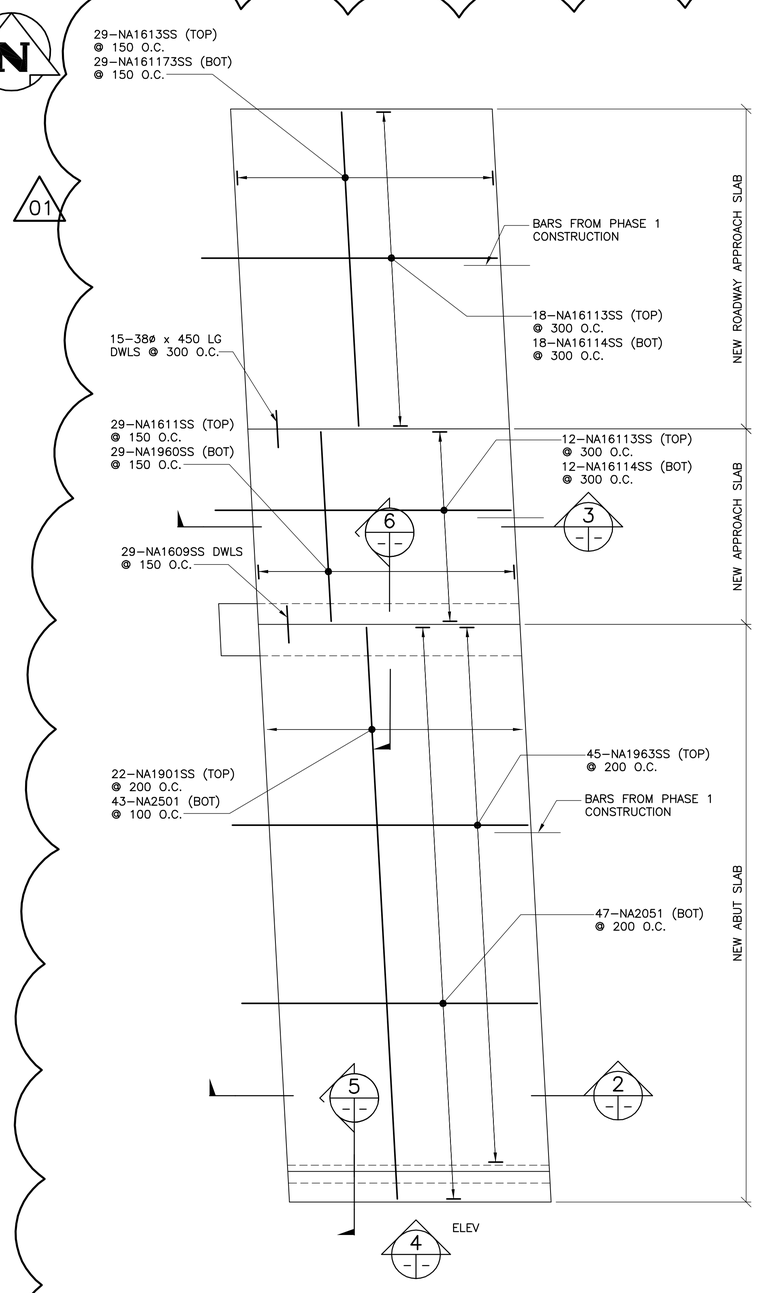

1 ABUTMENT SLAB – PHASE 1A REINFORCING
1 : 50

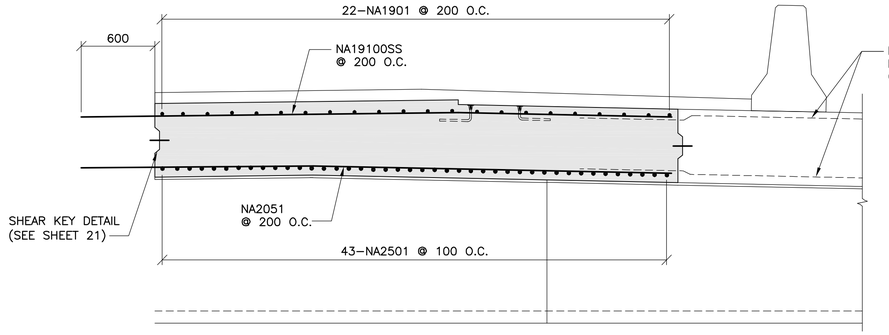

2 SECTION @ ABUTMENT SLAB
1 : 25

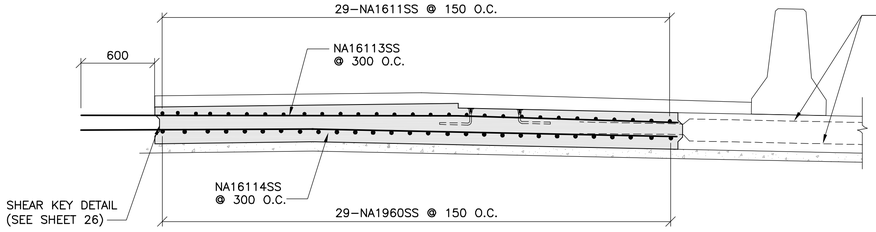

3 SECTION @ APPROACH & ROADWAY SLAB
1 : 25

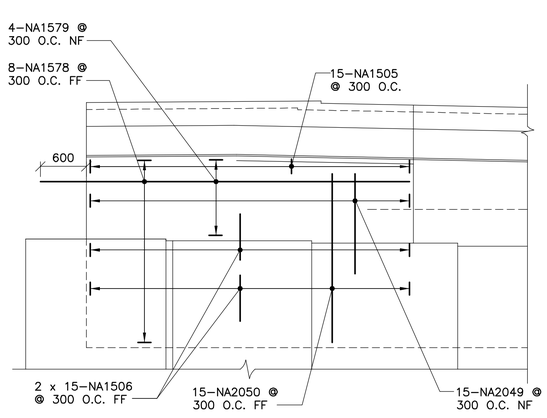

4 ABUT BACKWALL ELEVATION
1 : 40

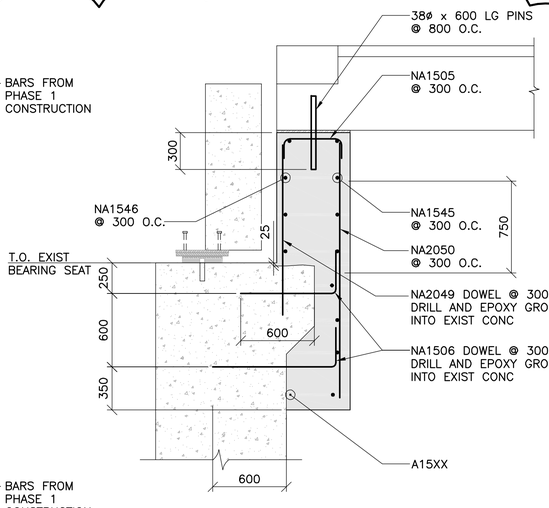

5 NEW ABUTMENT BACKWALL
1 : 25

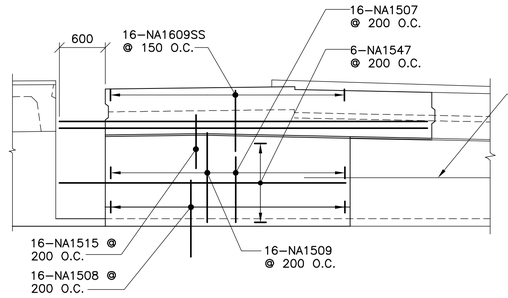

3 SECTION @ RETAININGWALL SLAB
1 : 40

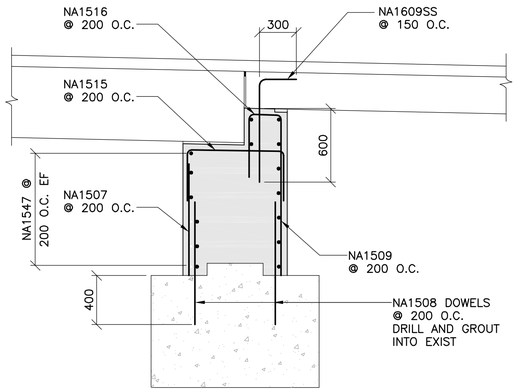

6 NEW RETAINING WALL
1 : 25

APEGM
Certificate of Authorization
Wardrop Engineering Inc.
No. 195 Date: April 30, 2011

NO.	REVISIONS	DATE	BY
01	ISSUED FOR ADDENDUM 1	11.03.07	RHW
00	ISSUED FOR TENDER	11.02.18	RHW

B.M. ELEV. F.B.

WARDROP
A TETRA TECH COMPANY

DESIGNED BY S.Y. | CHECKED BY R.H.W.
DRAWN BY H.A. | APPROVED BY R.H.W.
HOR. SCALE: AS NOTED
VERTICAL:
RELEASED FOR CONSTRUCTION DATE ORIGINAL SIGNED 11.02.16
DATE 10.10.20
MATT CHISLETT, P.ENG BRIDGE PROJECTS ENGINEER

PROVINCE OF MANITOBA
ORIGINAL SIGNED 11.02.16
W.R. HALDANE-WILSONE
REGISTERED PROFESSIONAL ENGINEER

CONSULTANT DRAWING NO.
0900070502-DWG-S0027

Winnipeg
THE CITY OF WINNIPEG
PUBLIC WORKS DEPARTMENT
ENGINEERING DIVISION

OSBORNE STREET BRIDGE
REHABILITATION & RELATED WORKS

CITY DRAWING NUMBER
B109-11-032
SHEET 27 OF 131

NORTH ABUTMENT AND APPROACH SLAB
PHASE 1A REINFORCING

27