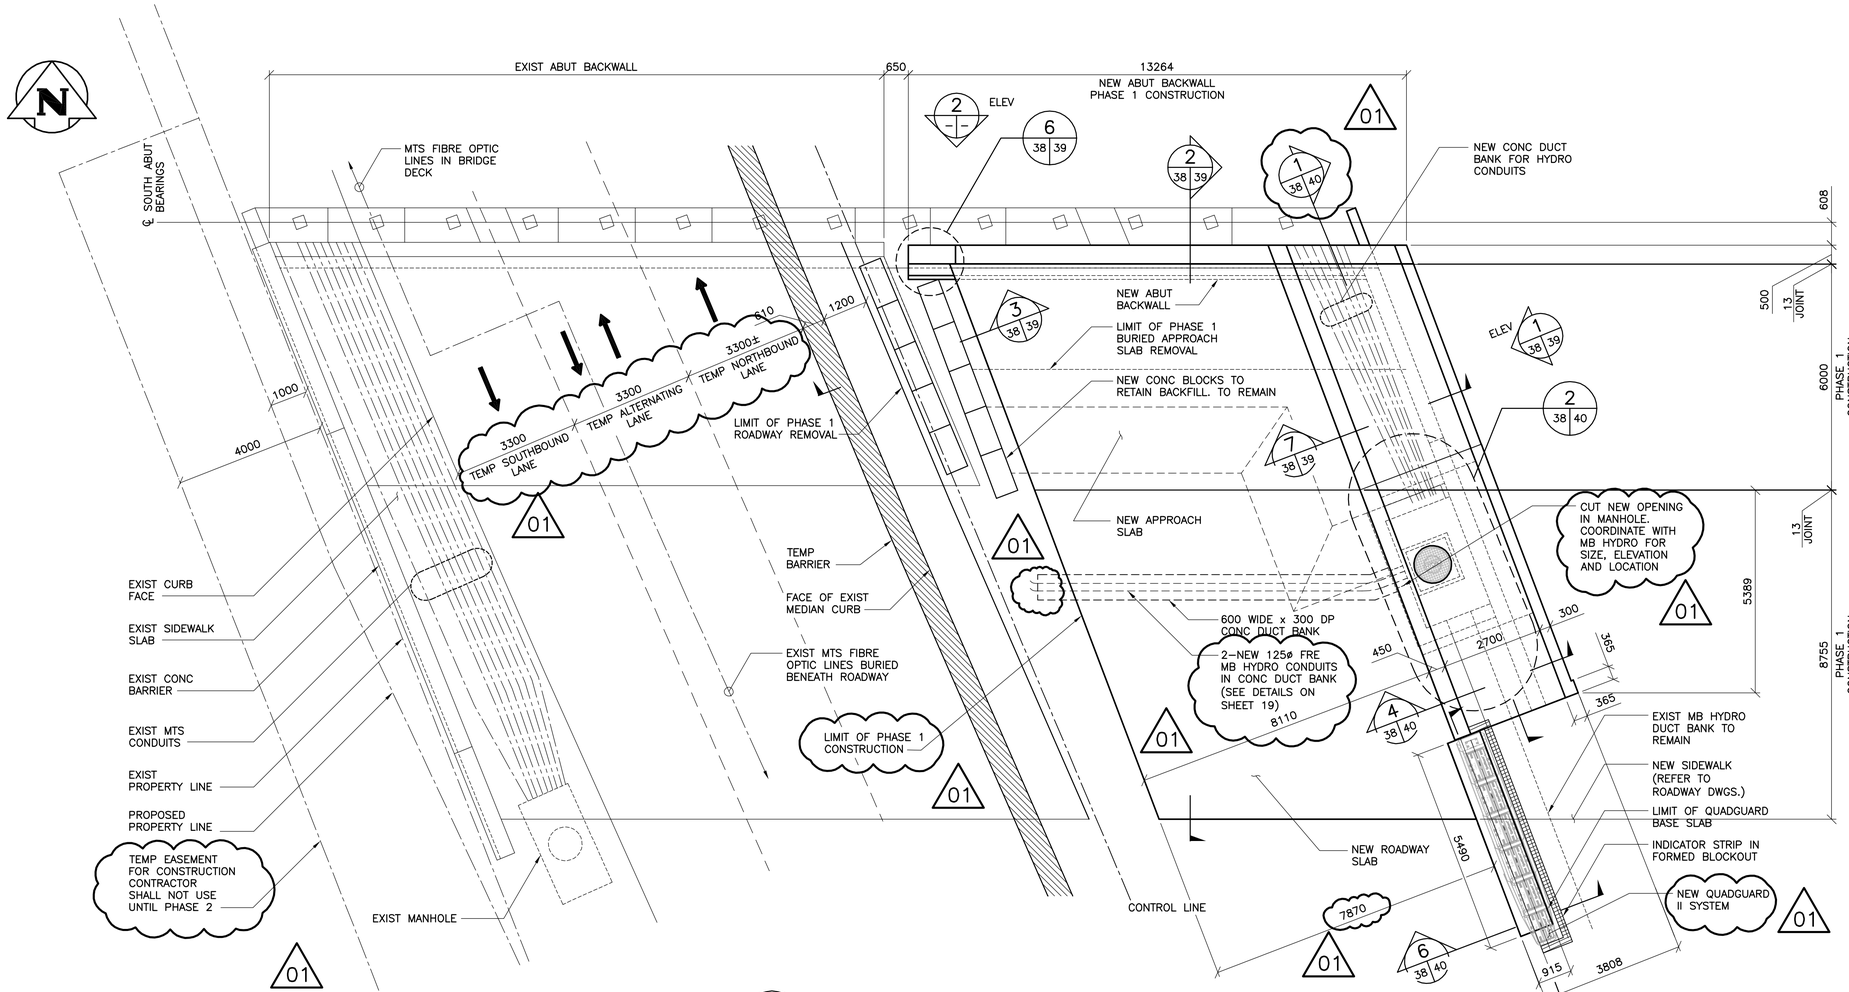

1 — PLAN – SOUTH ABUTMENT PHASE 1 CONSTRUCTION
1 : 75

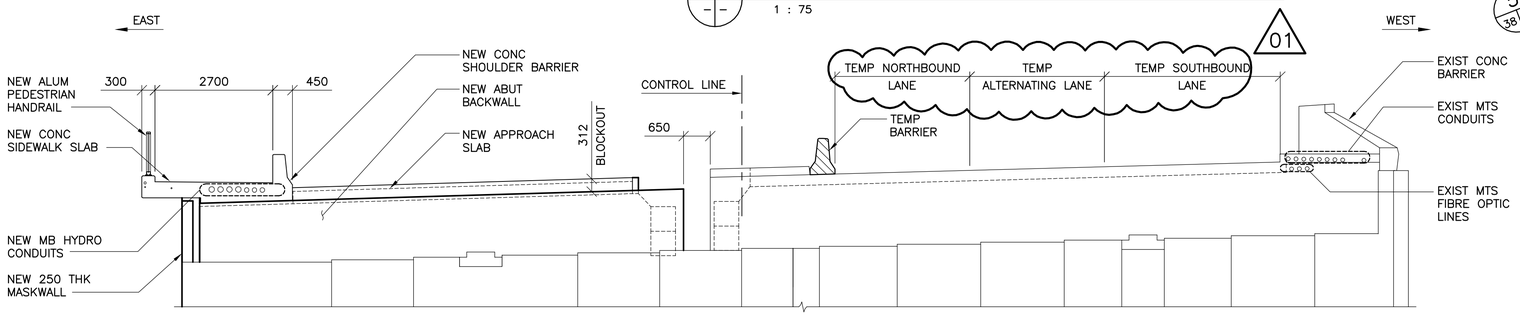

2 — ELEVATION – SOUTH ABUTMENT PHASE 1 CONSTRUCTION
1 : 75

APEGM
Certificate of Authorization
Wardrop Engineering Inc.
No. 195 Date: April 30, 2011

B.M. ELEV.		F.B.		
01	ISSUED FOR ADDENDUM 1	11.03.07	RHW	
00	ISSUED FOR TENDER	11.02.18	RHW	
NO.	REVISIONS	DATE	BY	

WARDROP
A TETRA TECH COMPANY

DESIGNED BY	S.Y.	CHECKED BY	R.H.W.
DRAWN BY	B.M.	APPROVED BY	R.H.W.
HOR. SCALE: / VERTICAL:	AS NOTED	RELEASED FOR CONSTRUCTION	DATE ORIGINAL SIGNED 11.02.16
DATE	10.10.20	MATT CHISLETT, P.ENG BRIDGE PROJECTS ENGINEER	

PROVINCE OF MANITOBA
ORIGINAL SIGNED 11.02.16
W.R. HALDANE-WILSONE
REGISTERED PROFESSIONAL ENGINEER

CONSULTANT DRAWING NO.
0900070502–DWG–S0038

Winnipeg

THE CITY OF WINNIPEG
PUBLIC WORKS DEPARTMENT
ENGINEERING DIVISION

OSBORNE STREET BRIDGE
REHABILITATION & RELATED WORKS

CITY DRAWING NUMBER
B109–11–043

SHEET 38 OF 131

SOUTH ABUTMENT AND APPROACH SLAB PHASE 1 CONSTRUCTION

38