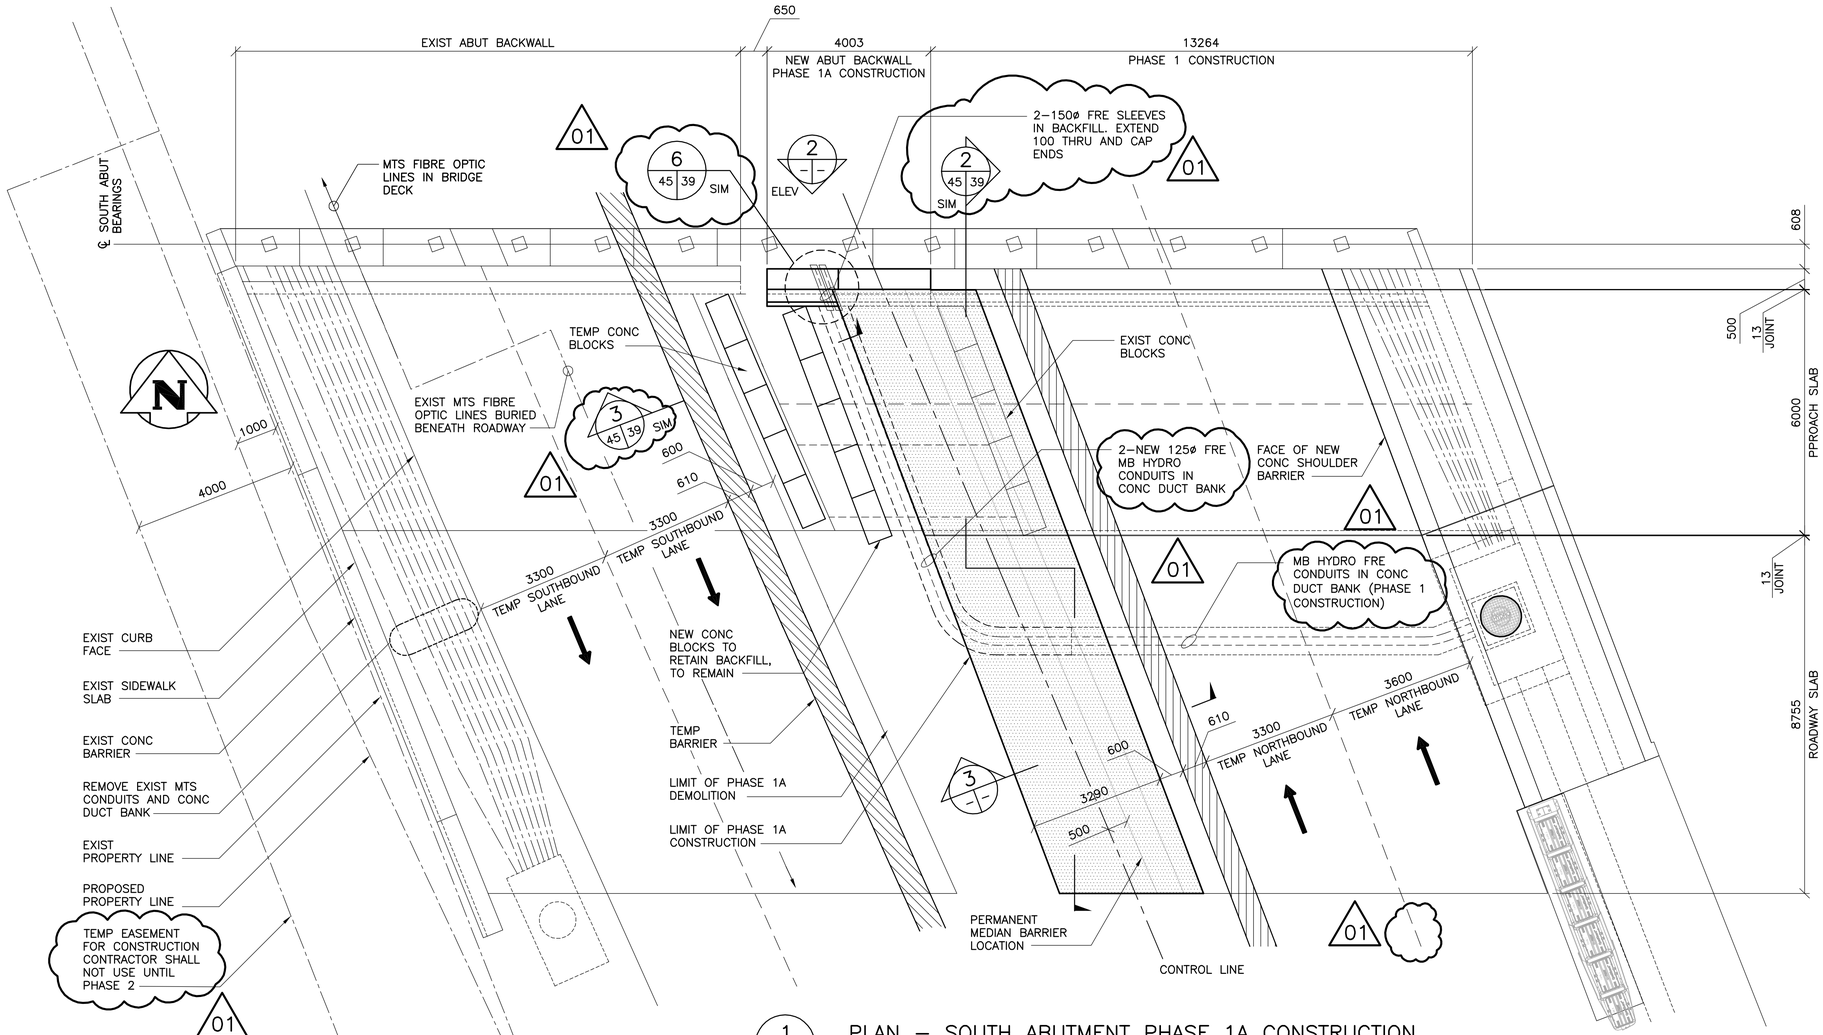

1 PLAN – SOUTH ABUTMENT PHASE 1A CONSTRUCTION
1 : 75

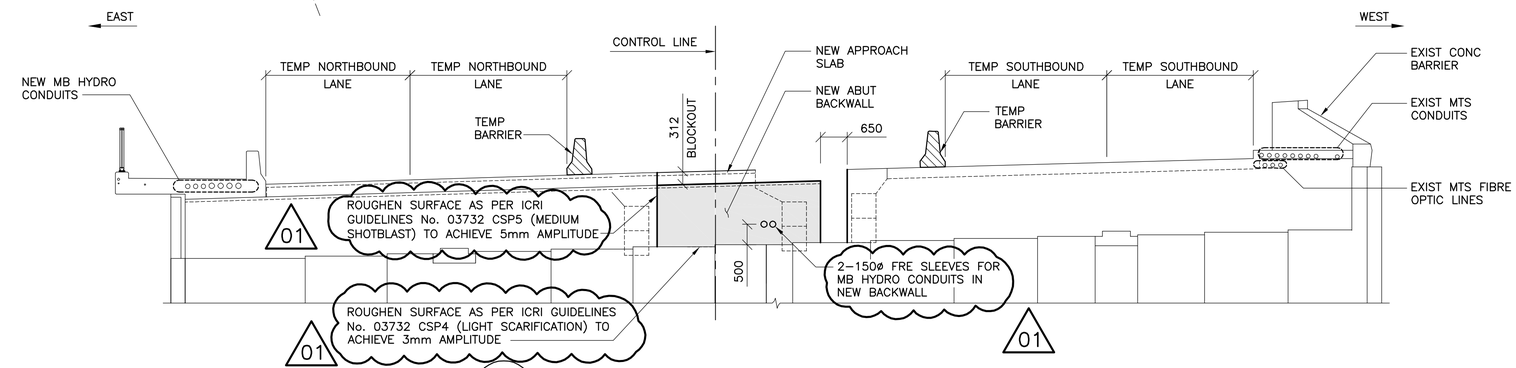

2 ELEVATION – SOUTH ABUTMENT PHASE 1A CONSTRUCTION
1 : 75

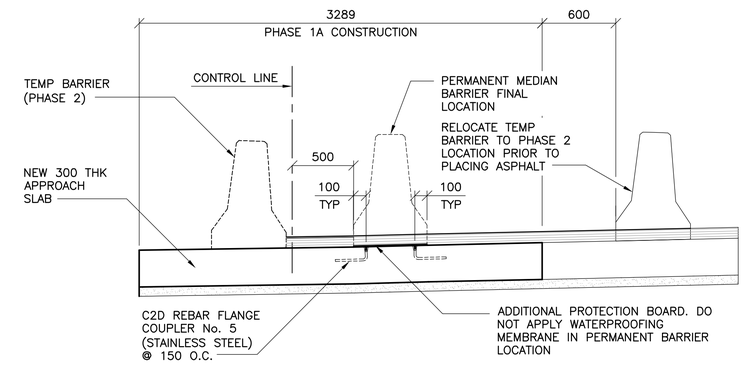

3 SECTION @ APPROACH & ROADWAY SLAB
1 : 25

APEGM
Certificate of Authorization
Wardrop Engineering Inc.
No. 195 Date: April 30, 2011

NO.	REVISIONS	DATE	BY
01	ISSUED FOR ADDENDUM 1	11.03.07	RHW
00	ISSUED FOR TENDER	11.02.18	RHW

B.M. ELEV. F.B.

WARDROP
A TETRA TECH COMPANY

DESIGNED BY	S.Y.	CHECKED BY	R.H.W.
DRAWN BY	B.M.	APPROVED BY	R.H.W.
HOR. SCALE: / VERTICAL:	AS NOTED	RELEASED FOR CONSTRUCTION	DATE
DATE	10.10.20	ORIGINAL SIGNED	11.02.16

MATT CHISLETT, P.ENG.
BRIDGE PROJECTS ENGINEER

PROVINCE OF MANITOBA
ORIGINAL SIGNED 11.02.16
W.R. HALDANE-WILSONE
REGISTERED PROFESSIONAL ENGINEER

CONSULTANT DRAWING NO.
0900070502-DWG-S0045

Winnipeg
THE CITY OF WINNIPEG
PUBLIC WORKS DEPARTMENT
ENGINEERING DIVISION

OSBORNE STREET BRIDGE
REHABILITATION & RELATED WORKS

CITY DRAWING NUMBER
B109-11-050

SHEET 45 OF 131

SOUTH ABUTMENT AND APPROACH SLAB
PHASE 1A CONSTRUCTION

45