


1 PLAN - SOUTH ABUTMENT PHASE 2 CONSTRUCTION

1 : 75
 - CONTRACTOR IS RESPONSIBLE TO LOCATE, PROTECT AND UNDERTAKE ALL WORKS WITHOUT DAMAGING THE EXISTING MTS FIBRE OPTIC LINES

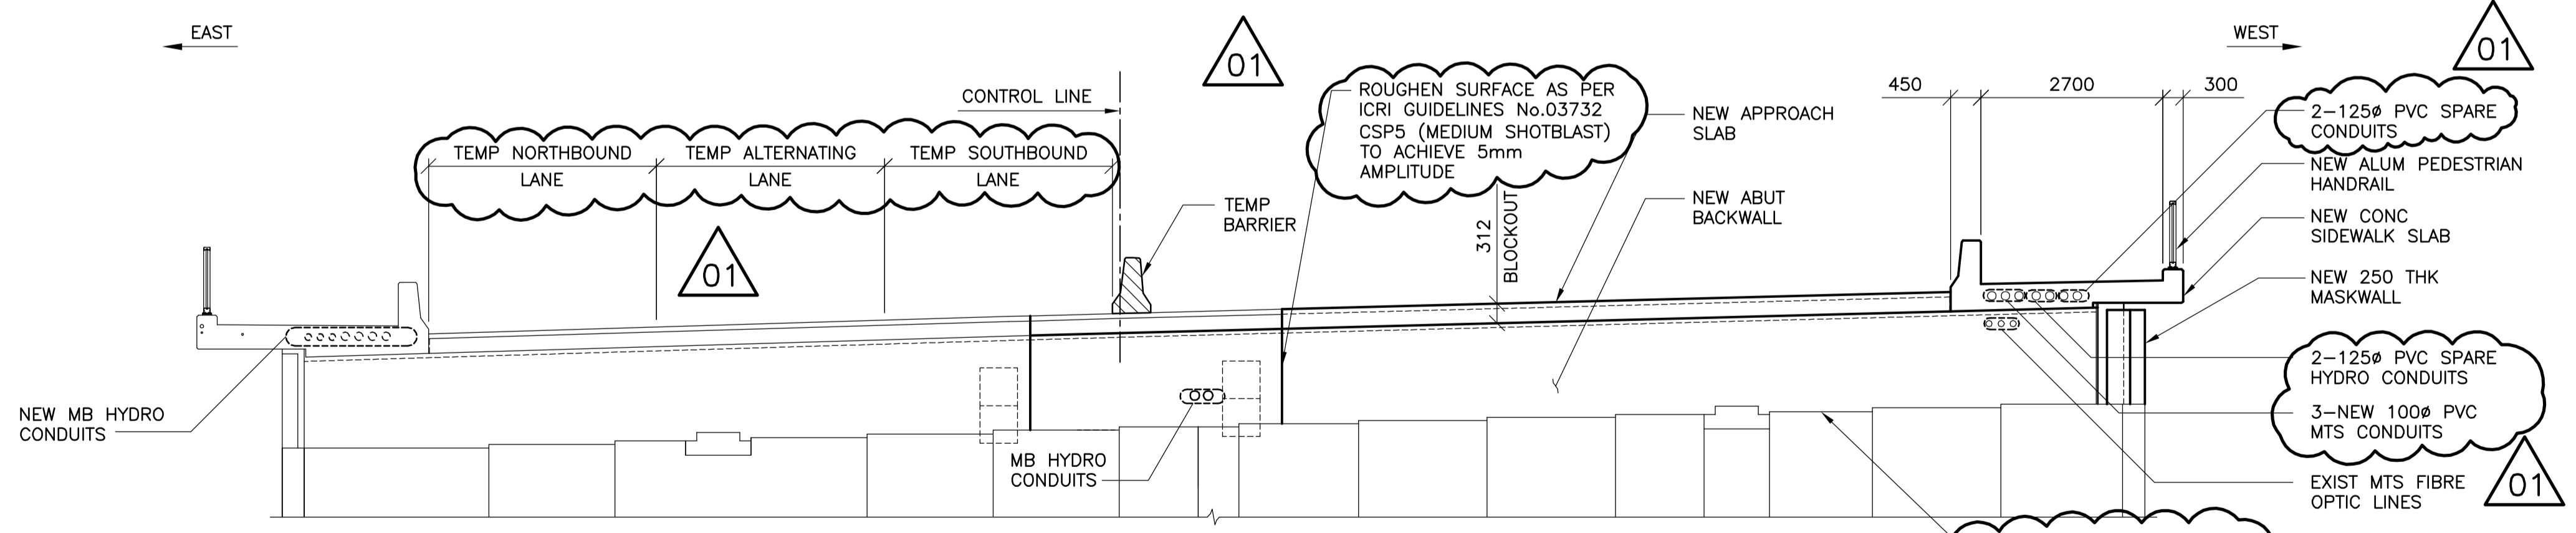

2 ELEVATION - SOUTH ABUTMENT PHASE 2 CONSTRUCTION

1 : 75




B.M. ELEV.	F.B.	NO.	REVISIONS	DATE	BY
		01	ISSUED FOR ADDENDUM 1	11.03.07	RHW
		00	ISSUED FOR TENDER	11.02.18	RHW

WARDROP
 ATETRA TECH COMPANY

DESIGNED BY: S.Y. CHECKED BY: R.H.W.
 DRAWN BY: B.M. APPROVED BY: R.H.W.

HOR. SCALE: AS NOTED
 VERTICAL: AS NOTED

RELEASED FOR CONSTRUCTION ORIGINAL SIGNED DATE 11.02.16
 MAIT CHSLETT, P.ENG. BRIDGE PROJECTS ENGINEER

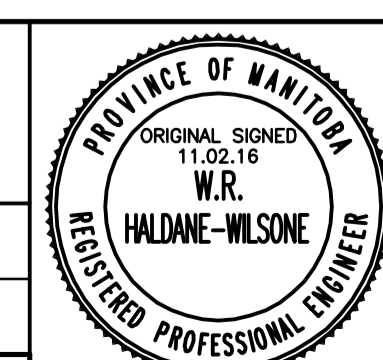

THE CITY OF WINNIPEG
 PUBLIC WORKS DEPARTMENT
 ENGINEERING DIVISION

OSBORNE STREET BRIDGE
 REHABILITATION & RELATED WORKS

SOUTH ABUTMENT AND APPROACH SLAB
 PHASE 2 CONSTRUCTION

CITY DRAWING NUMBER
 B109-11-054
 SHEET 49 OF 131

CONSULTANT DRAWING NO.
 0900070502-DWG-S0049

49