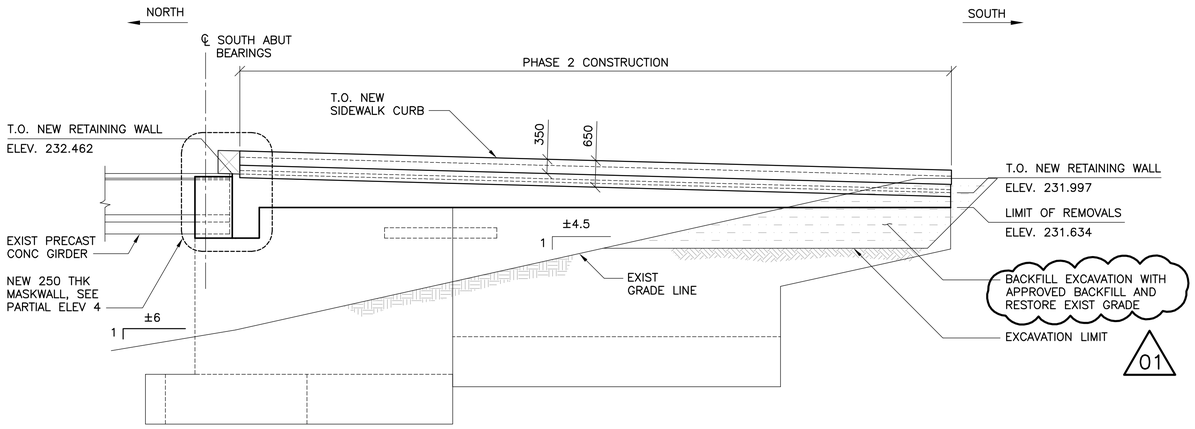

1 / 49|50 SOUTH WEST RETAINING WALL – ELEVATION
1 : 75

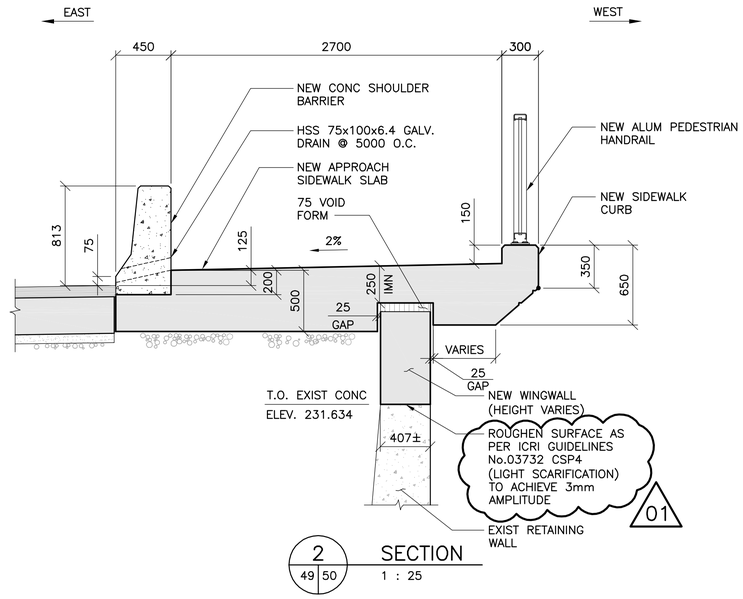

2 / 49|50 SECTION
1 : 25

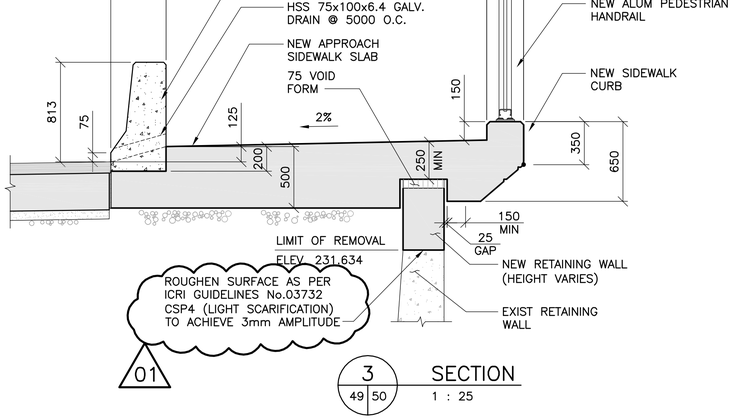

3 / 49|50 SECTION
1 : 25

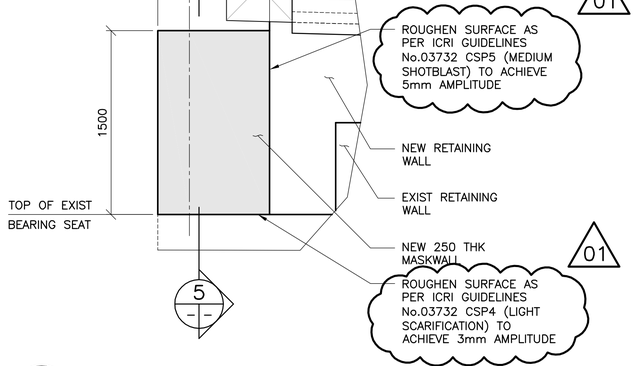

4 / – – PARTIAL ELEVATION – MASKWALL
1 : 25

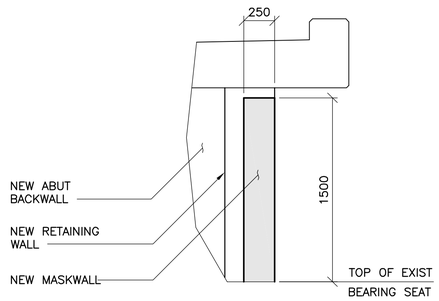

5 / – – SECTION – MASKWALL
1 : 25

APEGM
Certificate of Authorization
Wardrop Engineering Inc.
No. 195 Date: April 30, 2011

B.M. ELEV. F.B.

NO.	REVISIONS	DATE	BY
01	ISSUED FOR ADDENDUM 1	11.03.07	RHW
00	ISSUED FOR TENDER	11.02.18	RHW

WARDROP
A TETRA TECH COMPANY

DESIGNED BY S.Y. | CHECKED BY R.H.W.
DRAWN BY B.M. | APPROVED BY R.H.W.
HOR. SCALE: AS NOTED | RELEASED FOR CONSTRUCTION DATE ORIGINAL SIGNED 11.02.16
VERTICAL:
DATE 10.10.20 | MATT CHISLETT, P.ENG BRIDGE PROJECTS ENGINEER

PROVINCE OF MANITOBA — ORIGINAL SIGNED 11.02.16 W.R. HALDANE-WILSON — REGISTERED PROFESSIONAL ENGINEER

CONSULTANT DRAWING NO. 0900070502-DWG-S0050

Winnipeg

THE CITY OF WINNIPEG
PUBLIC WORKS DEPARTMENT
ENGINEERING DIVISION

OSBORNE STREET BRIDGE
REHABILITATION & RELATED WORKS

CITY DRAWING NUMBER B109-11-055
SHEET 50 OF 131

SOUTH ABUTMENT AND APPRROACH SLAB
PHASE 2 CONSTRUCTION

50