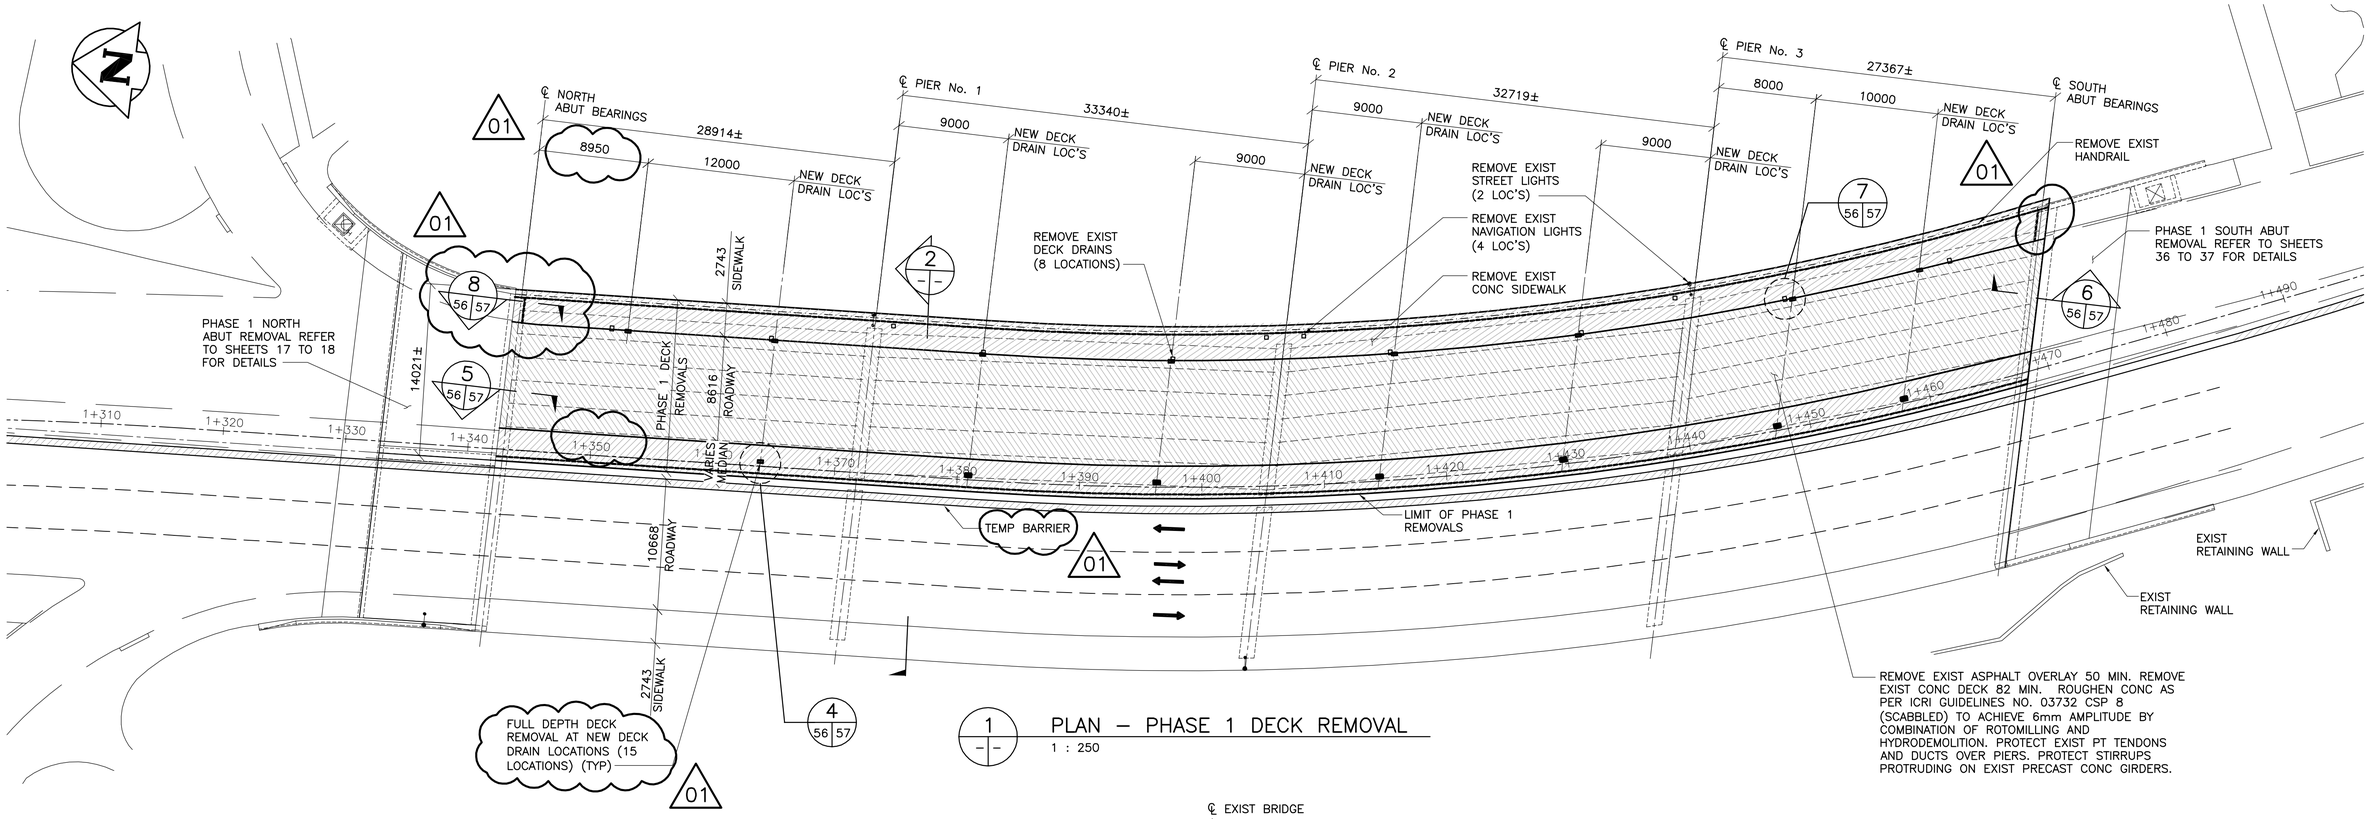

1 — PLAN — PHASE 1 DECK REMOVAL
1 : 250

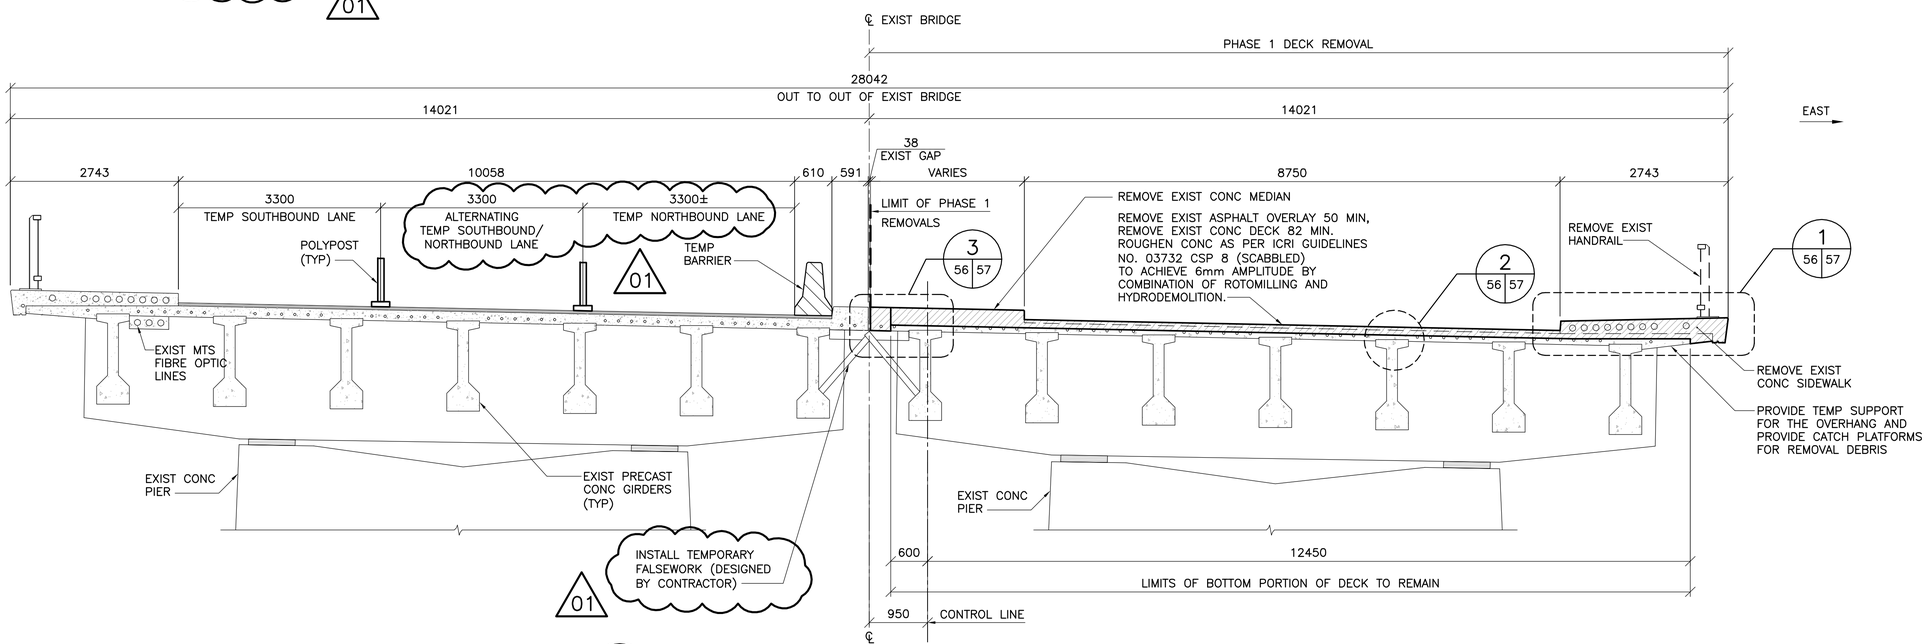

2 — SECTION — PHASE 1 DECK REMOVAL
1 : 50

NOTES:
REFER TO SHEET 5 FOR PROCEDURE AND SEQUENCE OF STRUCTURAL REMOVALS FOR DECK REMOVALS.

APEGM
Certificate of Authorization
Wardrop Engineering Inc.
No. 195 Date: April 30, 2011

B.M. ELEV. F.B.

NO.	REVISIONS	DATE	BY
01	ISSUED FOR ADDENDUM 1	11.03.07	EFS
00	ISSUED FOR TENDER	11.02.18	EFS

WARDROP
A TETRA TECH COMPANY

DESIGNED BY V.B. | CHECKED BY E.F.S.
DRAWN BY B.M. | APPROVED BY R.H.W.
HOR. SCALE: AS NOTED
VERTICAL:
DATE 10.10.13
RELEASED FOR CONSTRUCTION — DATE
ORIGINAL SIGNED 11.02.16
MATT CHISLETT, P.ENG BRIDGE PROJECTS ENGINEER

ORIGINAL SIGNED 11.02.16
PROVINCE OF MANITOBA — E.F.G. SHEHATA Member 23439 — REGISTERED PROFESSIONAL ENGINEER
CONSULTANT DRAWING NO. 0900070502-DWG-S0056

Winnipeg
THE CITY OF WINNIPEG
PUBLIC WORKS DEPARTMENT
ENGINEERING DIVISION

OSBORNE STREET BRIDGE
REHABILITATION & RELATED WORKS

CITY DRAWING NUMBER B109-11-061
SHEET 56 OF 131

BRIDGE DECK — PHASE 1 REMOVAL

56