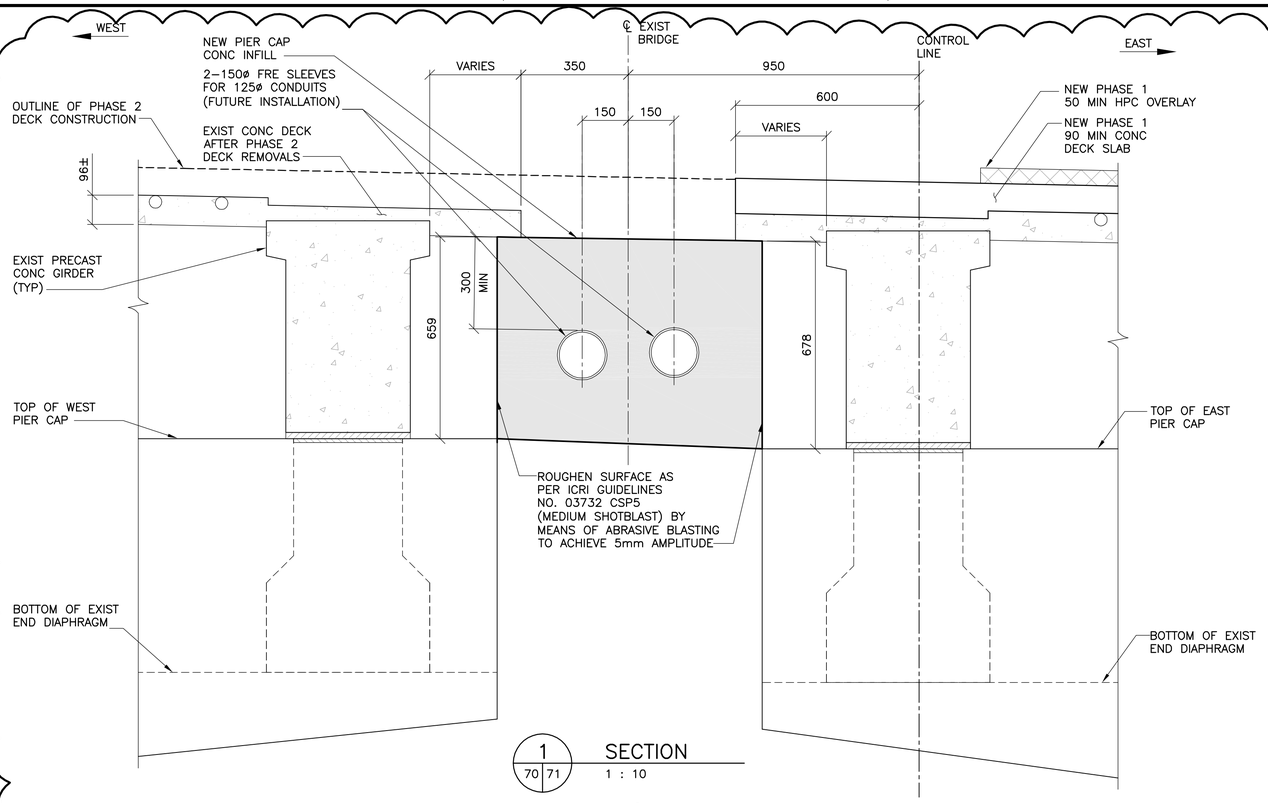

1 / 70 71 SECTION
1 : 10

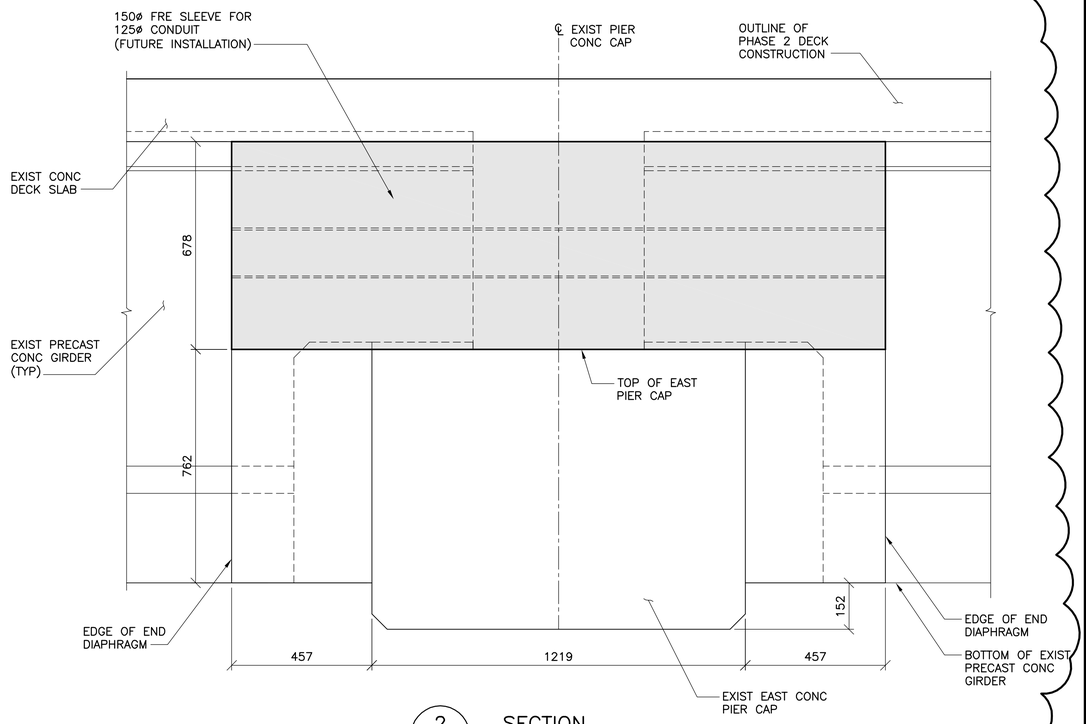

2 / 70 71 SECTION
1 : 10

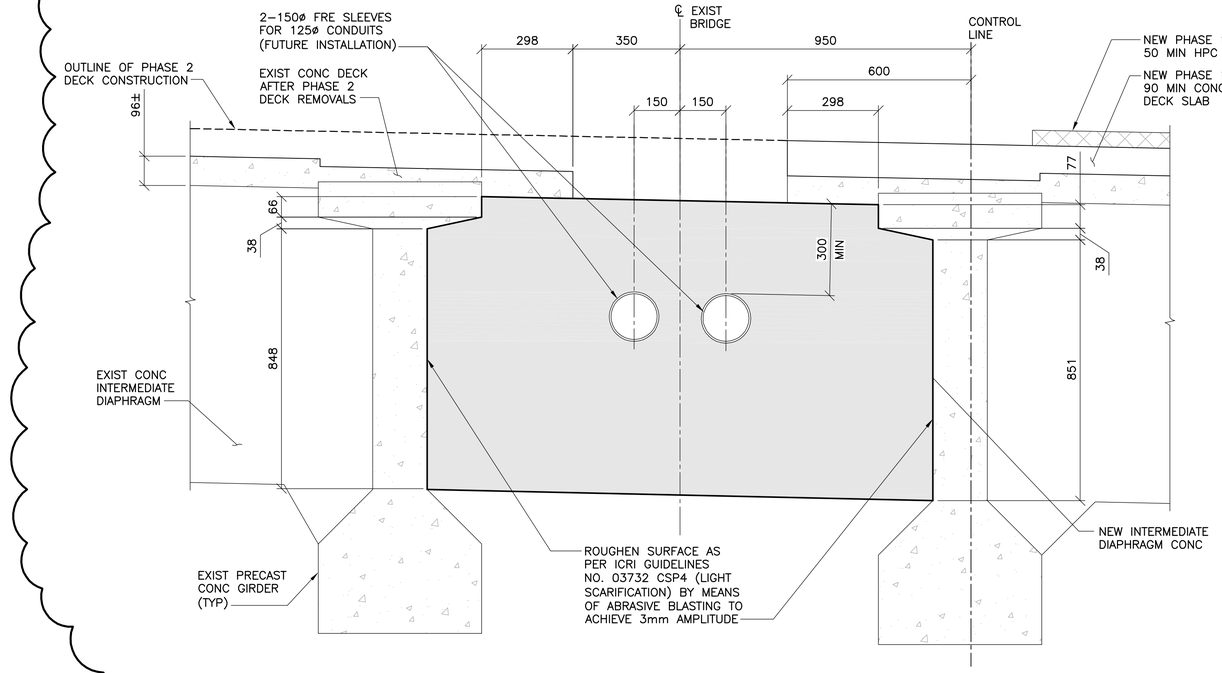

3 / 70 71 SECTION
1 : 10

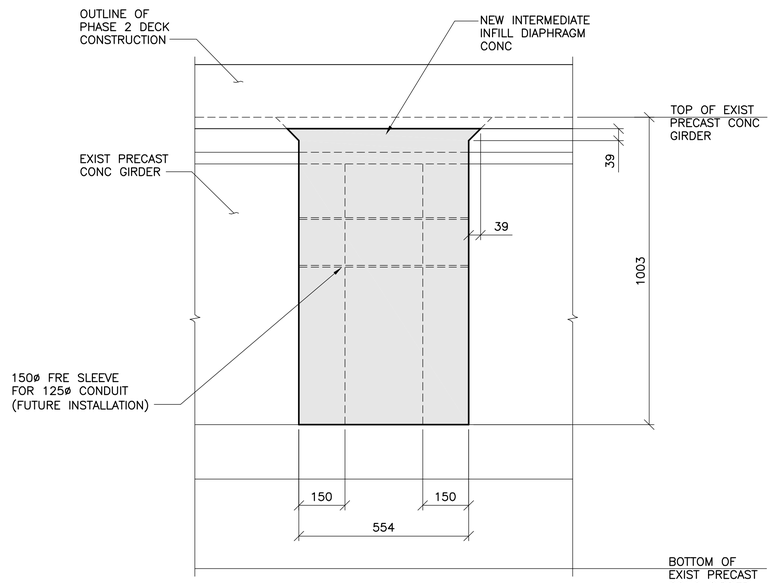

4 / 70 71 SECTION
1 : 10

01

APEGM
Certificate of Authorization
Wardrop Engineering Inc.
No. 195 Date: April 30, 2011

B.M. ELEV.		F.B.		
01	ISSUED FOR ADDENDUM 1	11.03.07	RHW	
00	ISSUED FOR TENDER	11.02.18	RHW	
NO.	REVISIONS	DATE	BY	

WARDROP
A TETRA TECH COMPANY

DESIGNED BY	V.B.	CHECKED BY	R.H.W.
DRAWN BY	B.M.	APPROVED BY	R.H.W.
HOR. SCALE: / VERTICAL:	AS NOTED	RELEASED FOR CONSTRUCTION	DATE ORIGINAL SIGNED 11.02.16
DATE	10.10.13	MATT CHISLETT, P.ENG BRIDGE PROJECTS ENGINEER	

PROVINCE OF MANITOBA — ORIGINAL SIGNED 11.02.16 — W.R. HALDANE-WILSON — REGISTERED PROFESSIONAL ENGINEER

CONSULTANT DRAWING NO.
0900070502-DWG-S0071

Winnipeg

THE CITY OF WINNIPEG
PUBLIC WORKS DEPARTMENT
ENGINEERING DIVISION

OSBORNE STREET BRIDGE
REHABILITATION & RELATED WORKS

CITY DRAWING NUMBER
B109-11-076

SHEET 71 OF 131

PIER CAP AND INTERMEDIATE DIAPHRAGM CONCRETE INFILL DETAILS

71