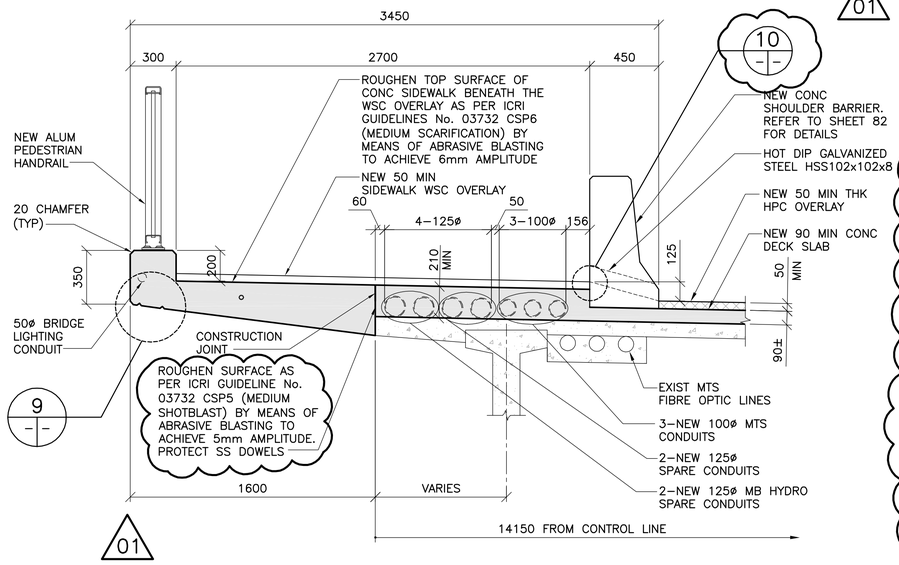

1 / 75|76 DETAIL
1 : 20

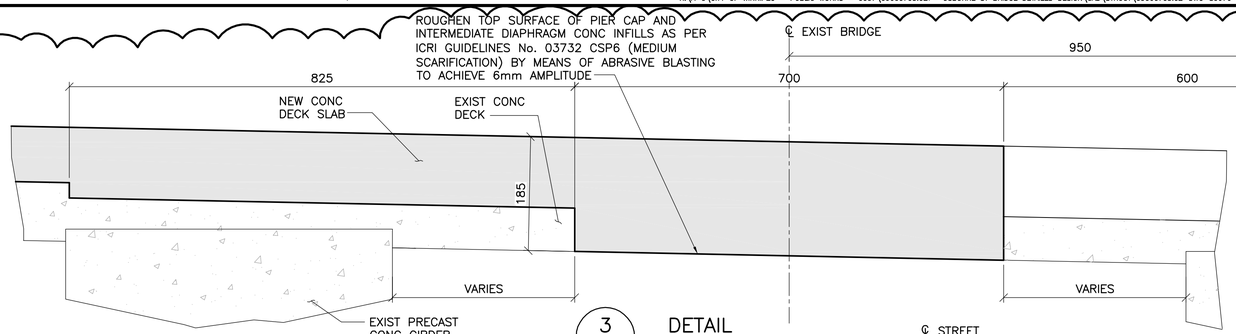

3 / 75|76 DETAIL
1 : 5

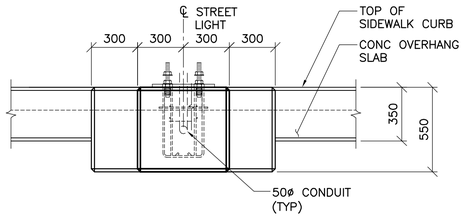

5 / -|- STREET LIGHT CONC BASE - ELEVATION
1 : 20
- AT PIER LOCATIONS

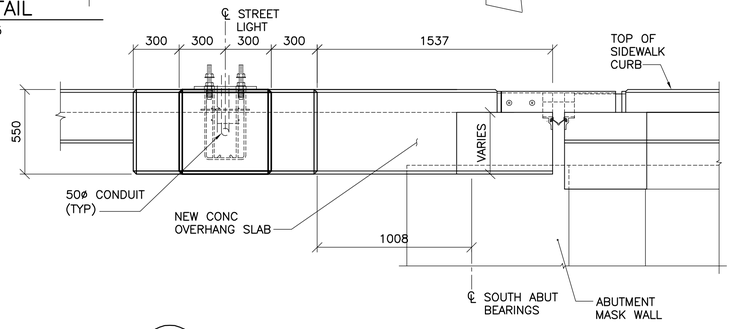

6 / -|- STREET LIGHT CONC BASE - ELEVATION
1 : 20
- AT SOUTH ABUTMENT

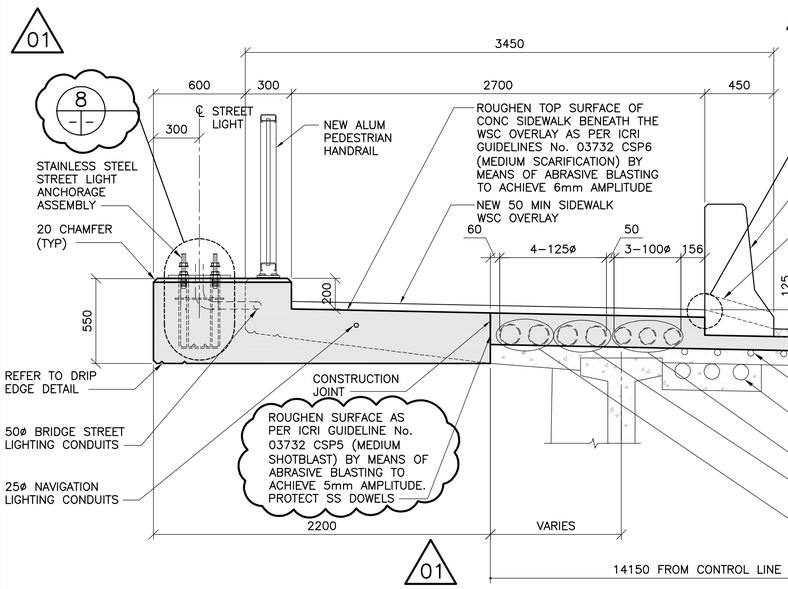

2 / 75|76 DETAIL
1 : 20

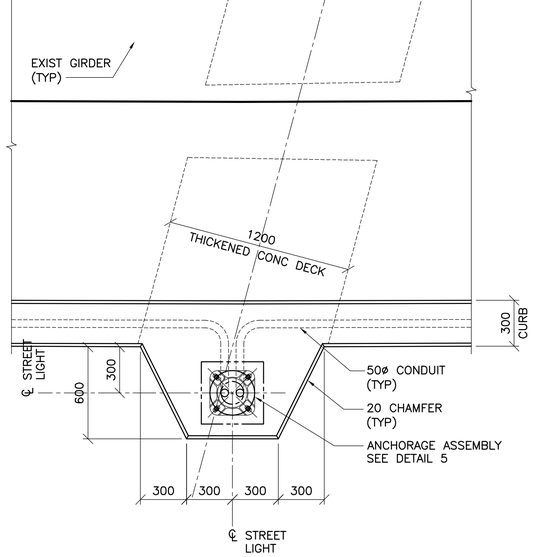

4 / 74|76 STREET LIGHT CONC BASE - PLAN
1 : 20

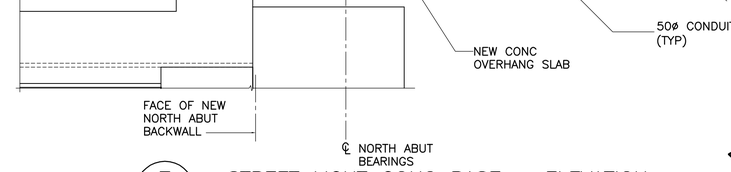

7 / -|- STREET LIGHT CONC BASE - ELEVATION
1 : 20
- AT NORTH ABUTMENT

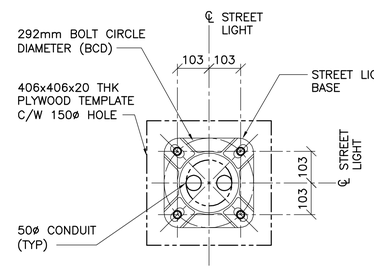

PLAN

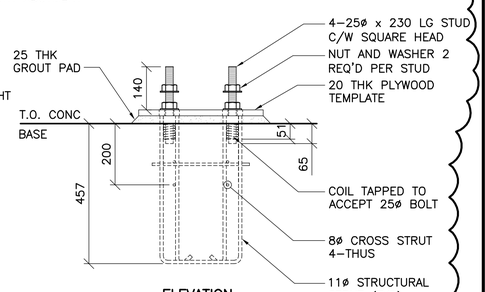

ELEVATION

8 / -|- PRESET ANCHORAGE ASSEMBLY DGR-2FS (292mm BCD)
1 : 10
NOTE: ANCHORAGE ASSEMBLY IS STAINLESS STEEL

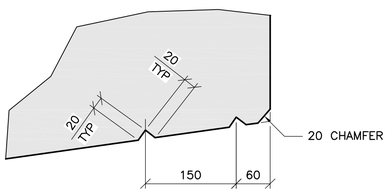

9 / -|- DRIP EDGE DETAIL
1 : 5

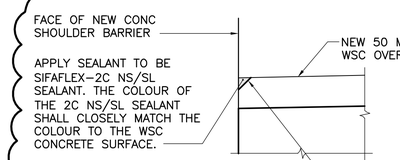

10 / -|- DETAIL
1 : 5

APEGM
Certificate of Authorization
Wardrop Engineering Inc.
No. 195 Date: April 30, 2011

NO.	REVISIONS	DATE	BY
01	ISSUED FOR ADDENDUM 1	11.03.07	EFS
00	ISSUED FOR TENDER	11.02.18	EFS

B.M. ELEV. F.B.

WARDROP
A TETRA TECH COMPANY

DESIGNED BY V.B. | CHECKED BY E.F.S.
DRAWN BY B.M. | APPROVED BY R.H.W.
HOR. SCALE: AS NOTED | RELEASED FOR CONSTRUCTION DATE ORIGINAL SIGNED 11.02.16
VERTICAL:
DATE 10.10.13
MATT CHISLETT, P.ENG BRIDGE PROJECTS ENGINEER

PROVINCE OF MANITOBA
E.F.G. SHEHATA
Member 23439
REGISTERED PROFESSIONAL ENGINEER
ORIGINAL SIGNED 11.02.16

CONSULTANT DRAWING NO.
0900070502-DWG-S0076

Winnipeg
THE CITY OF WINNIPEG
PUBLIC WORKS DEPARTMENT
ENGINEERING DIVISION

OSBORNE STREET BRIDGE
REHABILITATION & RELATED WORKS

CITY DRAWING NUMBER
B109-11-081
SHEET 76 OF 131

BRIDGE DECK - PHASE 2 CONSTRUCTION

76