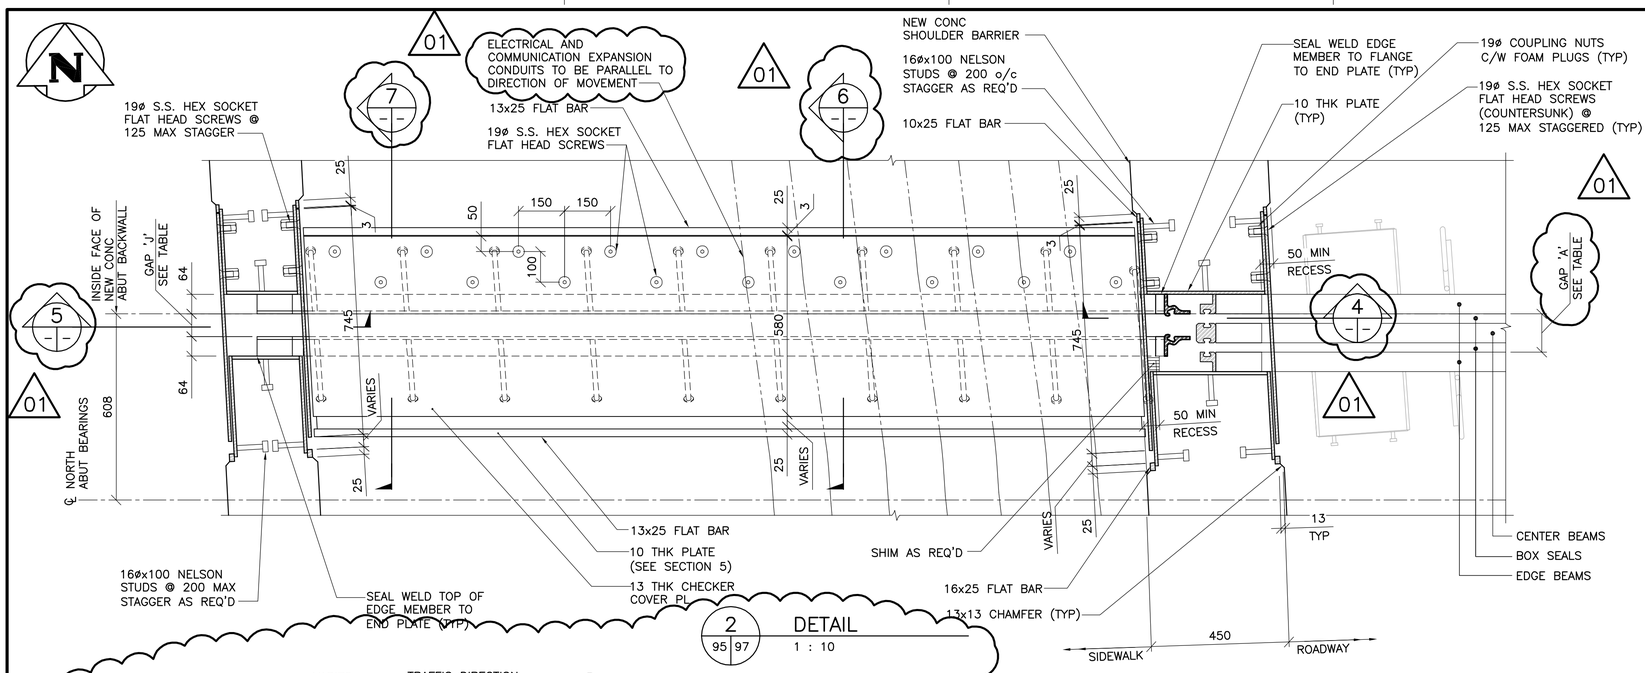

2 / 95 | 97 DETAIL
1 : 10

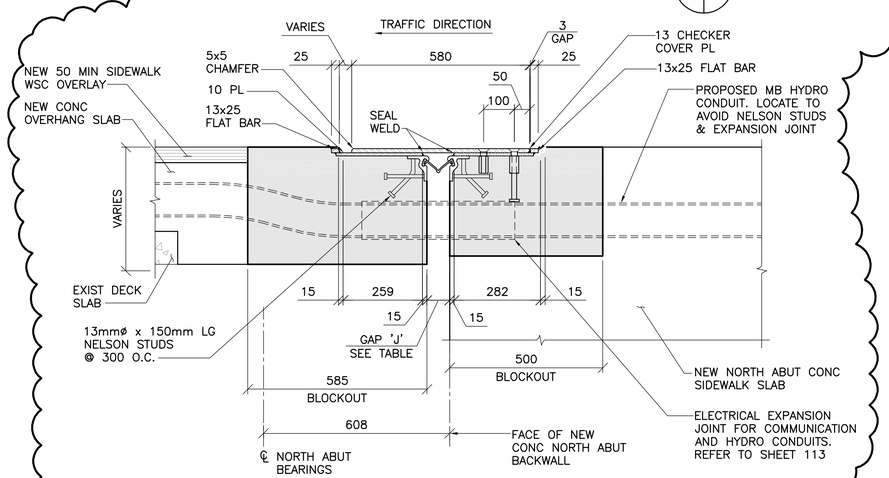

6 SECTION AT SIDEWALK
1 : 10
– SHOWN FOR 20°C

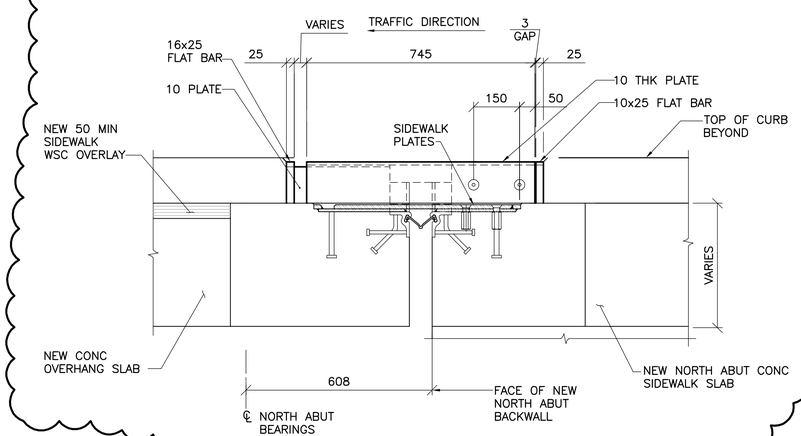

7 SECTION AT SIDEWALK
1 : 10
– SHOWN FOR 20°C

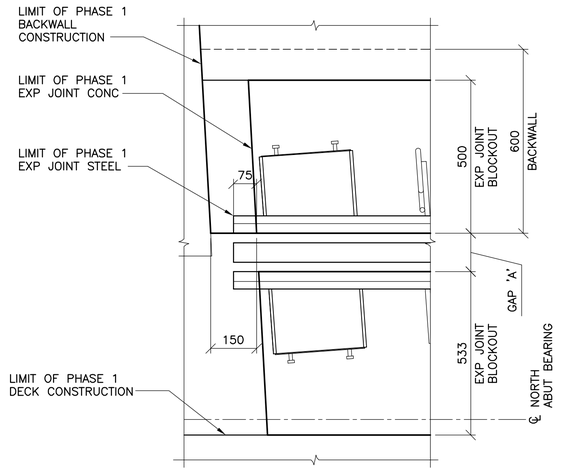

3 / 93 & 94 | 97 DETAIL
1 : 10

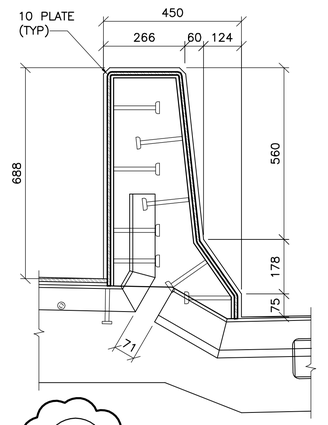

4 SECTION
1 : 10
– WABO MODULAR D600

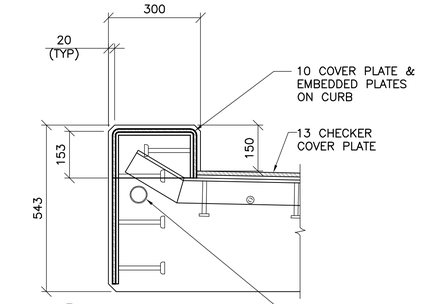

5 SECTION
1 : 10
– SE500 STRIPSEAL

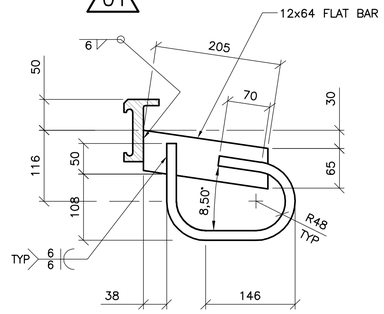

8 ANCHOR TYPE 'A'
1 : 5

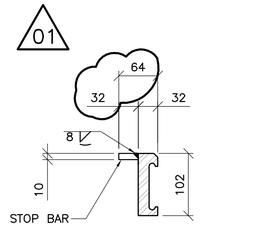

9 EDGE BEAM DETAIL
1 : 5

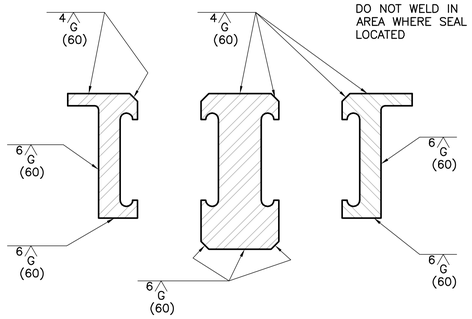

WABO MODULAR D600

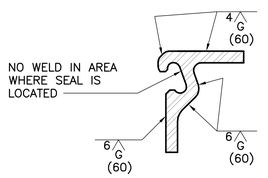

WABO SE500 TYPE 'M'

10 TYPICAL EXPANSION JOINT FIELD SPLICE DETAILS
NOT TO SCALE

APEGM Certificate of Authorization
Wardrop Engineering Inc.
No. 195 Date: April 30, 2011

NO.	REVISIONS	DATE	BY
01	ISSUED FOR ADDENDUM 1	11.03.07	VB
00	ISSUED FOR TENDER	11.02.18	VB

B.M. ELEV. F.B.

WARDROP A TETRA TECH COMPANY

DESIGNED BY K.Y. | CHECKED BY V.B.
DRAWN BY E.M.M. | APPROVED BY R.H.W.
HOR. SCALE: AS NOTED
VERTICAL:
RELEASED FOR CONSTRUCTION DATE ORIGINAL SIGNED 11.02.16
DATE 10.12.03
MATT CHISLETT, P.ENG BRIDGE PROJECT'S ENGINEER

PROVINCE OF MANITOBA ORIGINAL SIGNED 11.02.16 V. BANTHIA Member 23477 REGISTERED PROFESSIONAL ENGINEER
CONSULTANT DRAWING NO. 0900070502-DWG-S0097

Winnipeg
THE CITY OF WINNIPEG
PUBLIC WORKS DEPARTMENT
ENGINEERING DIVISION

OSBORNE STREET BRIDGE
REHABILITATION & RELATED WORKS

CITY DRAWING NUMBER B109-11-102
SHEET 97 OF 131

NORTH EXPANSION JOINT

97