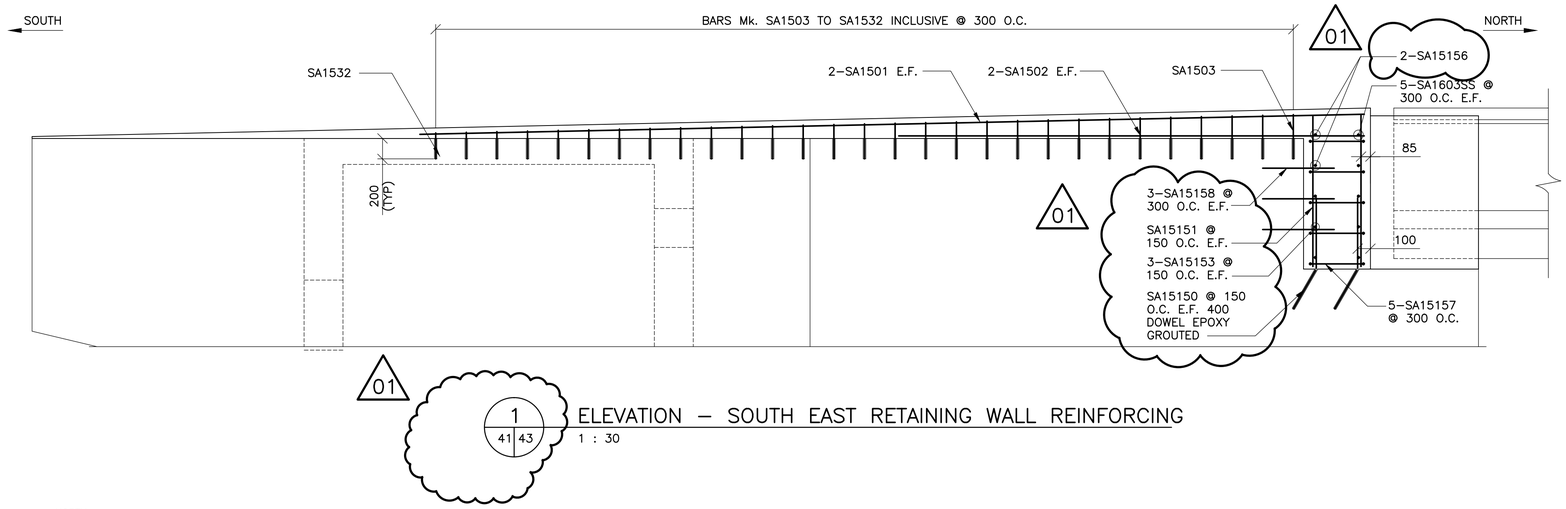

1 / 41|43 — ELEVATION – SOUTH EAST RETAINING WALL REINFORCING
1 : 30

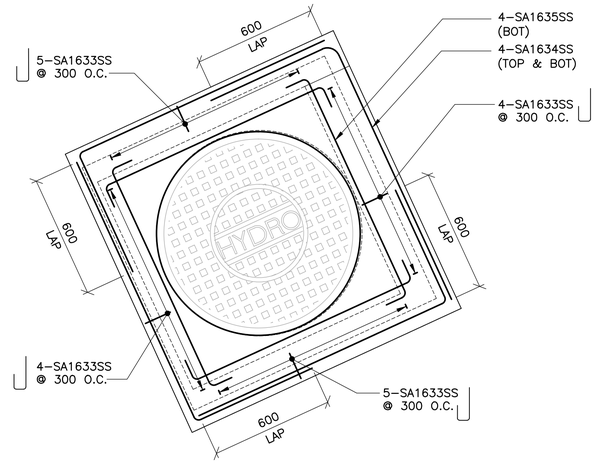

5 / 41|43 — DETAIL
1 : 15

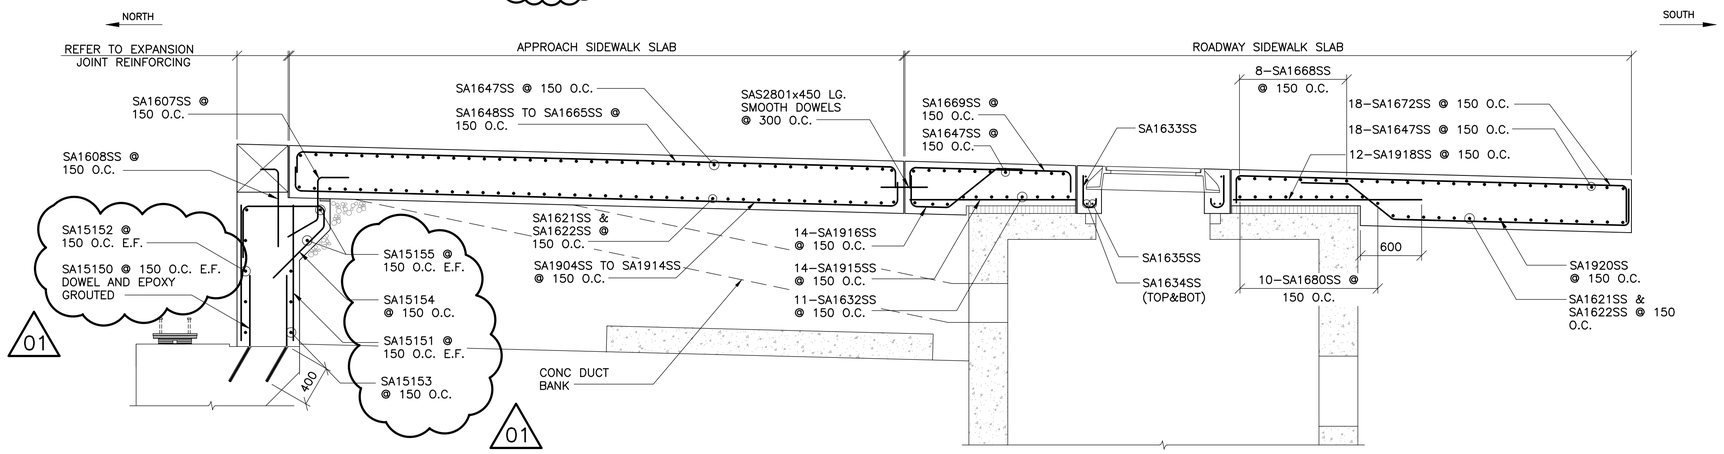

2 / 41|43 — SECTION
1 : 30

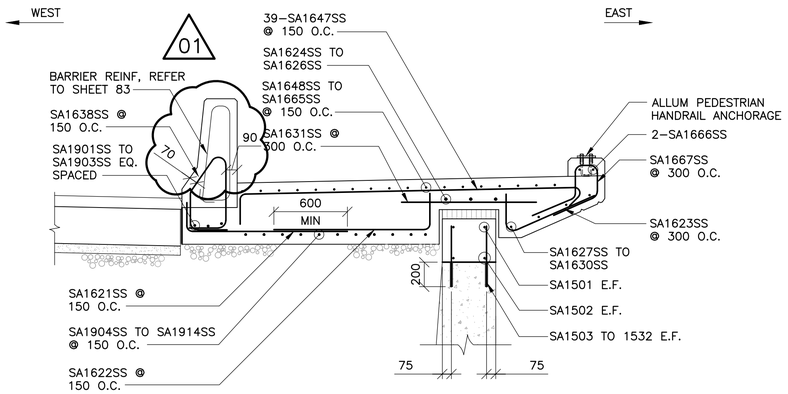

3 / 41|43 — APPROACH SIDEWALK SLAB SECTION
1 : 25

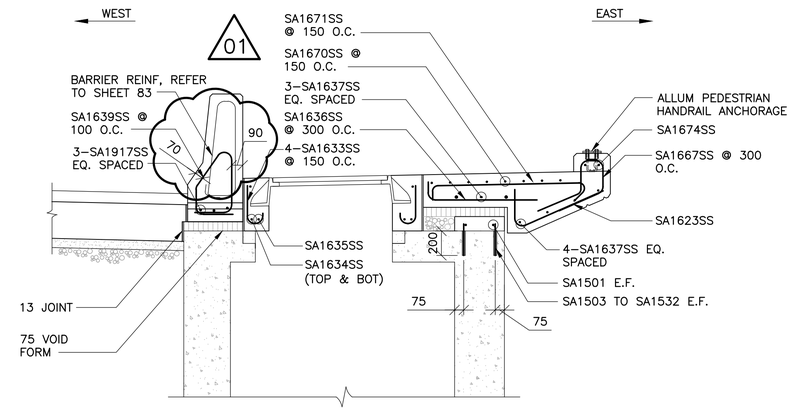

4 / 41|43 — SECTION – AT HYDRO MANHOLE
1 : 25

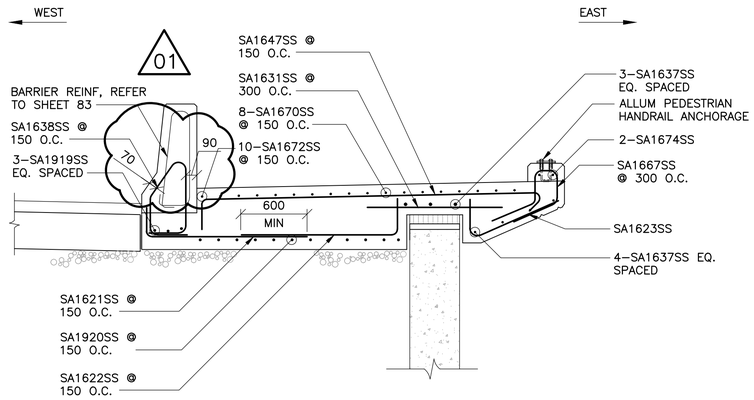

6 / 41|43 — SIDEWALK SLAB SECTION
1 : 25

NO.	REVISIONS	DATE	BY
01	ISSUED FOR ADDENDUM 3	11.03.14	RHW
00	ISSUED FOR ADDENDUM 1	11.03.07	RHW

B.M. ELEV. F.B.

APEGM Certificate of Authorization Wardrop Engineering Inc. No. 195 Date: April 30, 2011

WARDROP A TETRA TECH COMPANY

DESIGNED BY	S.Y.	CHECKED BY	R.H.W.
DRAWN BY	C.T.	APPROVED BY	R.H.W.
HOR. SCALE:	AS NOTED	RELEASED FOR CONSTRUCTION	DATE 11.03.07
VERTICAL:		ORIGINAL SIGNED	
DATE	10.10.20	MATT CHISLETT, P.ENG. BRIDGE PROJECTS ENGINEER	

PROVINCE OF MANITOBA — ORIGINAL SIGNED 11.03.07 — W.R. HALDANE-WILSONE — REGISTERED PROFESSIONAL ENGINEER

CONSULTANT DRAWING NO. 0900070502-DWG-S0043

Winnipeg

THE CITY OF WINNIPEG
PUBLIC WORKS DEPARTMENT
ENGINEERING DIVISION

OSBORNE STREET BRIDGE
REHABILITATION & RELATED WORKS

CITY DRAWING NUMBER B109-11-048

SHEET 43 OF 131

SOUTH ABUTMENT AND APPROACH SLAB PHASE 1 REINFORCING

43