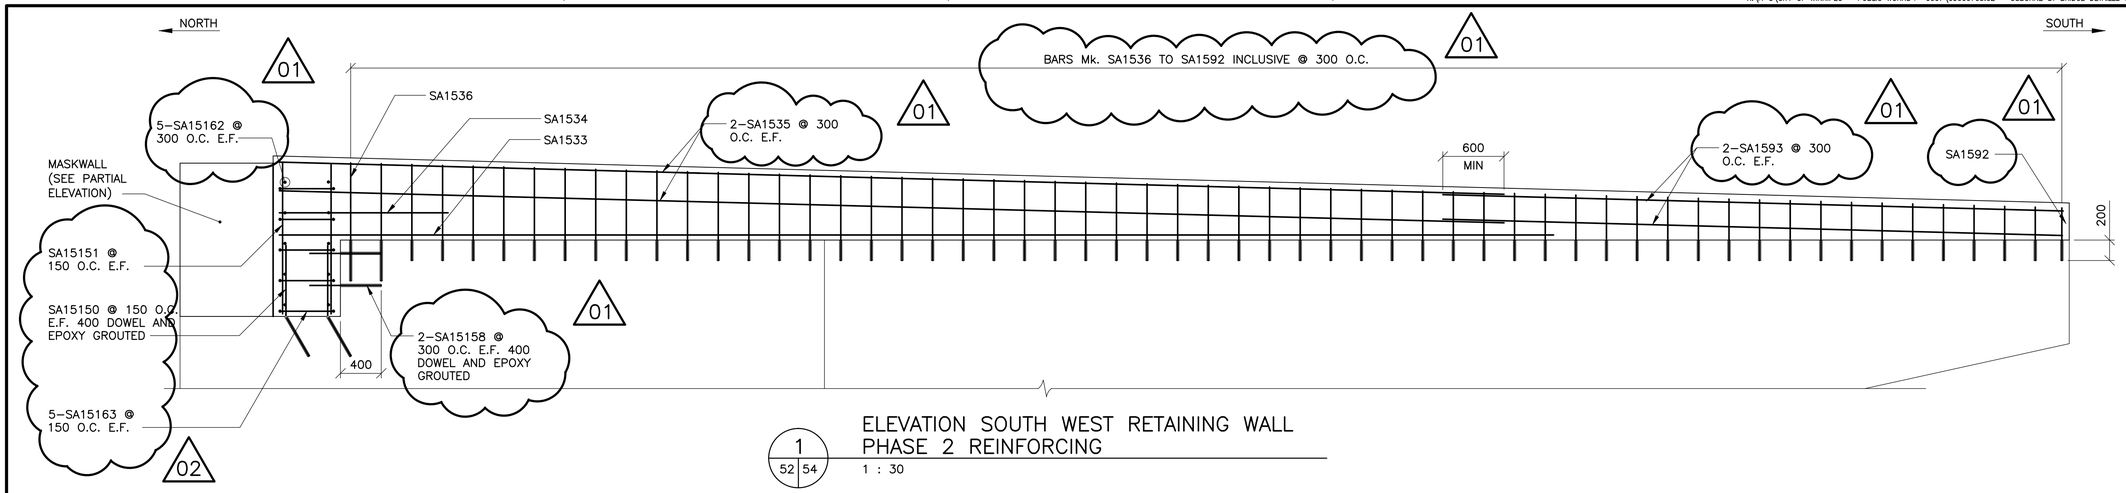

1/52|54 ELEVATION SOUTH WEST RETAINING WALL PHASE 2 REINFORCING
1 : 30

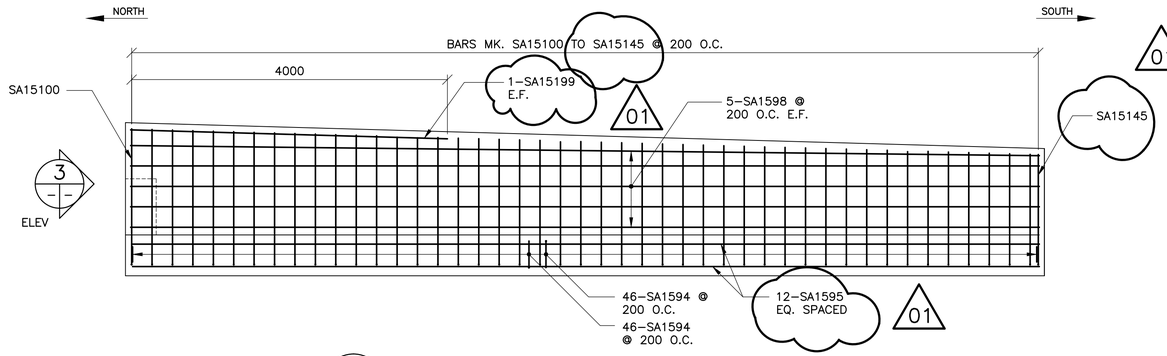

2/-/- RETAINING WALL ELEVATION – REINFORCING
1 : 30

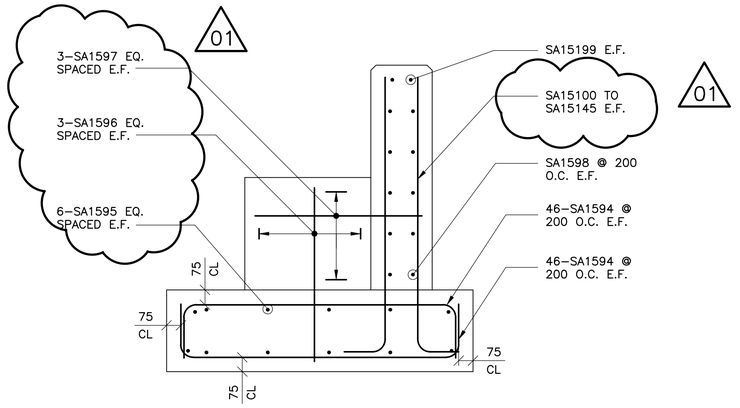

3/-/- ELEVATION
1 : 15

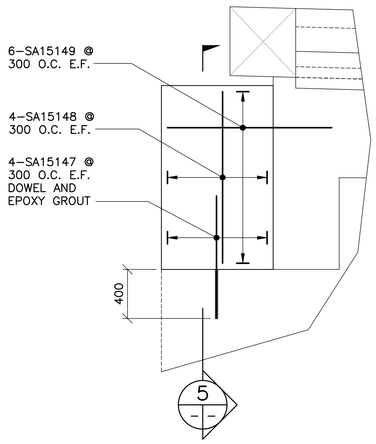

4/-/- PARTIAL ELEVATION MASKWALL
1 : 25

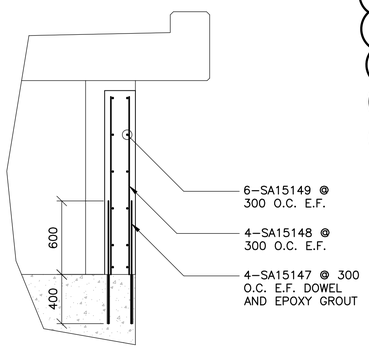

5/-/- SECTION
1 : 25

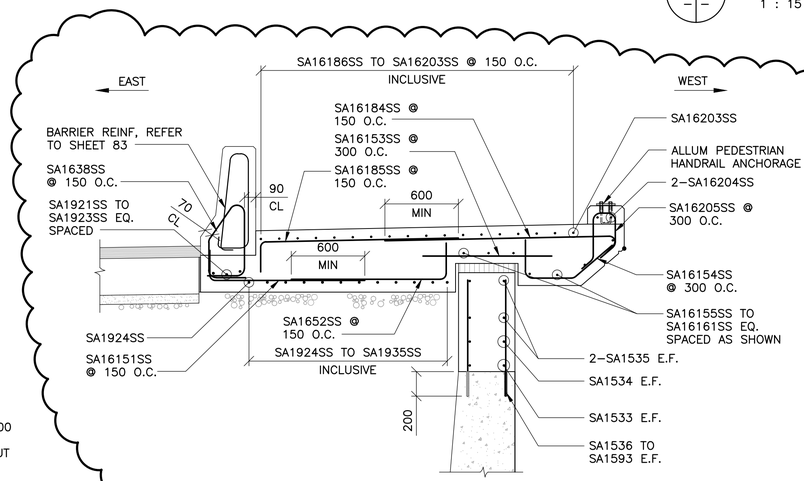

6/52|54 APPROACH SIDEWALK SLAB SECTION
1 : 25

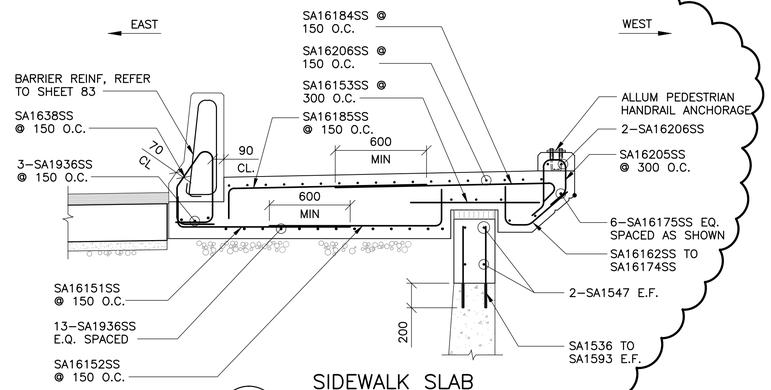

7/52|54 SIDEWALK SLAB SECTION
1 : 25

APEGM Certificate of Authorization
Wardrop Engineering Inc.
No. 195 Date: April 30, 2011

NO.	REVISIONS	DATE	BY
01	ISSUED FOR ADDENDUM 3	11.03.14	RHW
00	ISSUED FOR ADDENDUM 1	11.03.07	RHW

B.M. ELEV. F.B.

WARDROP
A TETRA TECH COMPANY

DESIGNED BY S.Y. | CHECKED BY R.H.W.
DRAWN BY B.M. | APPROVED BY R.H.W.
HOR. SCALE: AS NOTED | RELEASED FOR CONSTRUCTION ORIGINAL SIGNED DATE 11.03.07
VERTICAL:
DATE 10.10.20 | MATT CHISLETT, P.ENG BRIDGE PROJECTS ENGINEER

PROVINCE OF MANITOBA ORIGINAL SIGNED 11.03.07 W.R. HALDANE-WILSONE REGISTERED PROFESSIONAL ENGINEER

CONSULTANT DRAWING NO. 0900070502-DWG-S0054

Winnipeg

THE CITY OF WINNIPEG
PUBLIC WORKS DEPARTMENT
ENGINEERING DIVISION

OSBORNE STREET BRIDGE
REHABILITATION & RELATED WORKS

CITY DRAWING NUMBER B109-11-059
SHEET 54 OF 131

SOUTH ABUTMENT AND APPROACH SLAB PHASE 2 REINFORCING

54