


**C** DISPOSAL CELL CROSS SECTION  
C4002 | C4008

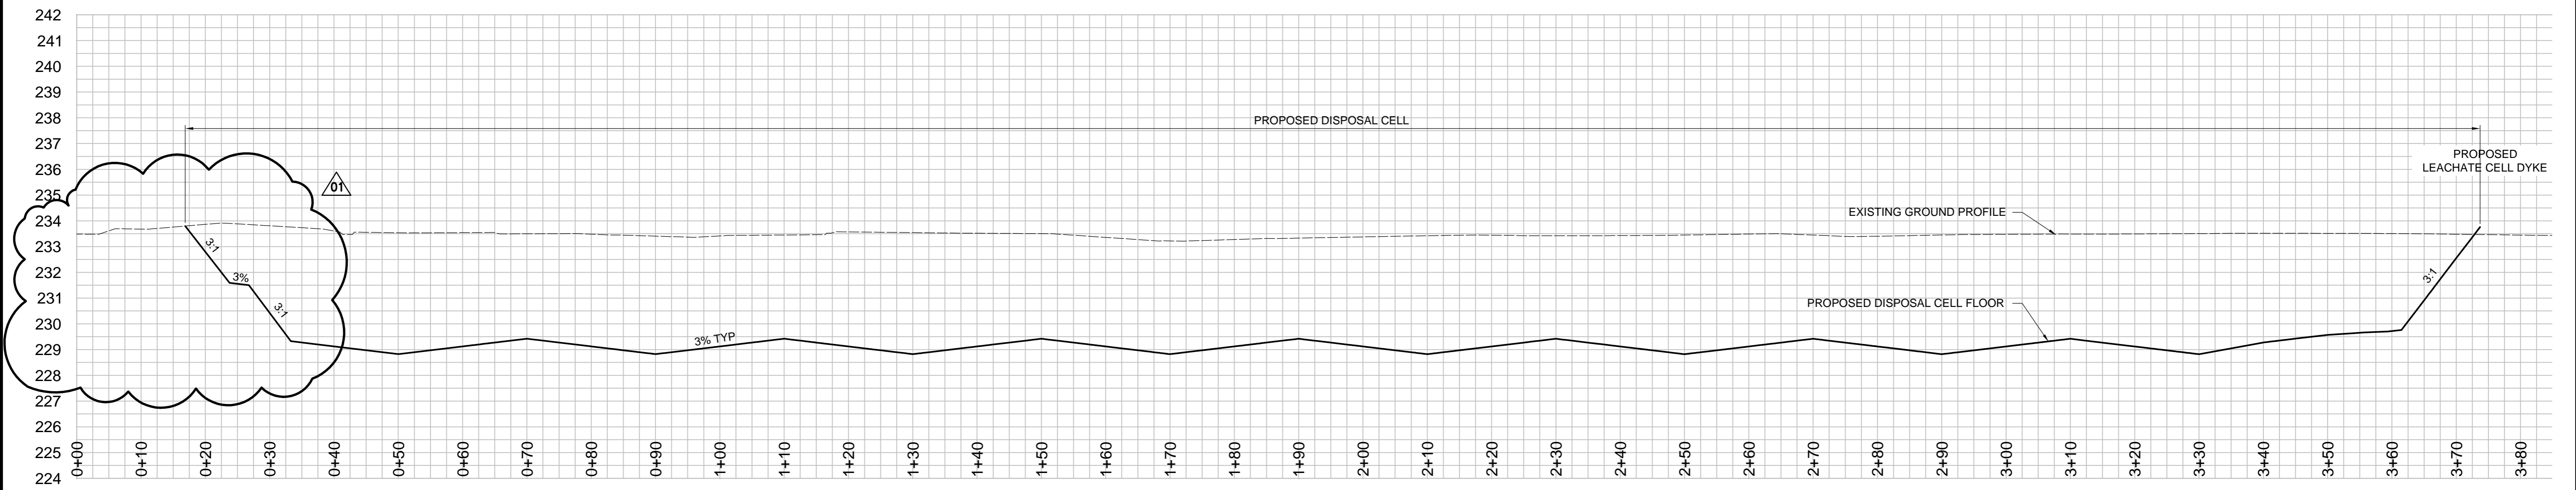

**D** DISPOSAL CELL CROSS SECTION  
C4002 | C4008



B.M.	ELEV.



DESIGNED BY: JM	CHECKED BY: GS
DRAWN BY: GMD	APPROVED BY: BLM
HOR. SCALE: 1 : 500	RELEASED FOR CONSTRUCTION
VERTICAL: 1 : 125	DATE: 14.02.19

ORIGINAL DRAWING  
REVISION "00" SEALED BY  
J.H.J. MULLER  
14.03.25

CONSULTANT DRAWING NO.  
1300120600-DWG-C0019



BRADY ROAD LANDFILL ACCESS ROAD AND DISPOSAL CELL	
DISPOSAL CELL CROSS SECTIONS	

CITY DRAWING NUMBER SWD-D-446
SHEET 19 OF 20
C4008