



TYPICAL C.B.M.H. DETAIL
N.T.S.

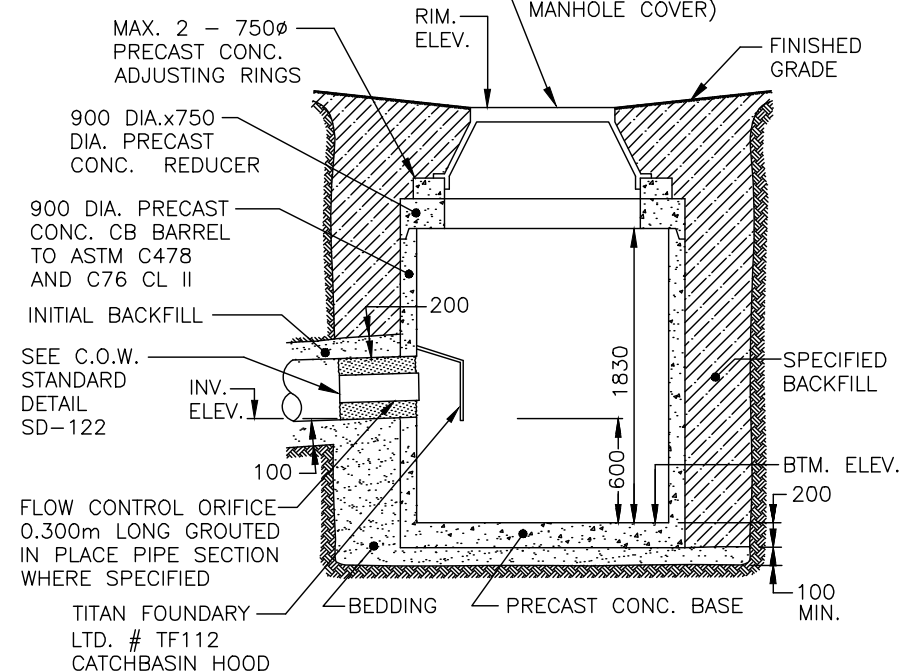

C.B. DETAIL
N.T.S.

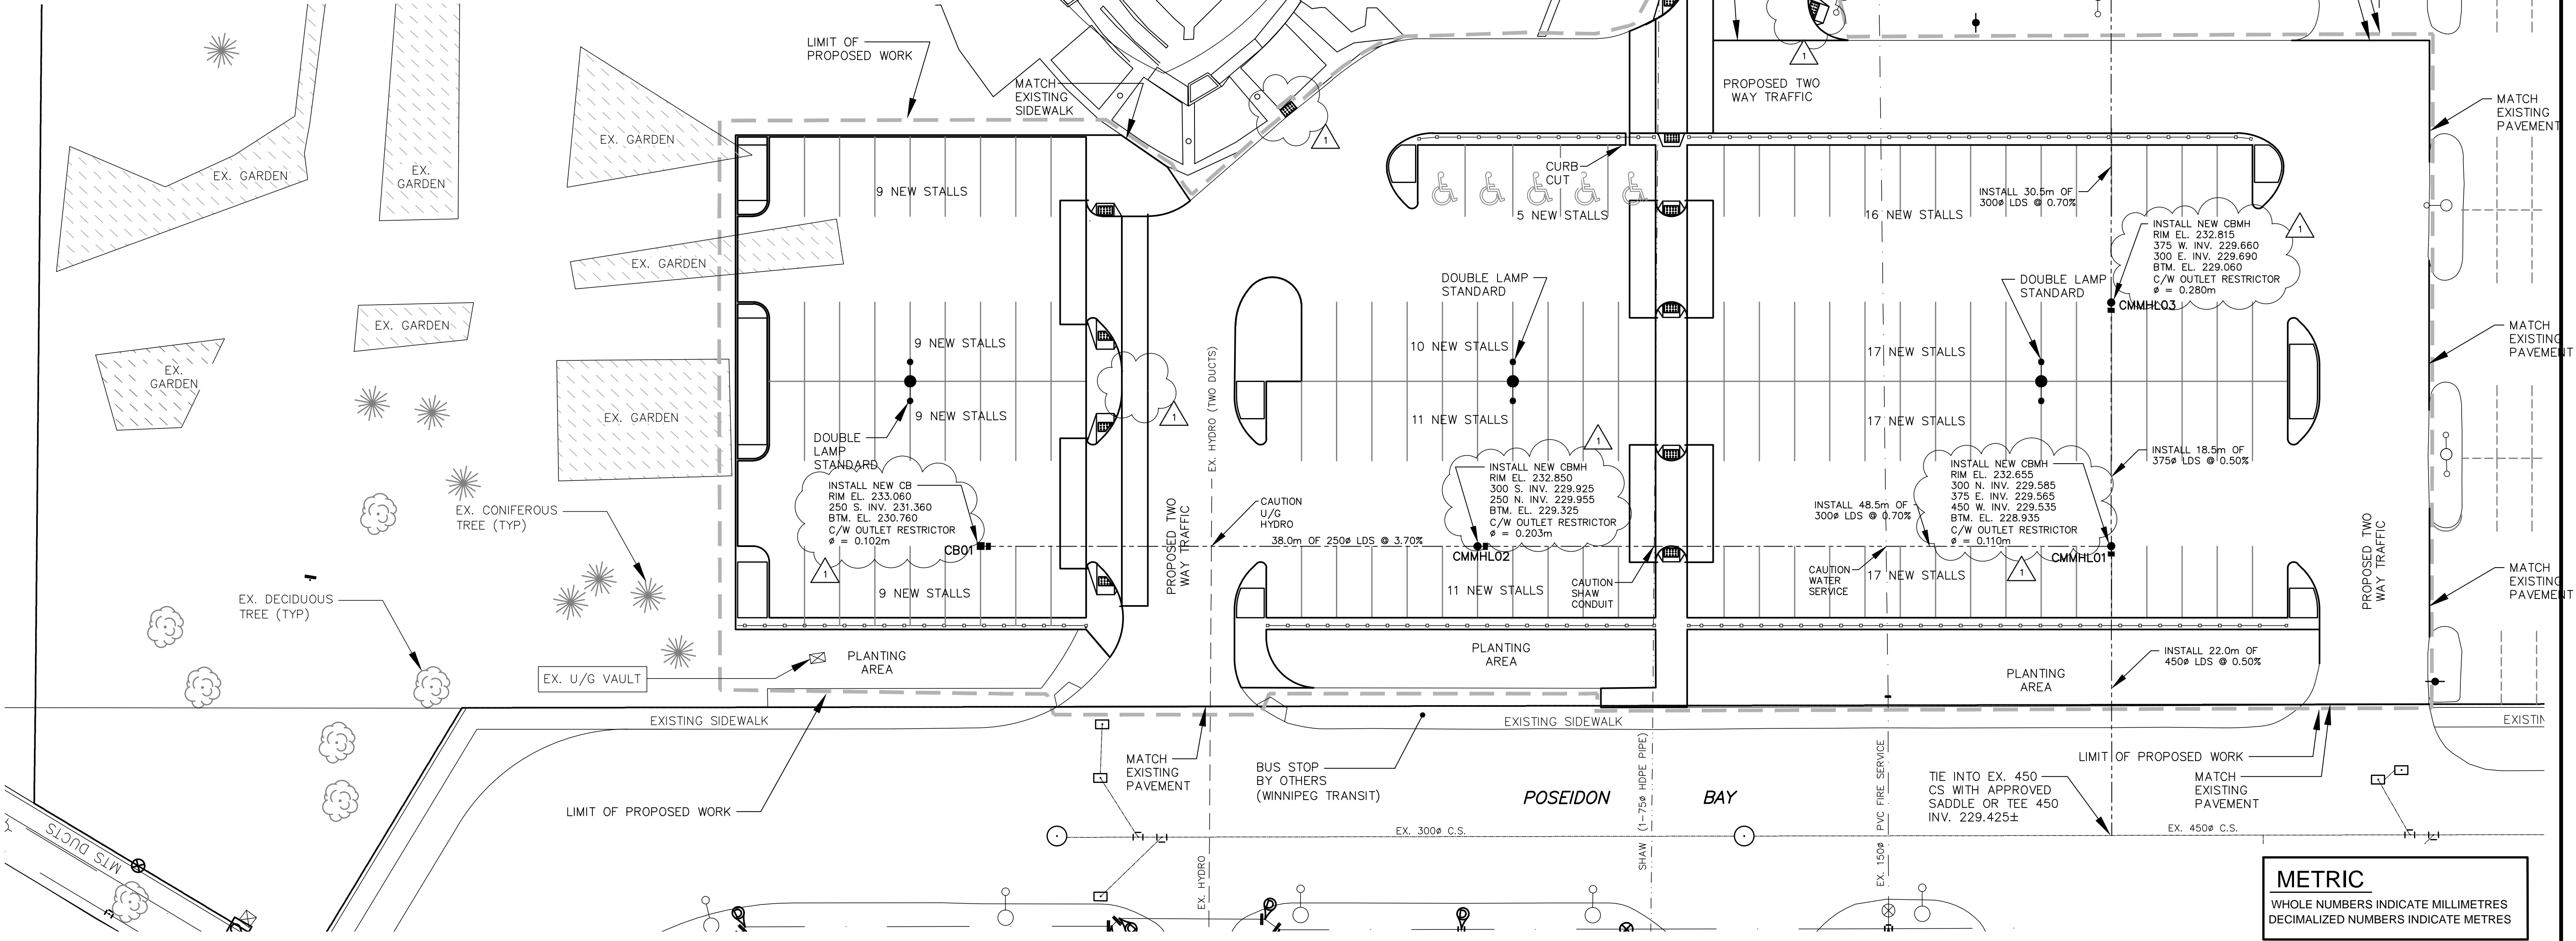

CONSTRUCTION NOTES:

- USE GRANULAR BACKFILL FOR ALL UNDERGROUND WORKS INSTALLED UNDER PROPOSED PAVEMENT.
- PIPE INSTALLED UNDER EXISTING PAVEMENT TO BE INSTALLED BY TRENCHLESS METHOD.
- PIPE INSTALLED UNDER PROPOSED PAVEMENT TO BE INSTALLED BY TRENCHLESS METHOD.

REFER TO DRAWING
C01 FOR GENERAL
CONSTRUCTION NOTES

APEGM
Certificate of Authorization
WSP Canada Inc.
No. 5750 Date: 2015-05-27

METRIC
WHOLE NUMBERS INDICATE MILLIMETRES
DECIMALIZED NUMBERS INDICATE METRES

150 mm WM	WATERMAIN	150 mm WM	---	GAS	---	CENTRELINE OF SWALE ELEVATION	230.000 COS	
Hydrant	HYDRANT	Hydrant	●	HYDRO	---	CATCH BASIN ELEVATION	230.000 CB	
Valve	VALVE	Valve	○	M.T.S.	---	TESTHOLE	---	
300 mm LDS	LAND DRAINAGE SEWER	300 mm LDS	---	PEDESTAL	---	TOPSOIL & SOD	---	
250 mm CS	WASTE WATER SEWER	250 mm CS	---	PROPERTY LINE	---	ASPHALT	---	
Manhole	MANHOLE	Manhole	●	SURVEY BAR	---	CURBING	---	
Catch Basin	CATCH BASIN	Catch Basin	■	CURB STOP	---	TREE	---	
Curb Inlet	CURB INLET	Curb Inlet	▲	GROUND ELEVATION	230.000	CONCRETE	---	
Sign	SIGN	Sign	▲	PAVEMENT ELEVATION	230.000	PAVERS	---	
Lamp Standard	LAMP STANDARD	Lamp Standard	●	TACTILE WARNING STRIP	---		---	
Utility Pole	UTILITY POLE	Utility Pole	●		---		---	
EXISTING	LEGEND - PLAN	NEW	EXISTING	LEGEND - PLAN	NEW	EXISTING	LEGEND - PROFILE	NEW

LOCATION APPROVED UNDERGROUND STRUCTURES

SUPV. U/G STRUCTURES COMMITTEE DATE

NOTE: LOCATION OF UNDERGROUND STRUCTURES AS SHOWN ARE BASED ON THE BEST INFORMATION AVAILABLE BUT NO GUARANTEE IS GIVEN THAT THE EXISTING UTILITIES ARE SHOWN OR THAT THE GIVEN LOCATIONS ARE EXACT. CONFIRMATION OF EXISTENCE AND EXACT LOCATION OF ALL SERVICES MUST BE OBTAINED FROM THE INDIVIDUAL UTILITIES BEFORE PROCEEDING WITH CONSTRUCTION.

C.W.B.M. 52-012..... 233.701m N.E. CORNER OF TAYLOR AVE. AND CAMBRIDGE ST., AT REAR OF NO. 880 CAMBRIDGE ST. FACING TAYLOR AVE., A TABLET IN S. SIDE OF SQUARE CONCRETE VENTILATOR FOR UNDERGROUND GARAGE.

1	ISSUED FOR ADDENDUM 2	15/06/19	BJ
0	ISSUED FOR CONSTRUCTION	15/06/19	BJ
0	ISSUED FOR TENDER	15/06/27	---
1	---	11/04/20	---
NO.	REVISIONS	DATE	BY

WSP

1600 BUFFALO PLACE
WINNIPEG, MB, R3T 6B6
PHONE: 204-477-6650
FAX: 204-474-2864
WWW.WSPGROUP.COM

DESIGNED BY B.J.
DRAWN BY G.P.
HOR. SCALE: 1:250 (A1)
VERT. SCALE: ---
DATE: APRIL 2015

CHECKED BY B.J.
APPROVED BY B.J.
RELEASED FOR CONSTRUCTION
DATE

ENGINEER'S SEAL

ORIGINAL DRAWING SEALED
by G.B. JONSON
and DATED
May 27, 2016

CONSULTANT DRAWING NO.
121-24877-C04

THE CITY OF WINNIPEG
PLANNING, PROPERTY & DEVELOPMENT

**PAN AM INDOOR POOL
PARKING LOT REDEVELOPMENT-PHASE 1
SITE SERVICING PLAN**

CITY DRAWING NO.
432-2015-C04

SHEET 4 OF 9

REV. 1

C04