

SIGNAGE INSTALLATION:


— INSTALL NEW SIGNS AND SIGN POSTS ACCORDING TO THE FOLLOWING TYPICAL SIGNAGE IDENTIFICATION, AS SHOWN IN THE DRAWING:

① NO PARKING – FIRE LANE	③ HANDICAP PARKING ONLY	⑤ TWO WAY TRAFFIC
② STOP SIGN	④ PEDESTRIAN CROSSING	⑥ ONE WAY DO NOT ENTER

— ALL NEW SIGNS AND SIGN POSTS INSTALLED SHALL BE IN ACCORDANCE WITH APPLICABLE CITY OF WINNIPEG SPECIFICATIONS AND BY-LAWS AND THE MANUAL OF UNIFORM TRAFFIC CONTROL DEVICES FOR CANADA.

KEYNOTES:


- ① STOP LINE PAINTED
- ② NEW SCREEN FENCE (SEE DETAIL)
- ③ PARKING STALL LINE PAINTING (TYP.)
- ④ ACCESSIBILITY SYMBOL PAINTED (TYP.)
- ⑤ DETECTABLE WARNING STRIP TILE AT PEDESTRIAN CROSSING
- ⑥ SOLID PAINTED ROAD CENTERLINE
- ⑦ PAINTED DIRECTIONAL ARROWS
- ⑧ PAINTED PEDESTRIAN CROSSING LINES

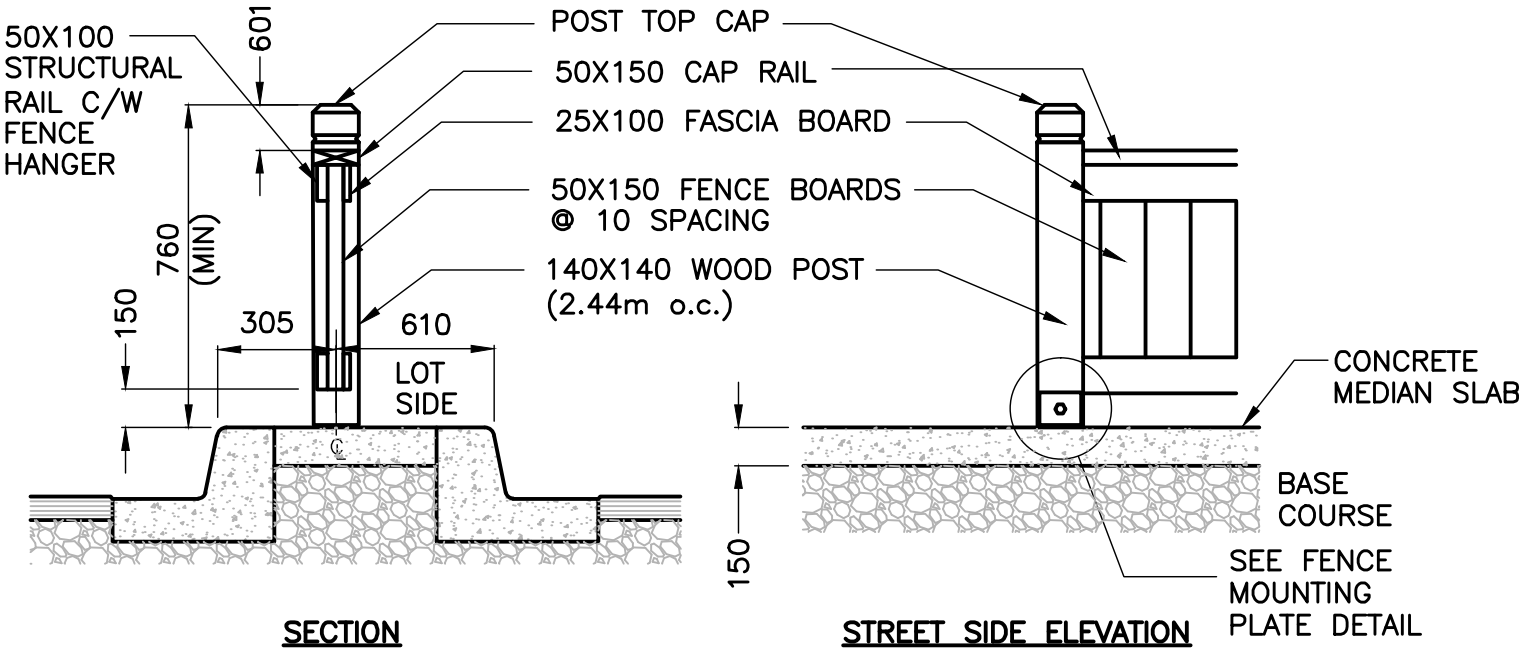

NOTES:

- ALL WOOD TO BE PRESSURE TREATED & STAINED W/ EXTERIOR STAIN.
- FENCE PANELS TO BE LEVEL. ADJUST GAP BETWEEN FENCE AND GRADE TO ACHIEVE LEVEL PANELS. MIN. GAP IS 50mm AND MAX. GAP IS 150mm. IF CHANGE IN GRADE IS MORE THAN 150mm, CONTRACTOR TO STEP PANEL.
- ALL METAL TO BE HOT DIPPED GALVANIZED. ONLY DECK SCREWS OR BOLTS TO BE USED.

LIGHT PROOF SCREEN FENCE DETAIL
N.T.S.

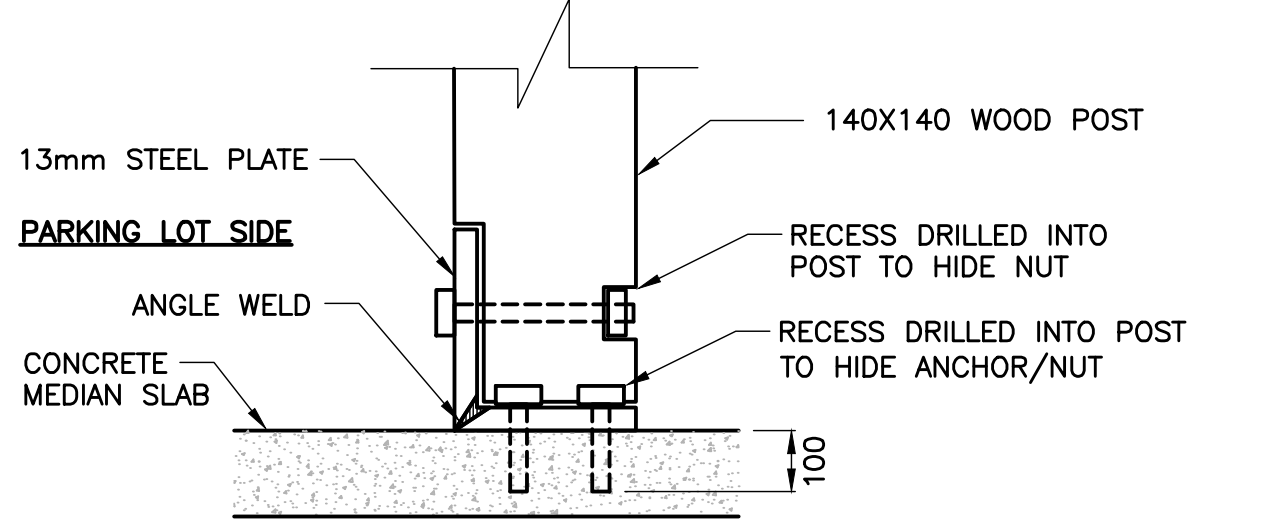

NOTES:


- HOT DIPPED GALVANIZED AFTER FABRICATION.
- FASTEN TO CONCRETE WITH 2 – STAINLESS STEEL 16mm x 100 EMBEDMENT HILTI HIT-HY 200 EPOXY ANCHORS.

FENCE MOUNTING PLATE DETAIL
N.T.S.

REFER DRAWING C01 FOR GENERAL CONSTRUCTION NOTES

APEGM
Certificate of Authorization
WSP Canada Inc.
No. 5750 Date: 2015-05-27

METRIC
WHOLE NUMBERS INDICATE MILLIMETRES
DECIMALIZED NUMBERS INDICATE METRES

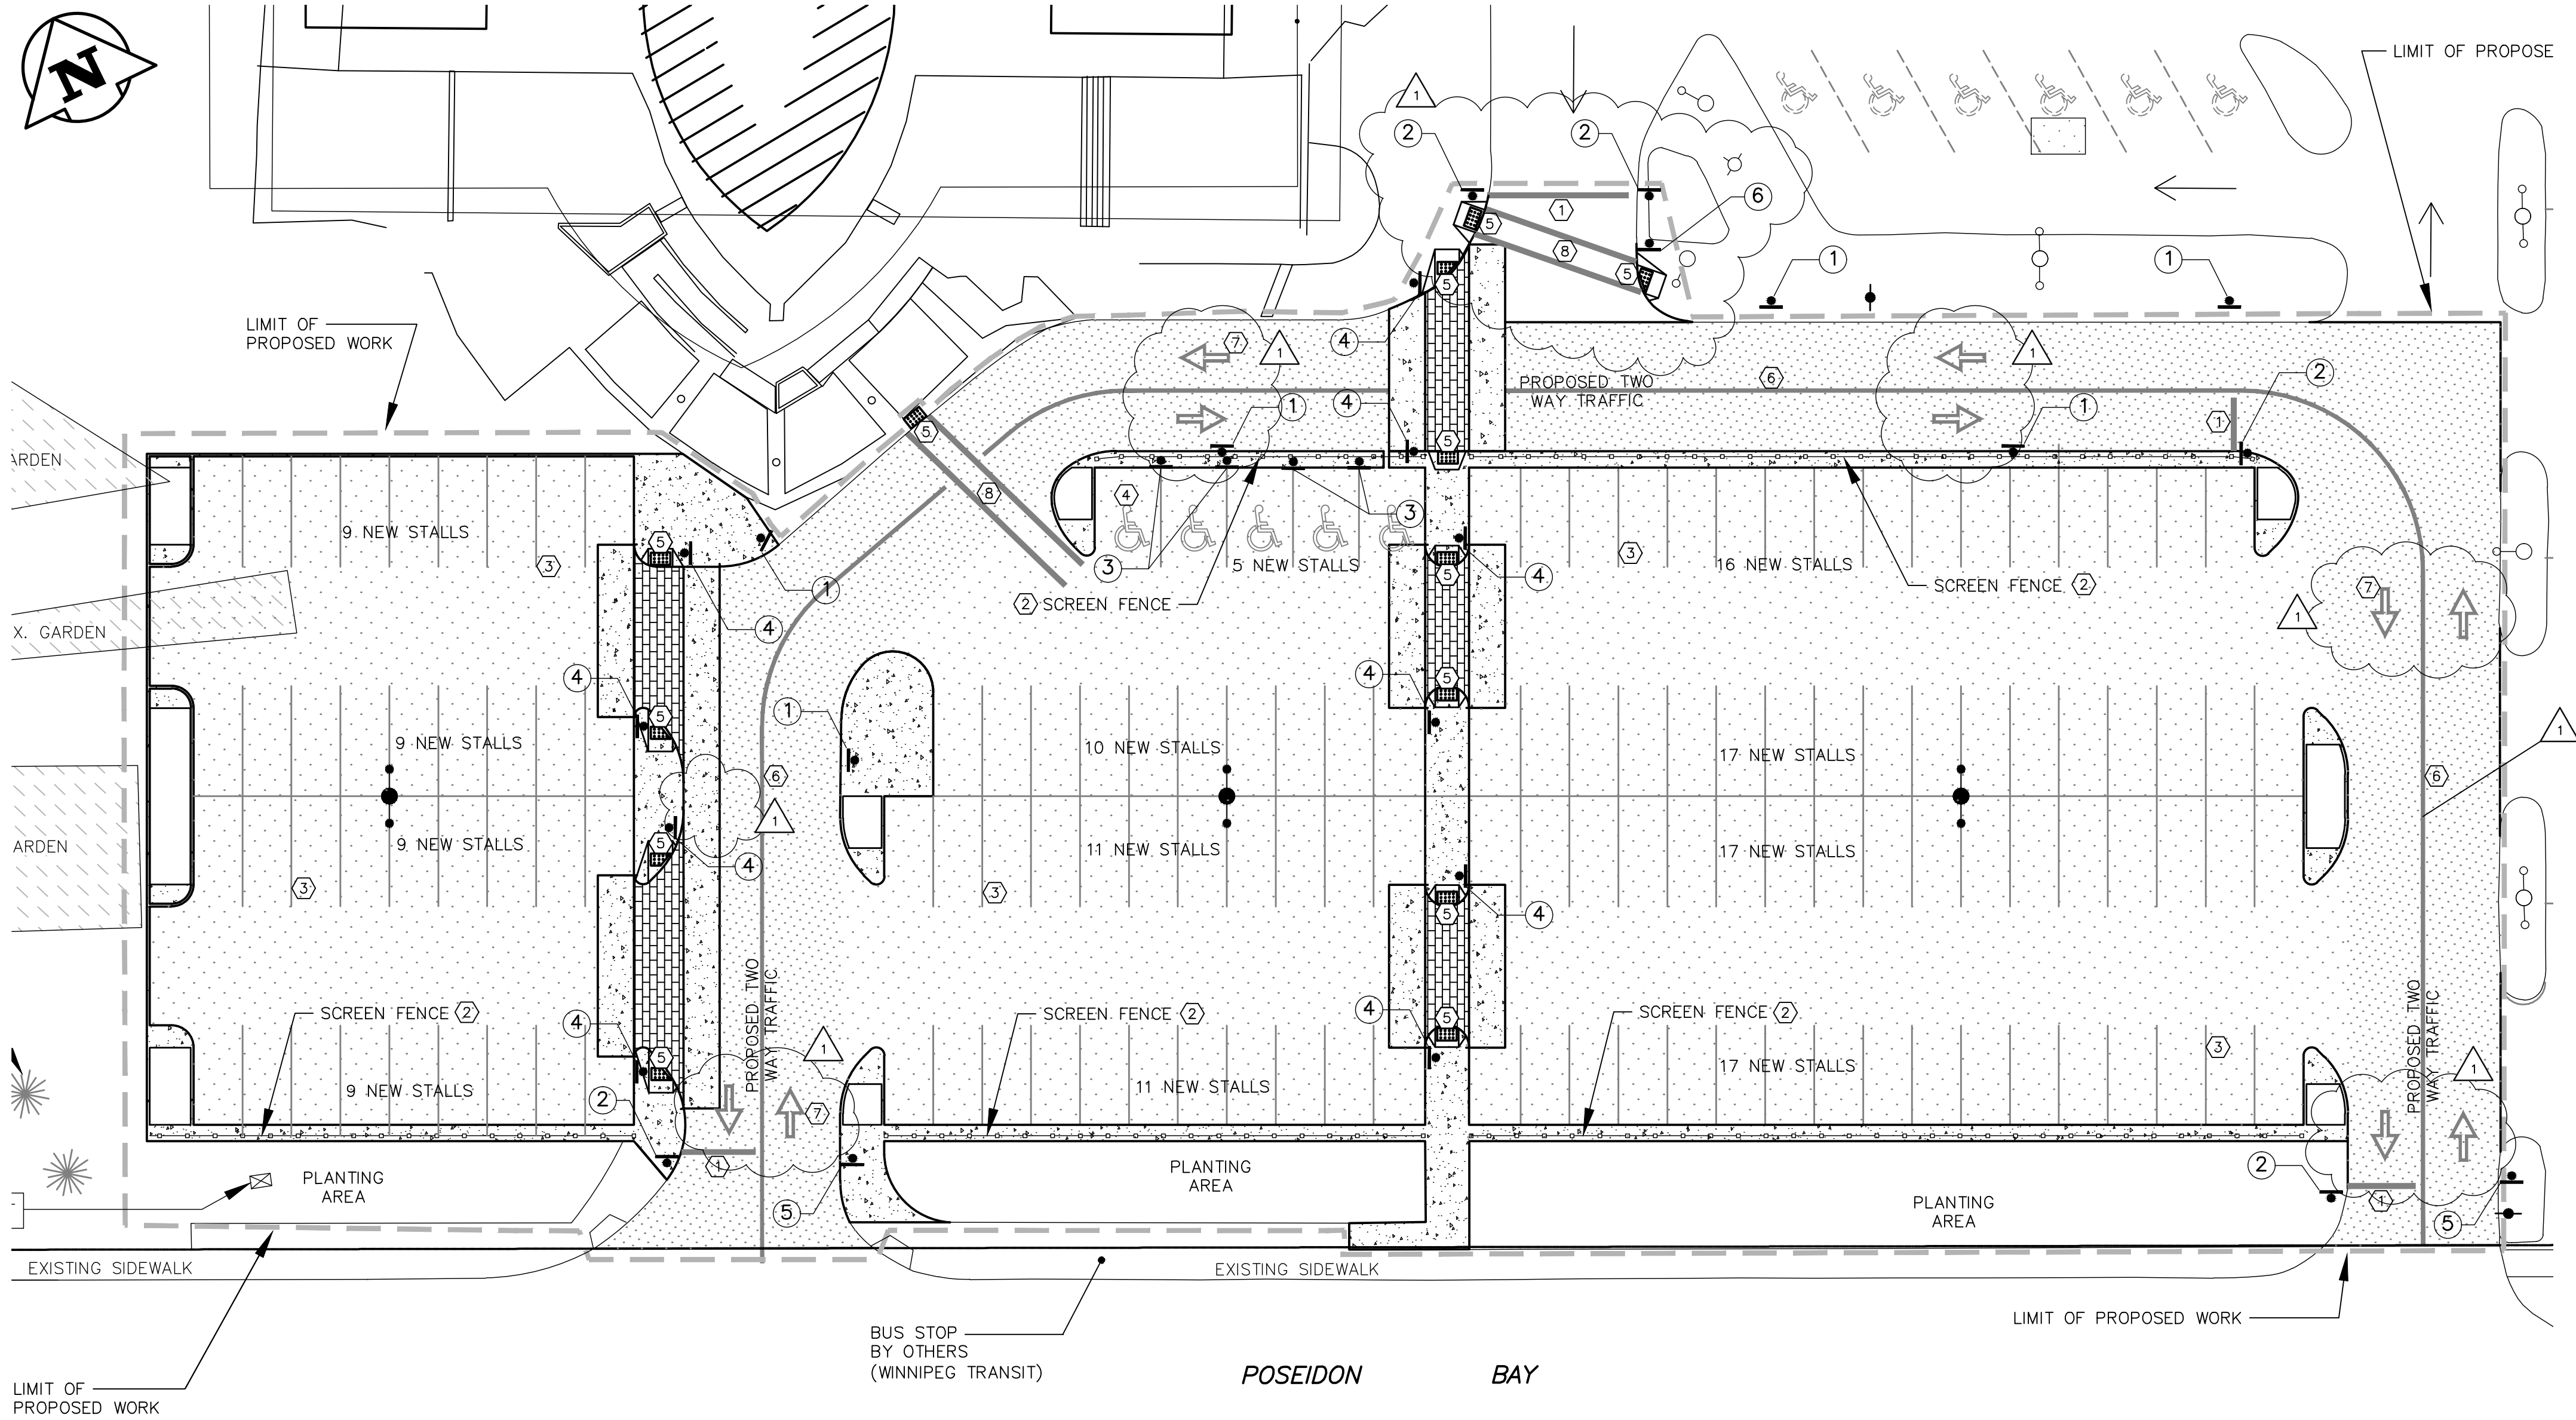

150 mm WM	WATERMAIN	150 mm WM	---	GAS	CENTRELINE OF SWALE	230.000 COS	LOCATION APPROVED UNDERGROUND STRUCTURES	C.W.B.M. 52-012..... 233.701m N.E. CORNER OF TAYLOR AVE. AND CAMBRIDGE ST., AT REAR OF NO. 880 CAMBRIDGE ST. FACING TAYLOR AVE., A TABLET IN S. SIDE OF SQUARE CONCRETE VENTILATOR FOR UNDERGROUND GARAGE.	1600 BUFFALO PLACE WINNIPEG, MB, R3T 6B8 PHONE: 204-477-6550 FAX: 204-474-2864 WWW.WSPGROUP.COM	DESIGNED BY B.J. CHECKED BY B.J. DRAWN BY G.P. APPROVED BY B.J. HOR. SCALE: 1:250 (A1) VERT. SCALE: DATE: APRIL 2015	ENGINEER'S SEAL CONSULTANT DRAWING NO. 121-24877-C06	THE CITY OF WINNIPEG PLANNING, PROPERTY & DEVELOPMENT PAN AM INDOOR POOL PARKING LOT REDEVELOPMENT-PHASE 1 FENCING AND SIGNAGE PLAN	CITY DRAWING NO. 432-2015-C06 SHEET 6 OF 9 REV. 1 C06
300 mm LDS	LAND DRAINAGE SEWER	300 mm LDS	---	PEDESTAL	CATCH BASIN ELEVATION	230.000 CB							
250 mm CS	WASTE WATER SEWER	250 mm CS	---	PROPERTY LINE	TESTHOLE	---	---	---	---	---	---	---	
---	MANHOLE	---	---	SURVEY BAR	TOPSOIL & SOD	---	---	---	---	---	---	---	
---	CATCH BASIN	---	---	CURB STOP	ASPHALT	---	---	---	---	---	---	---	
---	CURB INLET	---	---	---	CURBING	---	---	---	---	---	---	---	
---	SIGN	---	---	GROUND ELEVATION	TREE	---	---	---	---	---	---	---	
---	LAMP STANDARD	---	---	PAVEMENT ELEVATION	CONCRETE	---	---	---	---	---	---	---	
---	UTILITY POLE	---	---	---	PAVERS	---	---	---	---	---	---	---	
---	---	---	---	---	TACTILE WARNING STRIP	---	---	---	---	---	---	---	
EXISTING	LEGEND - PLAN	NEW	EXISTING	LEGEND - PLAN	NEW	EXISTING	LEGEND - PROFILE	NEW	---	---	---	---	