A1 SIZE – 594mm x 841mm

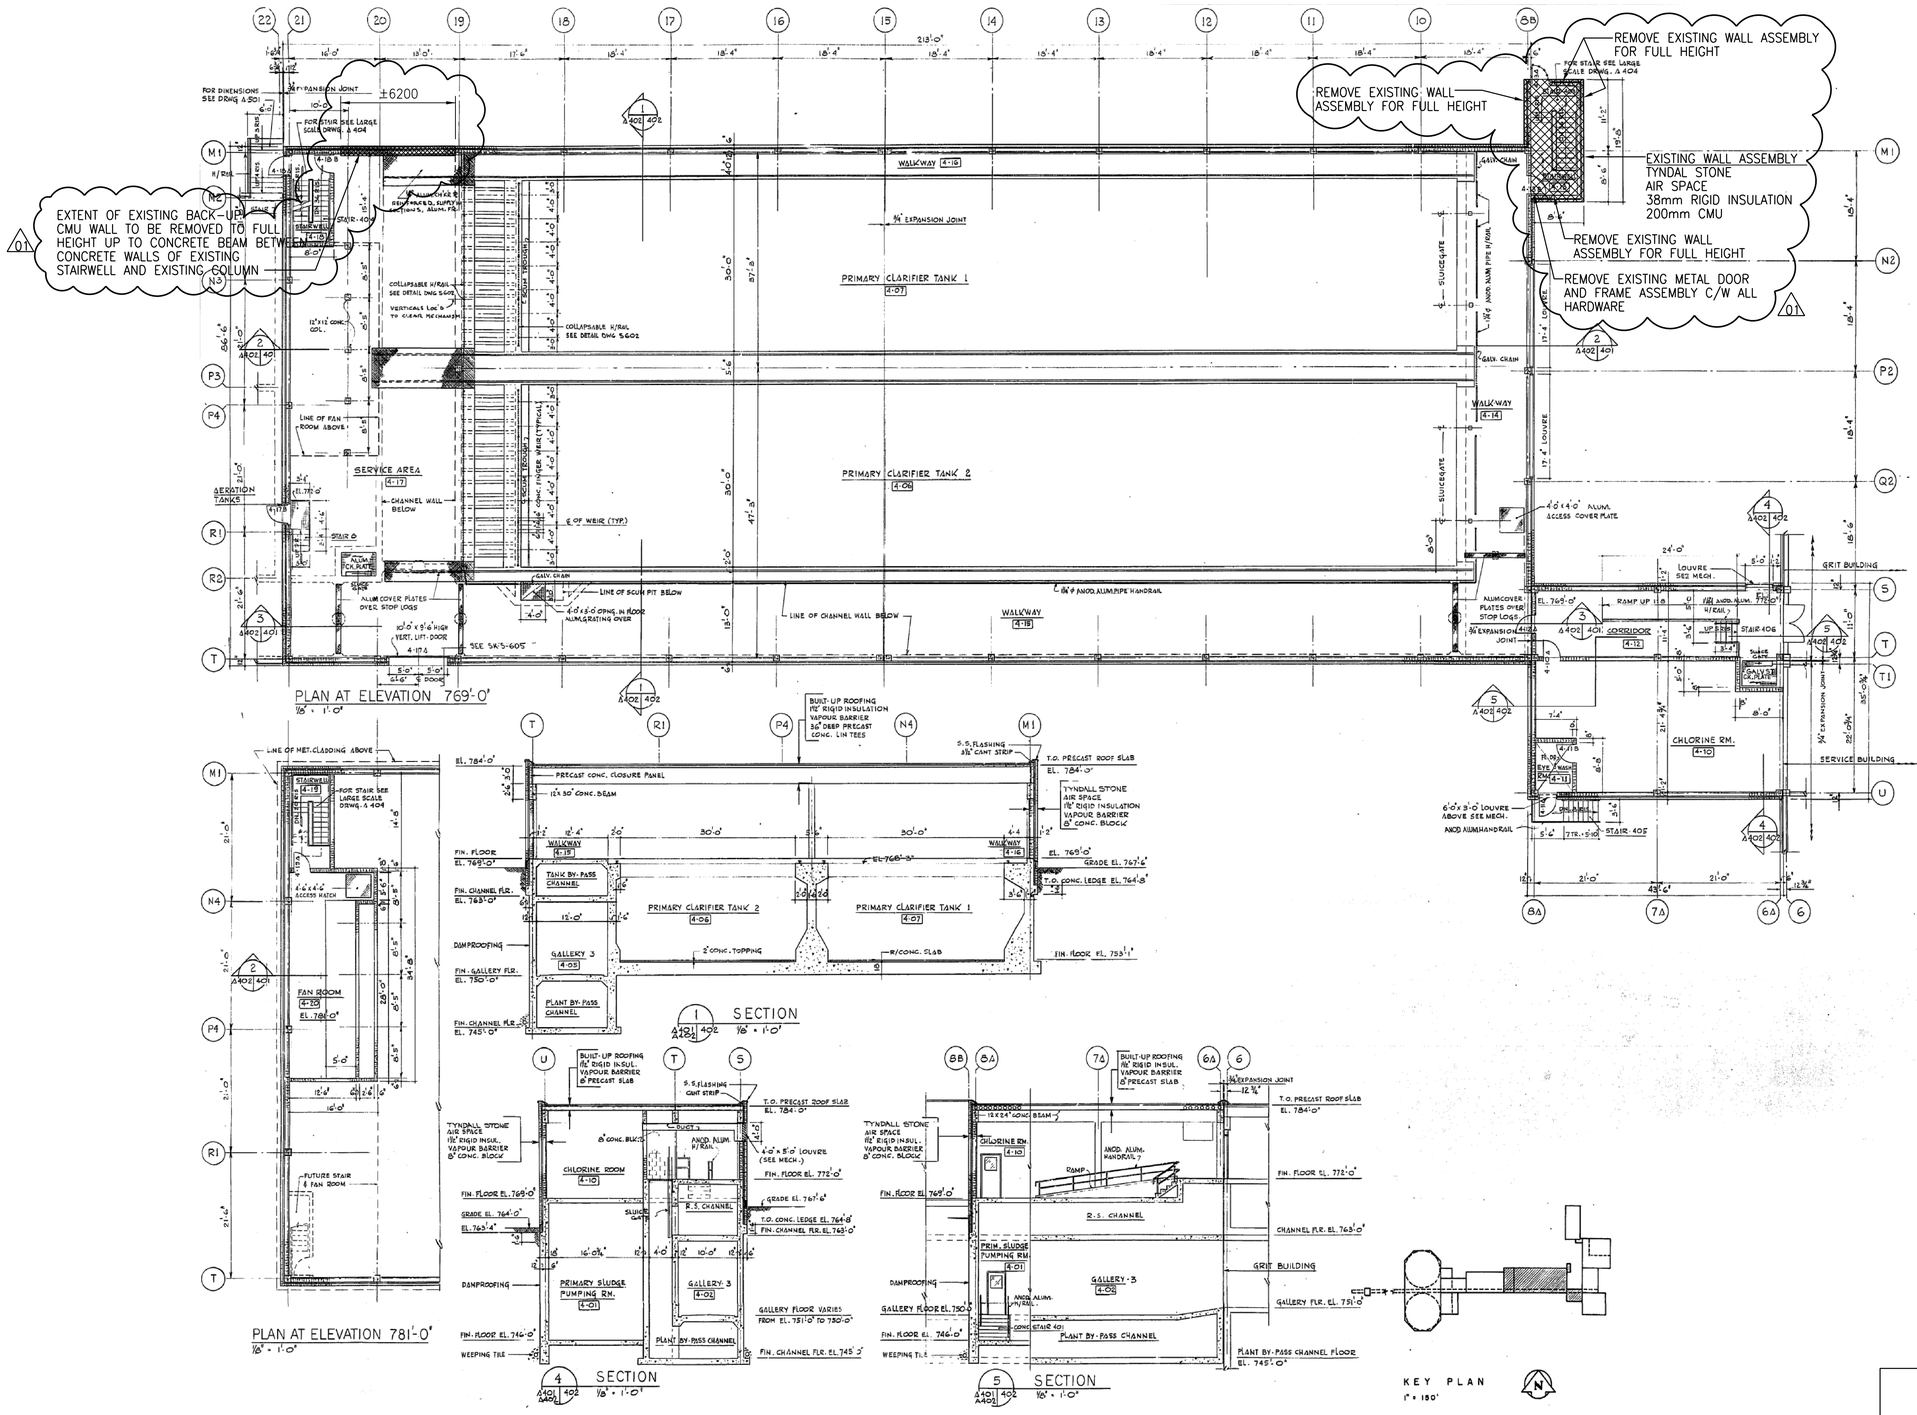

NOTE:

1. REPAIR ALL DAMAGE TO EXISTING DURING DEMOLITION WORK TO MATCH EXISTING

SEALING ARCHITECT OR ENGINEER ACCEPTS RESPONSIBILITY ONLY FOR AREAS IDENTIFIED BY CLOUDING ON THIS DRAWING.

NOTE: THIS DRAWING SUPERSEDES DRAWING SEP-52

APEGM
Certificate of Authorization
CH2M HILL Canada Ltd.
No. 1441

NO.	REVISIONS	DATE	DESIGN	CHECK
01	ISSUED FOR ADDENDUM NO.2	09/2015	R.Z	J.C.
00	ISSUED FOR TENDER	08/2015	N.B.	J.C.

CH2MHILL CANADA Architects Inc.
SNC·LAVALIN
KGS GROUP CONSULTING ENGINEERS

DESIGNED BY: R. ZAKKO	CHECKED BY: B. KOLIS-HUPA
DRAWN BY: N. BOYCHUK	APPROVED BY: R. ZAKKO
SCALE: 1:50	ISSUED FOR CONSTRUCTION BY: T. TURZAK
DATE: 2015/08/13	DATE: 2015/08/13
CONSULTANT NO.: 474248	

ENGINEER'S SEAL
PROVINCE OF MANITOBA
REID ZAKKO
REGISTERED ARCHITECT

Winnipeg
THE CITY OF WINNIPEG
WATER AND WASTE DEPARTMENT

SOUTH END WATER POLLUTION CONTROL CENTRE
SEWPCC UPGRADING/EXPANSION PROJECT
BUILDING
PRIMARY CLARIFICATION BUILDING
EXISTING FLOOR PLAN EL 769'-0"

CITY DRAWING NUMBER	SHEET	REV.	SIZE
1-0102-BGAD-P051		01	A1

PLOT DATE: 2015\09\10
FILE NAME: 1-0102-BGAD-P051.dgn

©CH2M HILL 2015. ALL RIGHTS RESERVED.