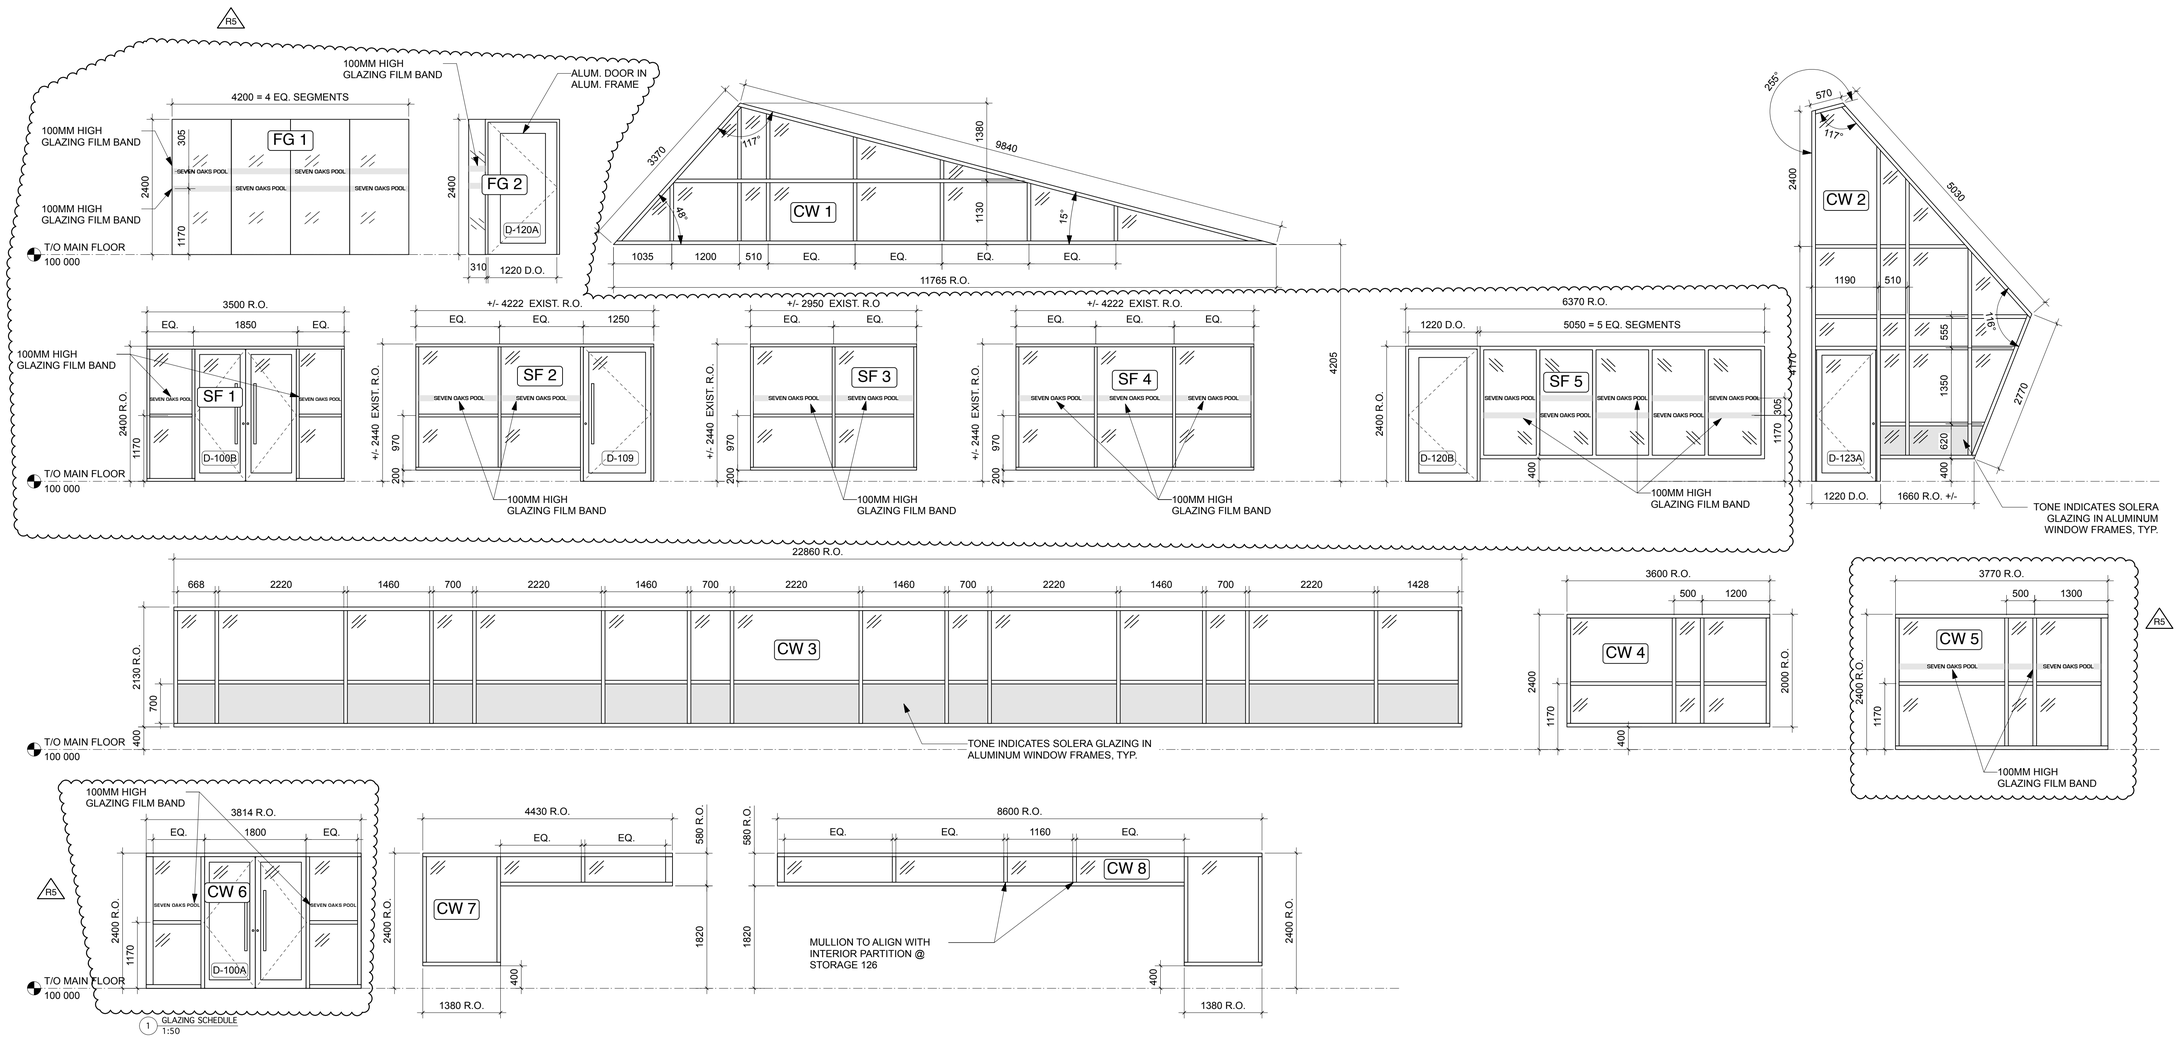

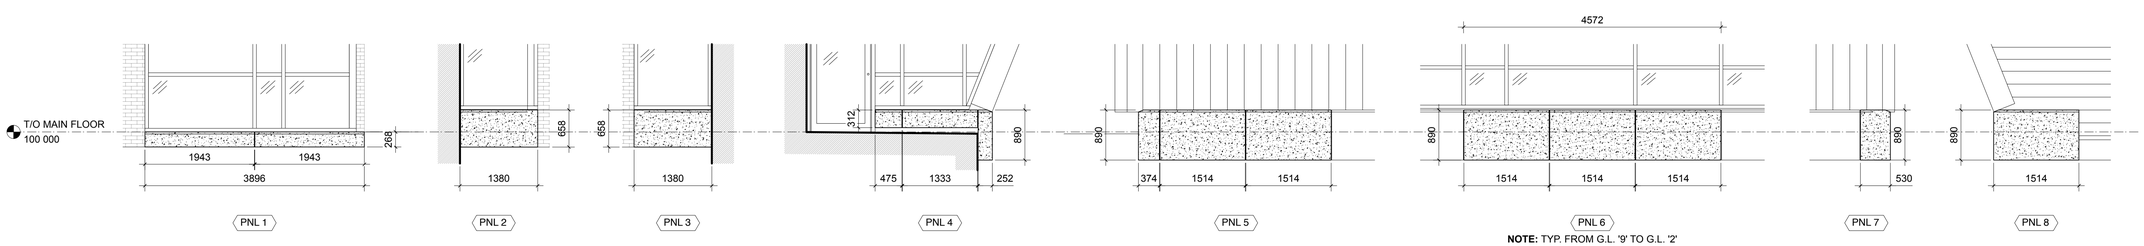

NOTE: TYP. FROM G.L. '9' TO G.L. '2'

R5 ALTERNATIVELY, ARCHITECTURAL PRECAST CONCRETE PANELS PORTIONS OF PNL 5 & PNL6 THAT ARE 1514 IN WIDTH CAN BE COMBINED AS SOLID (NO FAUX JOINTS) TO ALGIN W/ GRIDLINES

Printed on post-consumer recycled content paper.

This drawing must not be scaled. The contractor shall verify all dimensions and other data on site prior to commencement of work. All discrepancies, errors, and omissions are to be reported to the architect. Drawing and specifications, as instruments of service, are the property of the architect, the copyright to the same being reserved to him. No reproduction may be made without the permission of the architect, and when made, must bear his name. All prints to be returned to the architect on request.

PRAIRIE ARCHITECTS INC.
Creating Sustainable Futures

300 - 141 Bannatyne Ave., Winnipeg, MB, R3B 0R3
telephone | 204.956.0938 **fax** | 204.943.5597
web | www.prairiearchitects.ca

issue / rev.

#	date	issue notes
5	2016.08.25	addendum 03
4	2016.07.15	ISSUED FOR CONSTRUCTION

professional seals

project information

SEVEN OAKS POOL RENOVATION & ADDITION

444 ADSUM DRIVE
WINNIPEG, MB
CANADA

client

CITY OF WINNIPEG
4TH FLOOR - 85 KING ST.
WINNIPEG, MB

drawing information

GLAZING SCHEDULE

drawn by: **LW**
approved by: **DF**

scale: **1:50**
date issued: **2016.07.15**
proj. #: **2014.66**
rev. #: **R-0**

SEVEN OAKS POOL RENOVATION & ADDITION
BID OPPORTUNITY NO. 645-2016

A3 02