




1 BUILDING SECTION
Scale: 1:100

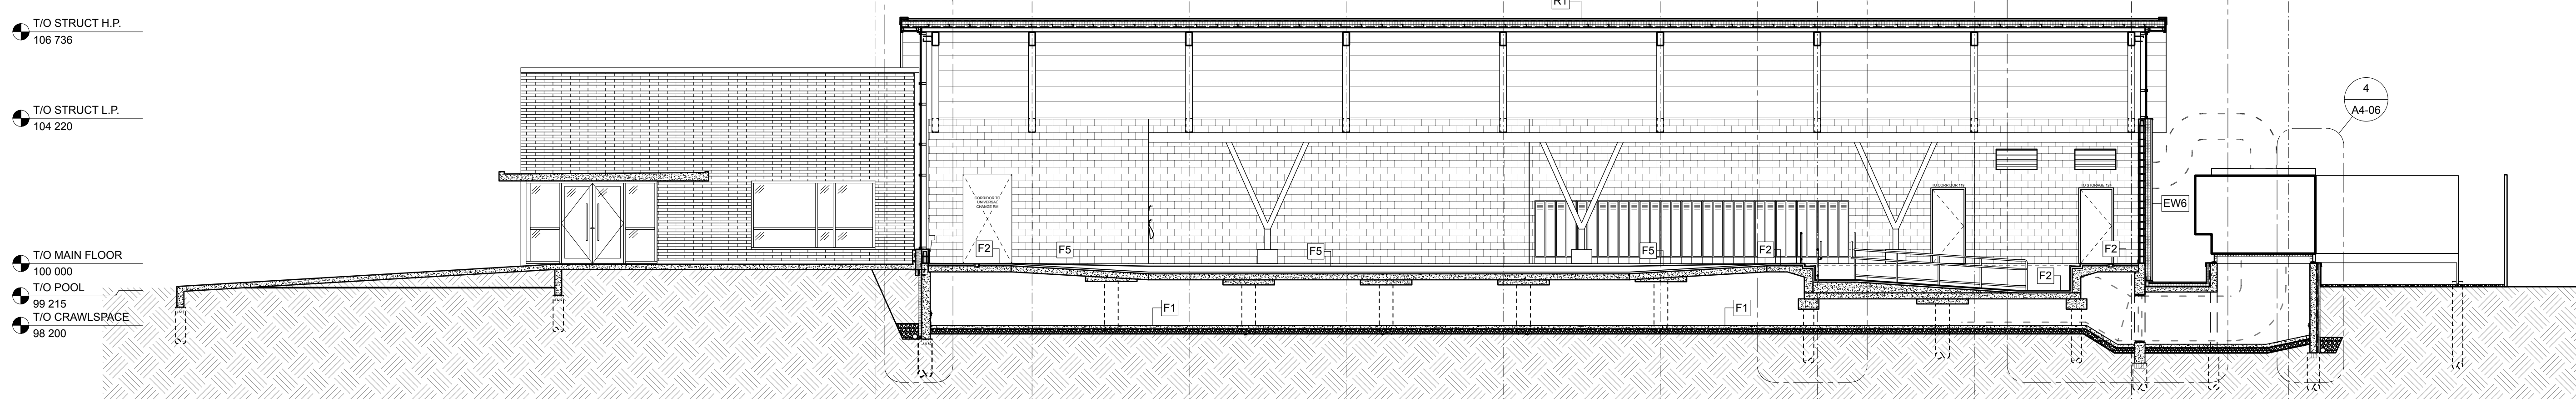


2 BUILDING SECTION
Scale: 1:100

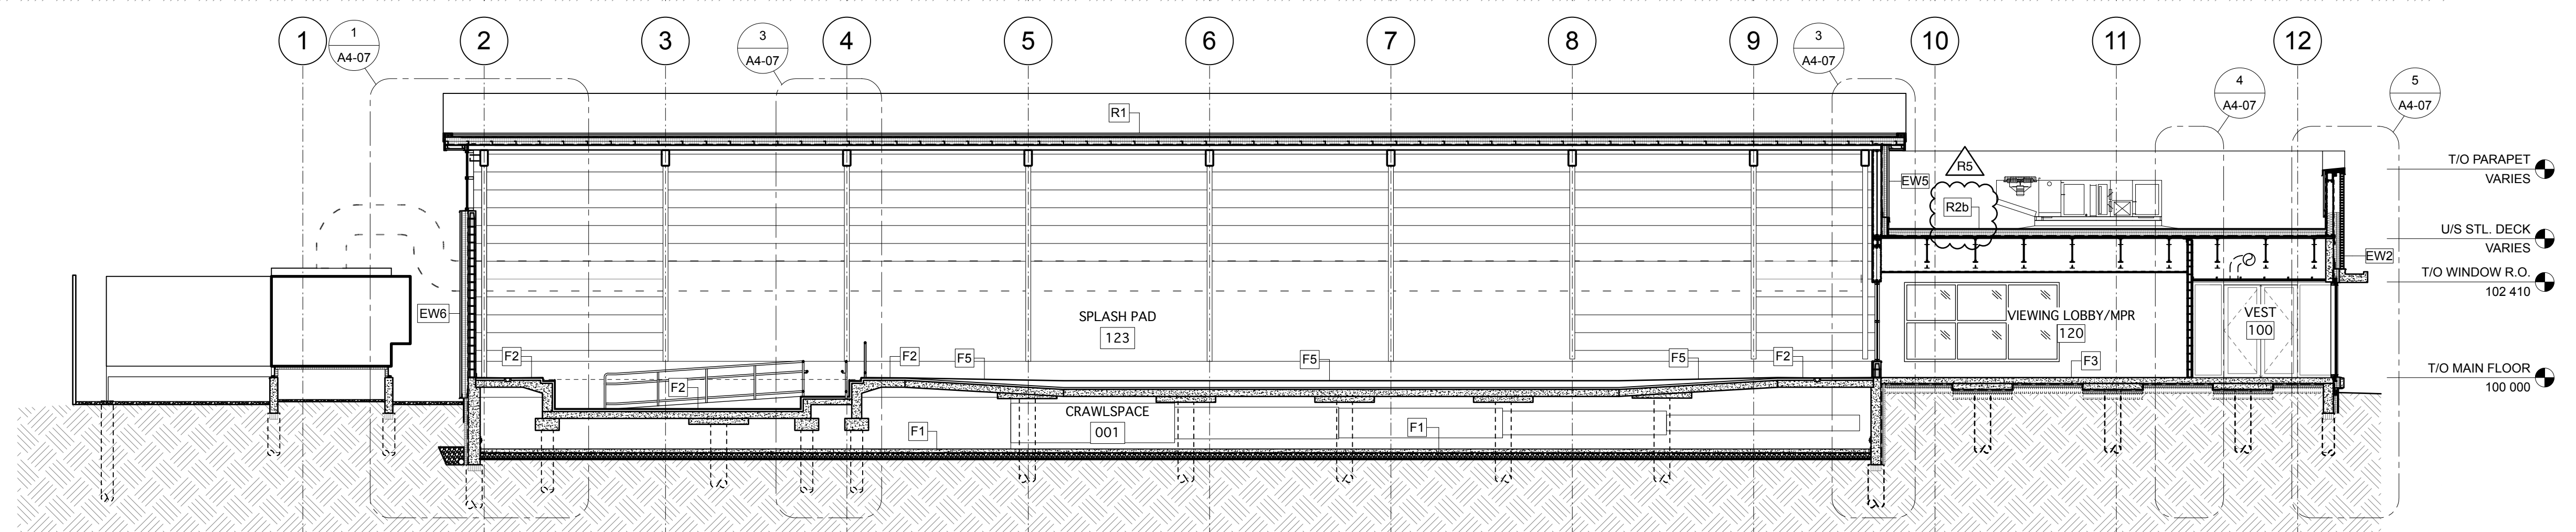

3 BUILDING SECTION
Scale: 1:100

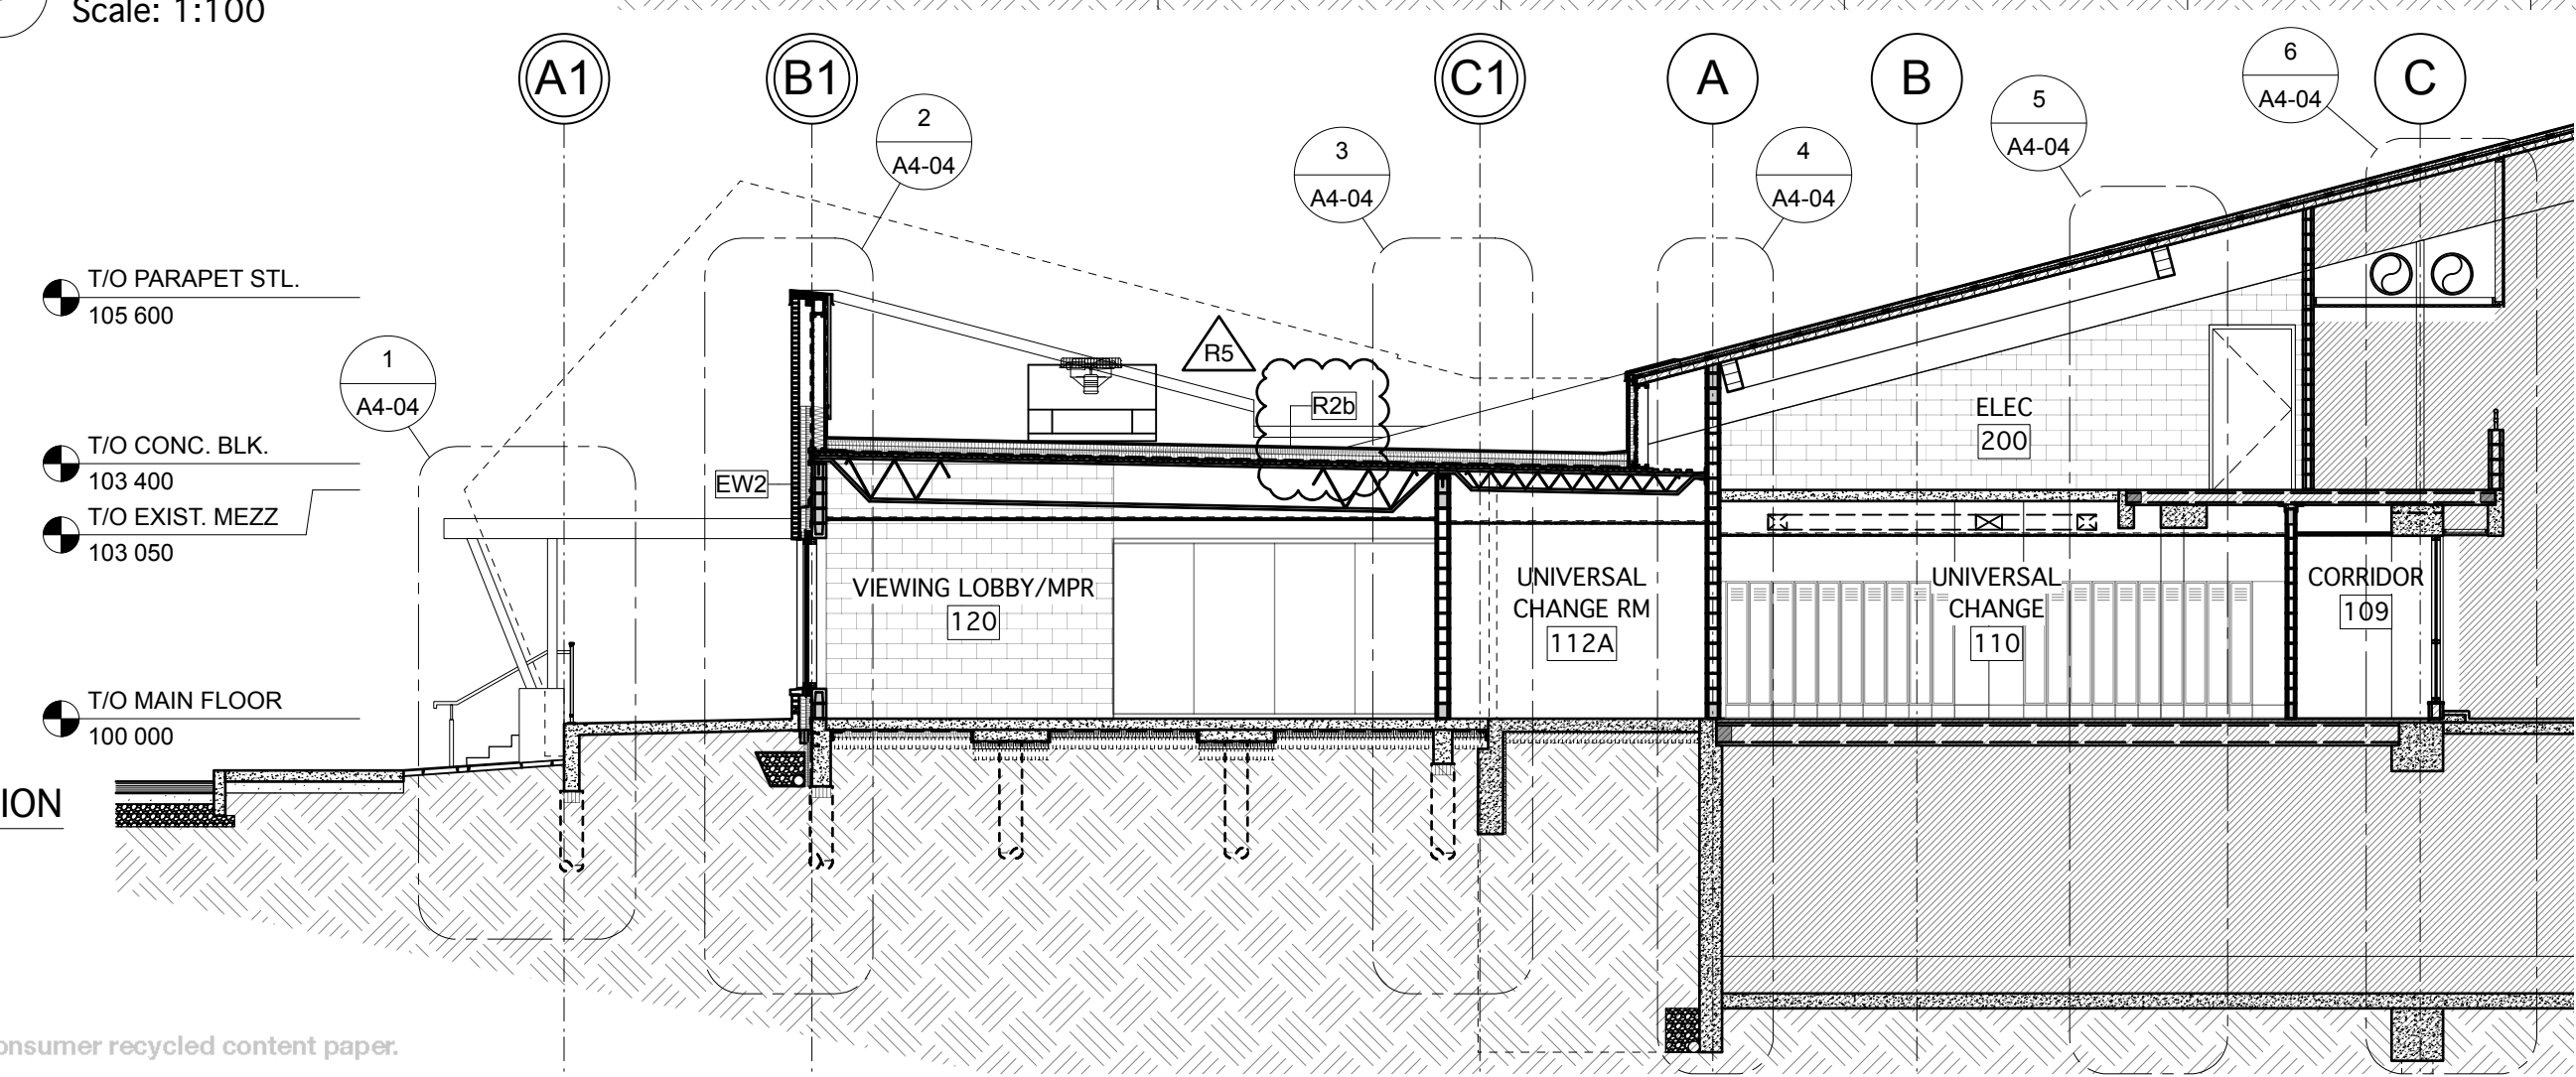

4 BUILDING SECTION
Scale: 1:100

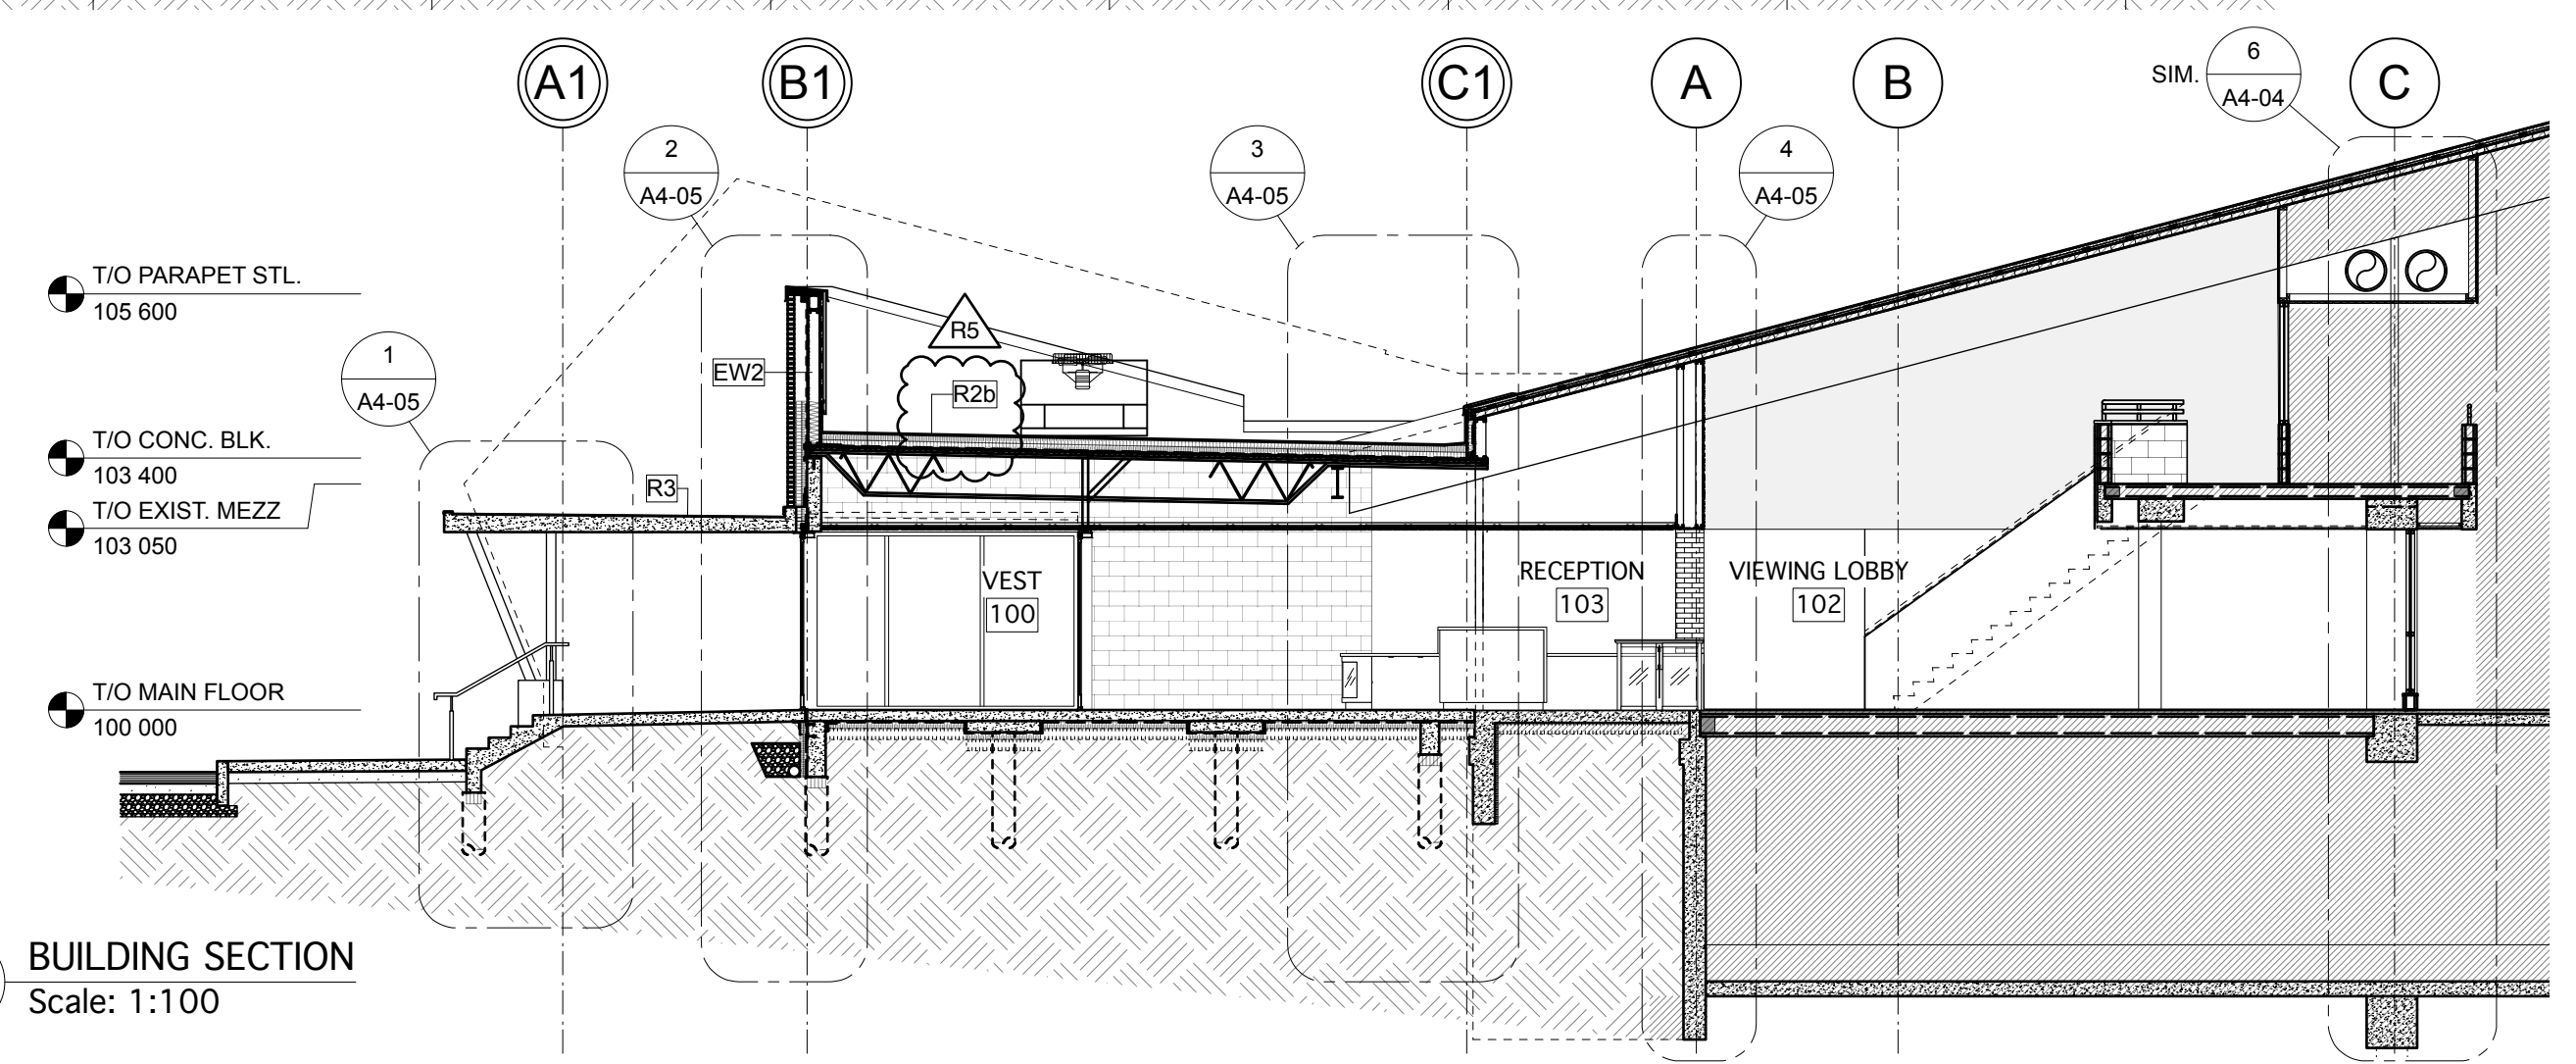

5 BUILDING SECTION
Scale: 1:100

Issue / rev.

#	date	issue notes
5	2016.08.25	addendum 03
4	2016.07.15	issued for construction
3	2016.06.13	issued for 99% review
2	2015.12.02	issued for class 1 pricing
1	2015.03.03	issued for class 'c' pricing

professional seals

project information

**SEVEN OAKS POOL
RENOVATION & ADDITION**

444 ADSUM DRIVE
WINNIPEG, MB
CANADA

client

CITY OF WINNIPEG
4TH FLOOR - 85 KING ST.
WINNIPEG, MB

drawing information

**BUILDING
SECTIONS**

drawn by: LW/JDB
approved by: DF

scale: 1:100
date issued: 2016.07.15
proj. #: 2014.66
rev. #: R-0

**A4
01**

This drawing must not be used for any other project without the written consent of Prairie Architects Inc. All dimensions, notes, and annotations are to be reported to the architect. Drawing and specifications are instruments of service, and are the property of the architect. No reproduction may be made without the permission of the architect, and when made, must bear the name of the architect on request. Copyright in this drawing is reserved to the architect. All rights reserved.