


1 WALL SECTION
A5.2 SCALE 1:10

2 WALL SECTION
A5.2 SCALE 1:10

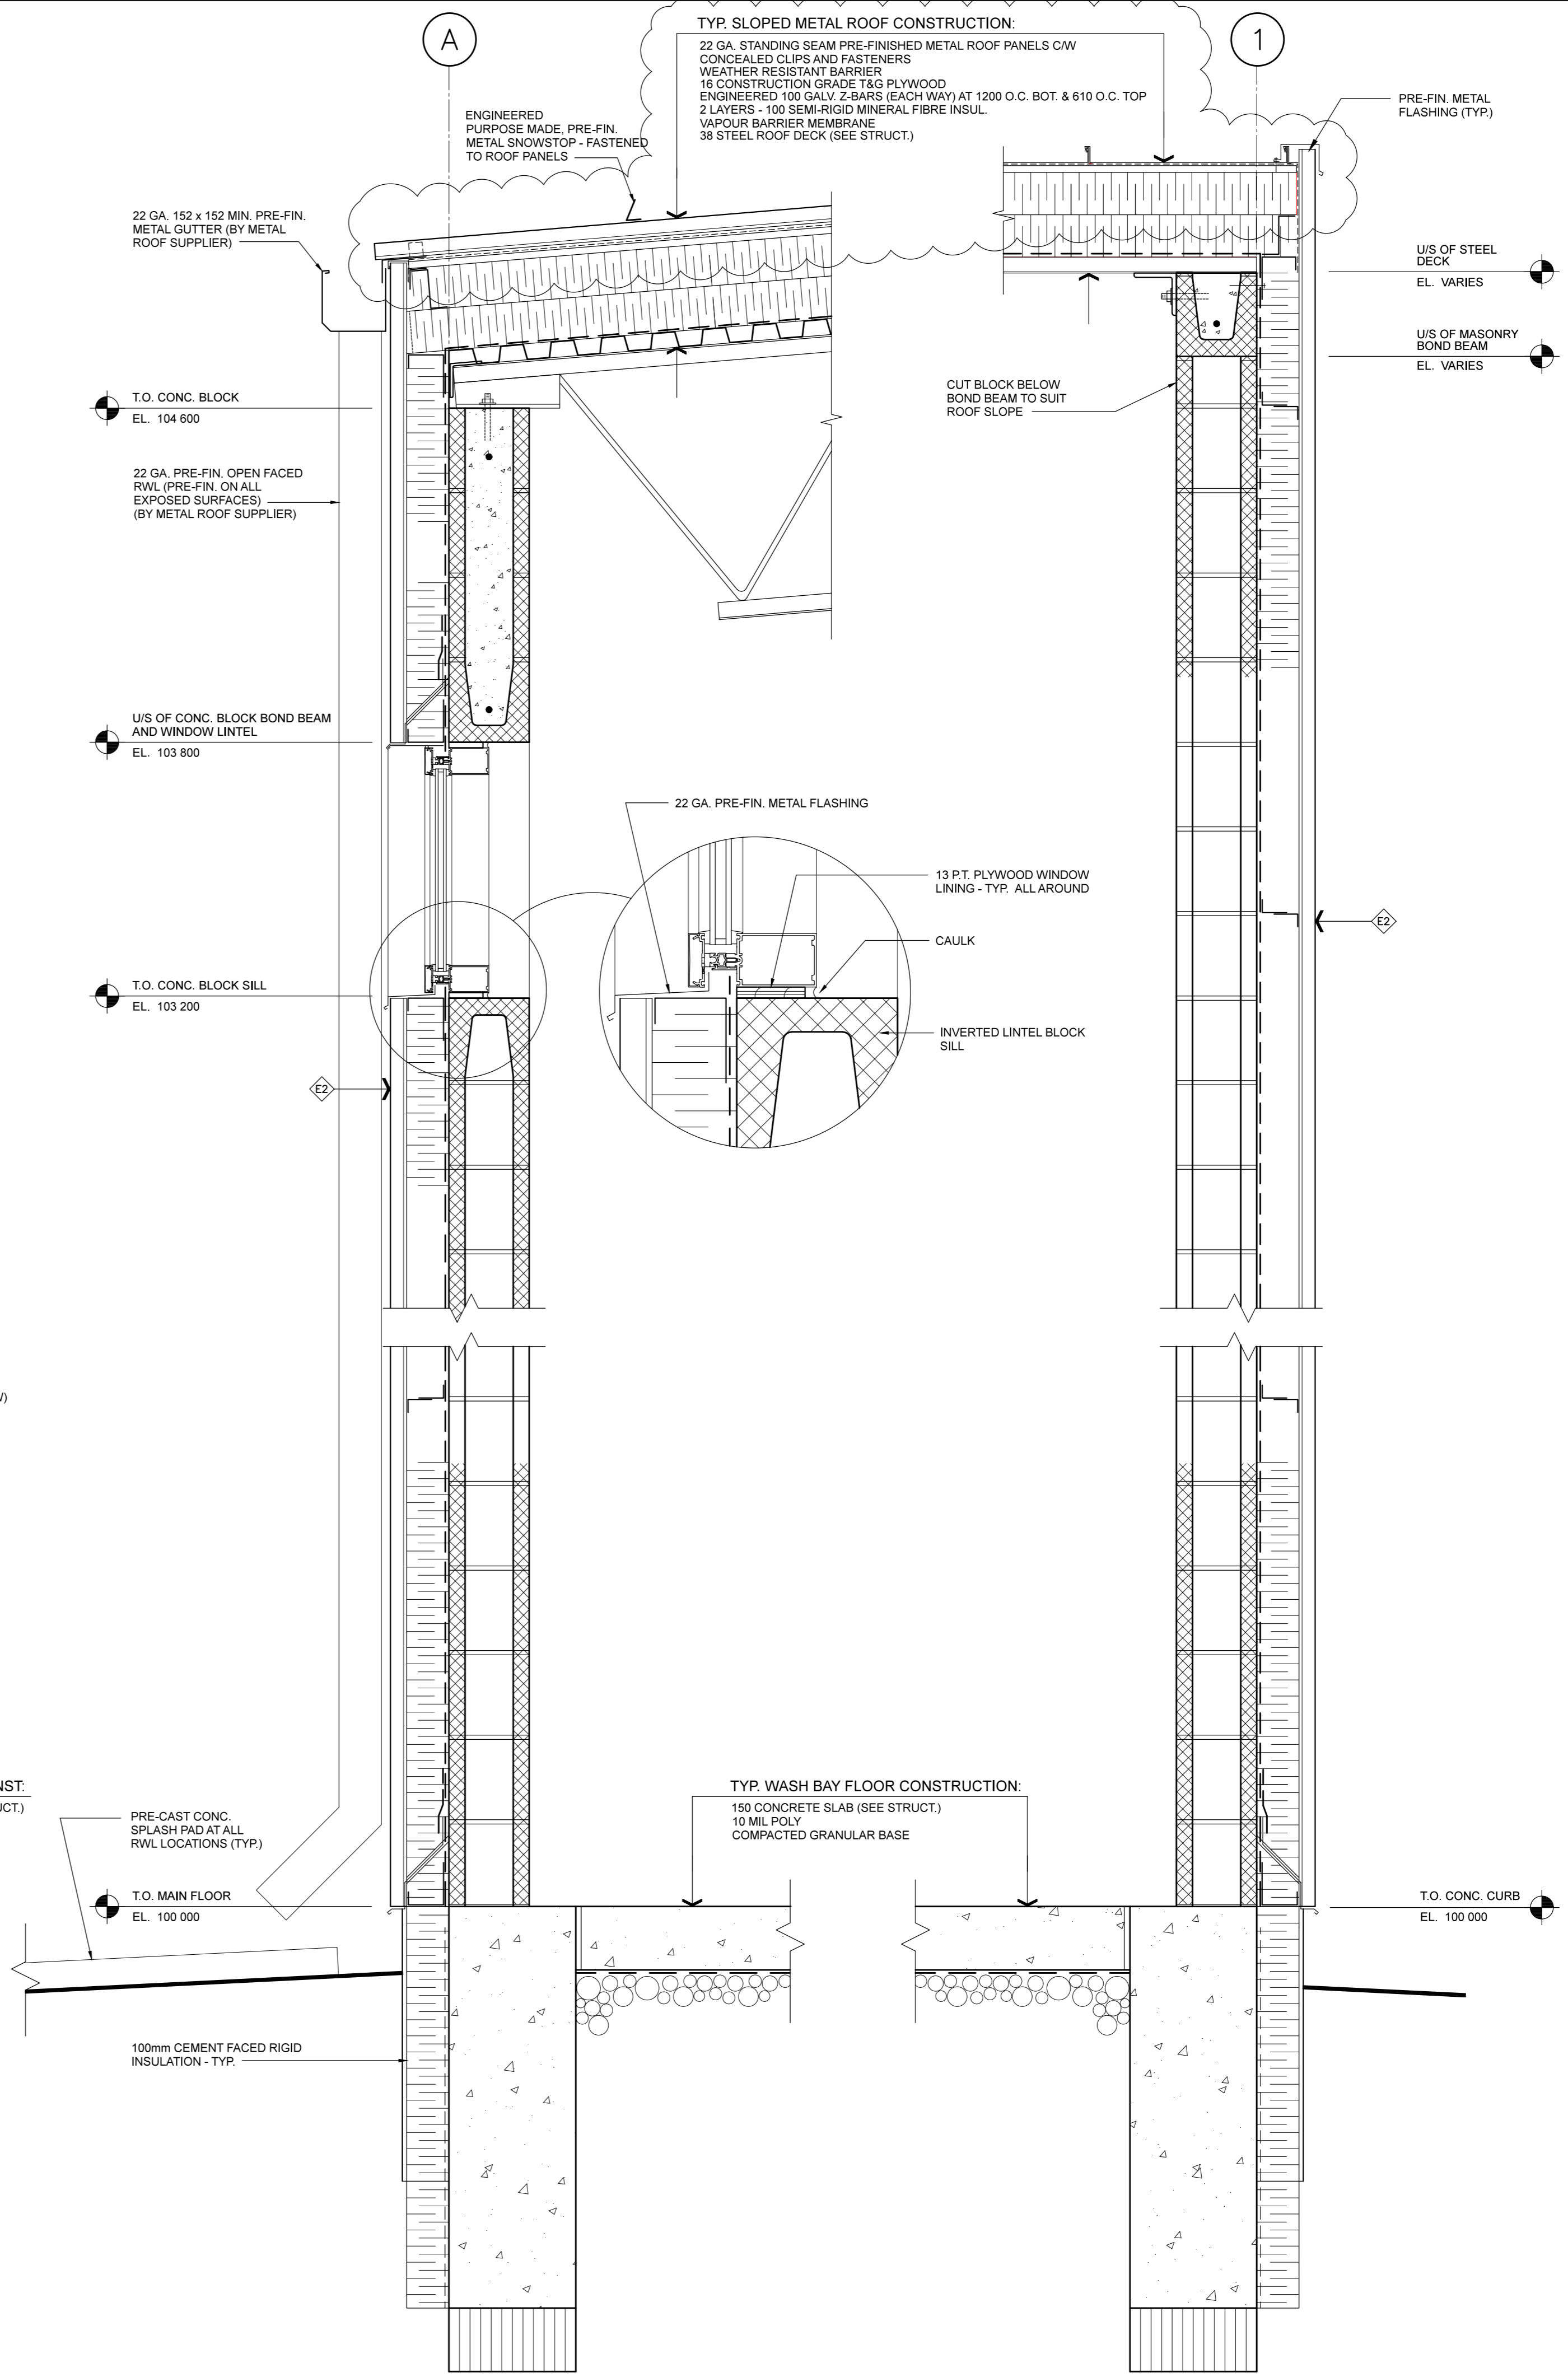

3 WALL SECTION
A5.2 SCALE 1:10

4 WALL SECTION
A5.2 SCALE 1:10

4	YY.MM.DD	-
3	YY.MM.DD	-
2	YY.MM.DD	-
1	17.08.24	ISSUED FOR ADDENDUM 1
0	17.06.30	ISSUED FOR CONSTRUCTION
No.	DATE	REVISION / ISSUANCE

x | architecture inc.
100 Fort Street, Suite 1001 - Winnipeg, Manitoba, R3C 1C7 - 204 318 2010

Project: BID OPPORTUNITY 450 - 2017
KILDONAN PARK
MAINTENANCE BUILDING

Sheet Title: WALL SECTIONS

Project No. 1559
Date: JUNE 30, 2017

A5.2